HOOD FAN ELECTRICAL CORRECTION - REV B

Corrected architecture

The old M105 400 VAC, three-phase, 4 kW branch and K105 contactor are rejected for the photographed hood fan.

Each complete hood is stated by the operator as 220-230 VAC single-phase. The motor-side plate is DC 310 V brushless.

M104A - HOOD 1	230 VAC L-N-PE -> associated/integrated electronics -> Nidec SIC-67FV-F15B-1
M104B - HOOD 2	230 VAC L-N-PE -> associated/integrated electronics -> motor plate to verify

NOT RELEASED FOR CONSTRUCTION - CLOSE THESE HOLD POINTS

- Identify each hood's mains input terminals and associated/integrated controller.
- Confirm protective device rating, conductor size, isolation method and control input voltage.
- Verify the Hood 2 motor nameplate.
- Prove whether %Q4.2 is a common enable and select the required interposing interface.
- Never apply 230 VAC directly to the motor-interface leads.

Source drawing retained except for the redlined hood-fan portions on sheets 15 and 31.

FBS Global

SCHLENKER 36/10
Filling and Capping Line
FBS Global Serial: 130039

ELECTRICAL DRAWINGS

REV	DATE	DWN	CHK	APP	REVISION
E					
D					
C					
B					
A	28/08/26	D.B.	C.W.	C.W.	REVISION ONE, AS BUILT

THIS DRAWING IS OWNED BY FBS SOLUTIONS FOOD AND BEVERAGES AND IS ISSUED ON THE UNDERSTANDING THAT IT MAY NOT BE COPIED OR REPRODUCED IN WHOLE OR IN PART WITHOUT WRITTEN PERMISSION. NOR IS INFORMATION TO BE FURNISHED FROM WHICH COULD BE INJURIOUS TO THE ABOVE COMPANY

SCALE: NOT TO SCALE

	NAME	DATE
DRAWN	D. BORG	28/08/26
DESIGN	D. BORG	28/08/26
CHECKED	C. WHITELEY	28/08/26
APPROVED	C. WHITELEY	28/08/26

PROJECT: SCHLENKER 36/10

Serial No.: FBS Global Serial: 130039

FBS Solutions
45 Pelmet Cres, Thomastown VIC., Australia 3074
FOOD & BEVERAGE
Phone: +61 3 9191 2956
Contact: CLINT WHITELEY
Mobile: +61 418 383 441
E: enquiries@fbsglobal.com.au


DWG. NO.: 8001 A3


REVISION ONE, AS BUILT

SHEET TITLE: COVER

REVISION A

COVER

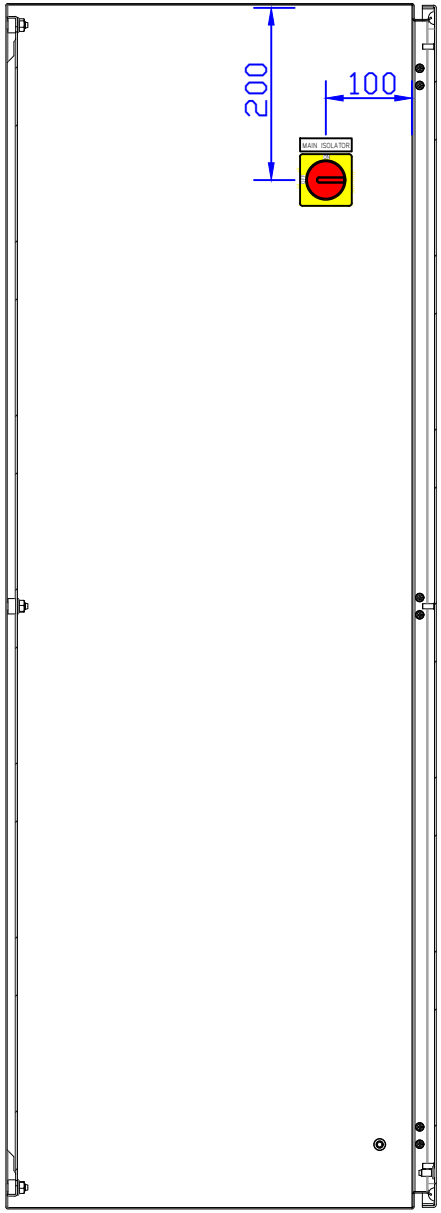

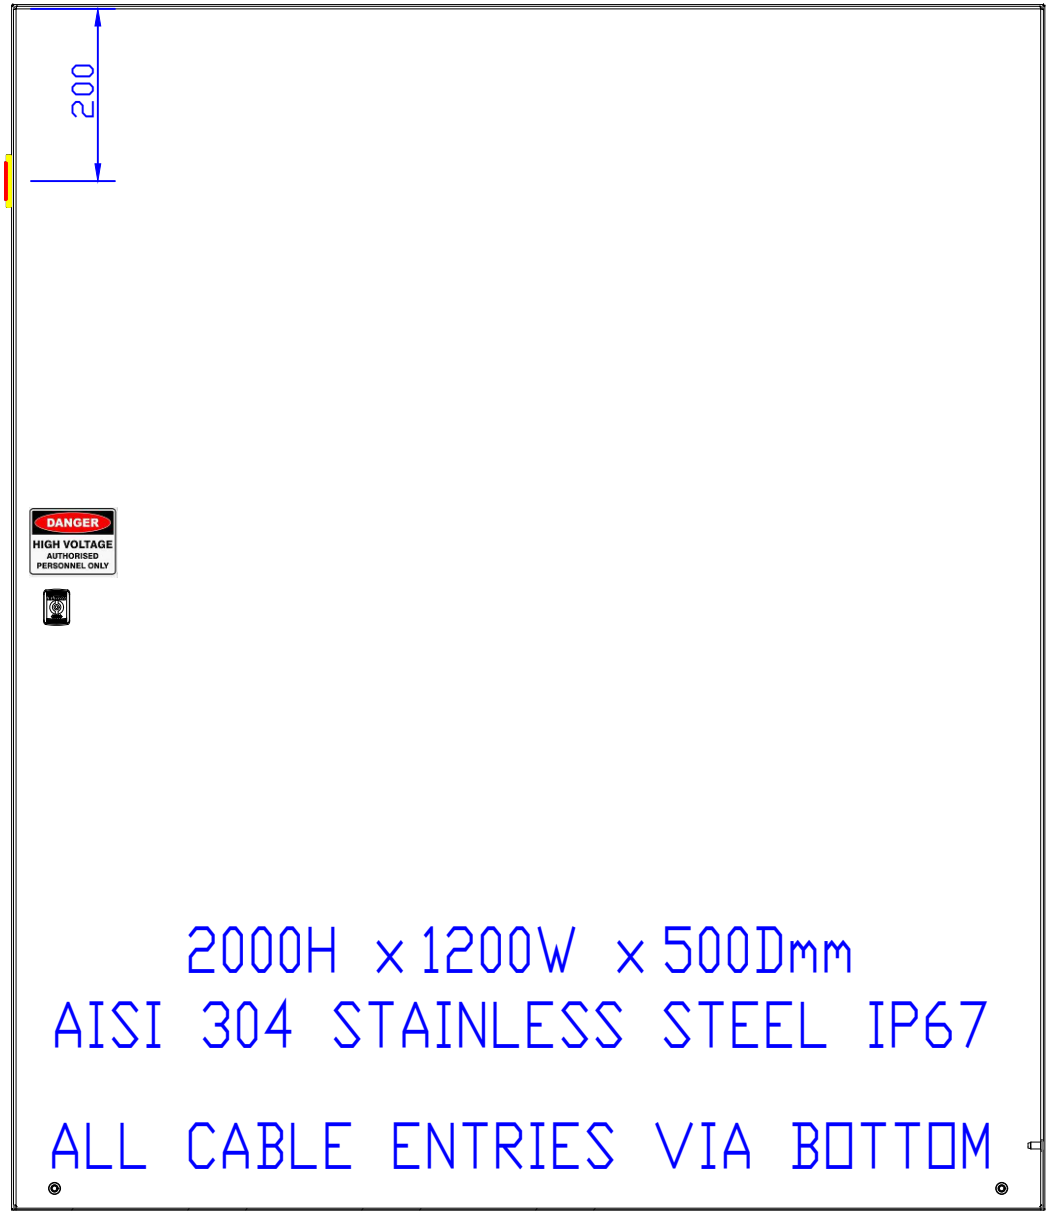

2000H x 1200W x 500Dmm

AISI 304 STAINLESS STEEL IP67

ALL CABLE ENTRIES VIA BOTTOM

REV	DATE	DWN	CHK	APP	REVISION
E					
D					
C					
B					
A	28/08/26	D.B.	C.W.	C.W.	REVISION ONE, AS BUILT

THIS DRAWING IS OWNED BY FBS SOLUTIONS FOOD AND BEVERAGES AND IS ISSUED ON THE UNDERSTANDING THAT IT MAY NOT BE COPIED OR REPRODUCED IN WHOLE OR IN PART WITHOUT WRITTEN PERMISSION. NOR IS INFORMATION TO BE FURNISHED FROM WHICH COULD BE INJURIOUS TO THE ABOVE COMPANY

SCALE: NOT TO SCALE

	NAME	DATE
DRAWN	D. BORG	28/08/26
DESIGN	D. BORG	28/08/26
CHECKED	C. WHITELEY	28/08/26
APPROVED	C. WHITELEY	28/08/26

PROJECT: SCHLENKER 36/10

Serial No.: FBS Global Serial: 130039

FBS Solutions
45 Pelmet Cres, Thomastown VIC., Australia 3074
FOOD & BEVERAGE
Phone: +61 3 9191 2956
Contact: CLINT WHITELEY
Mobile: +61 418 383 441
E: enquiries@fbsglobal.com.au


DWG. NO.: 8001 A3

REVISION ONE, AS BUILT

SHEET TITLE: MAIN CONTROL PANEL

REVISION A

SHEET 1

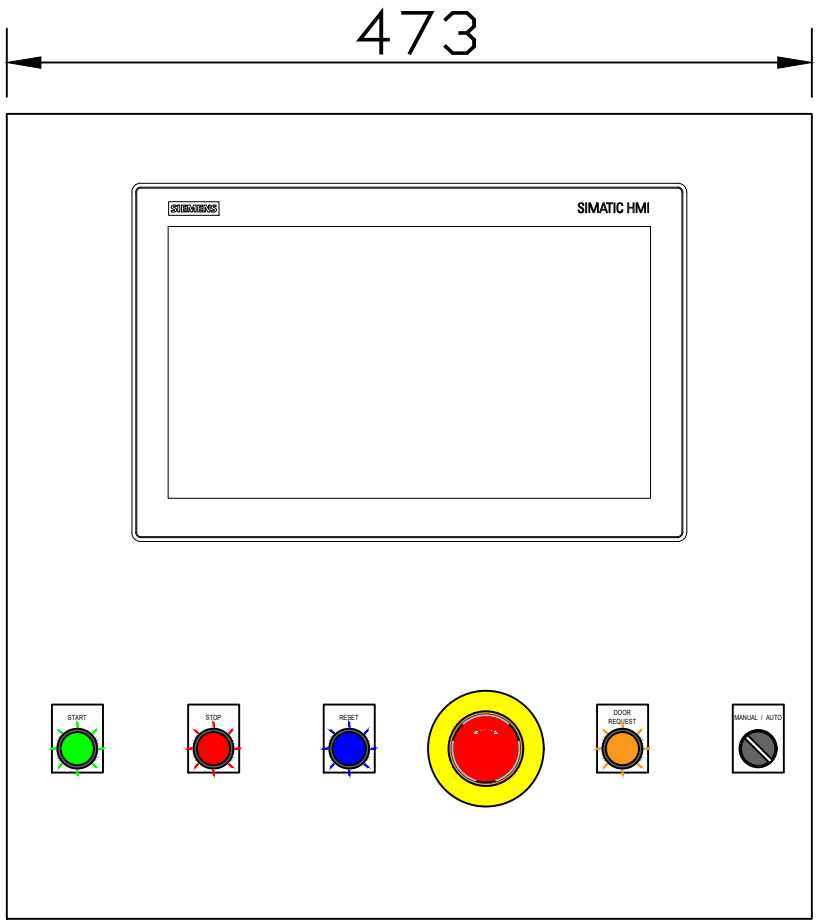



HAND HELD
MANUAL JOG PENDANT

REV	DATE	DWN	CHK	APP	REVISION
E					
D					
C					
B					
A	28/08/26	D.B.	C.W.	C.W.	REVISION ONE, AS BUILT

THIS DRAWING IS OWNED BY FBS SOLUTIONS FOOD AND BEVERAGES AND IS ISSUED ON THE UNDERSTANDING THAT IT MAY NOT BE COPIED OR REPRODUCED IN WHOLE OR IN PART WITHOUT WRITTEN PERMISSION. NOR IS INFORMATION TO BE FURNISHED FROM WHICH COULD BE INJURIOUS TO THE ABOVE COMPANY

SCALE: NOT TO SCALE

	NAME	DATE
DRAWN	D. BORG	28/08/26
DESIGN	D. BORG	28/08/26
CHECKED	C. WHITELEY	28/08/26
APPROVED	C. WHITELEY	28/08/26

PROJECT: SCHLENKER 36/10

Serial No.: FBS Global Serial: 130039

FBS Solutions
45 Pelmet Cres, Thomastown VIC., Australia 3074
FOOD & BEVERAGE
Phone: +61 3 9191 2956
Contact: CLINT WHITELEY
Mobile: +61 418 383 441
E: enquiries@fbsglobal.com.au


DWG. NO.: 8001 A3


REVISION ONE, AS BUILT

SHEET TITLE: OPERATOR CONSOLE

REVISION A

SHEET 2

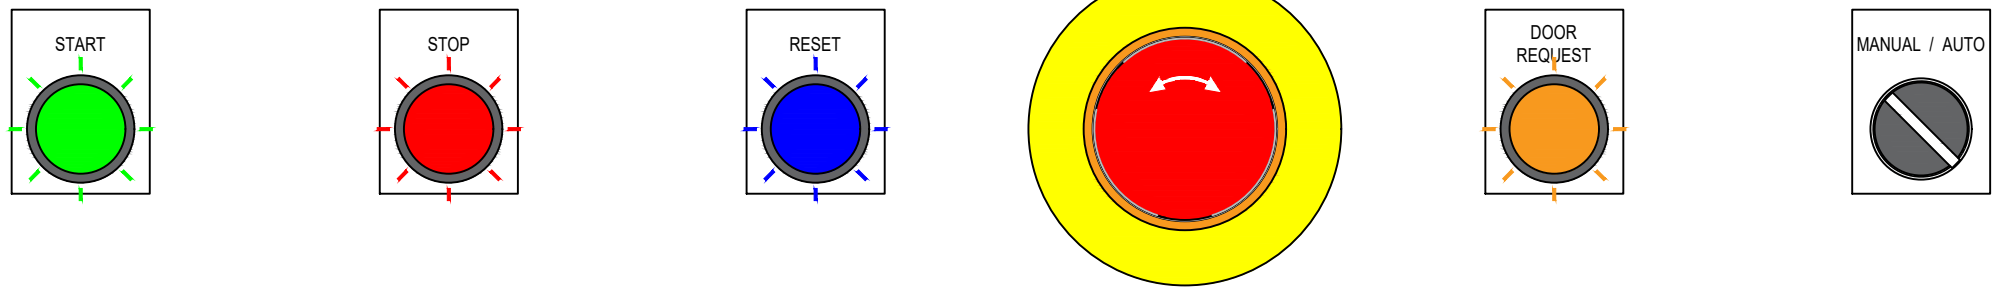
START
STOP
RESET
DOOR
REQUEST
MANUAL / AUTO

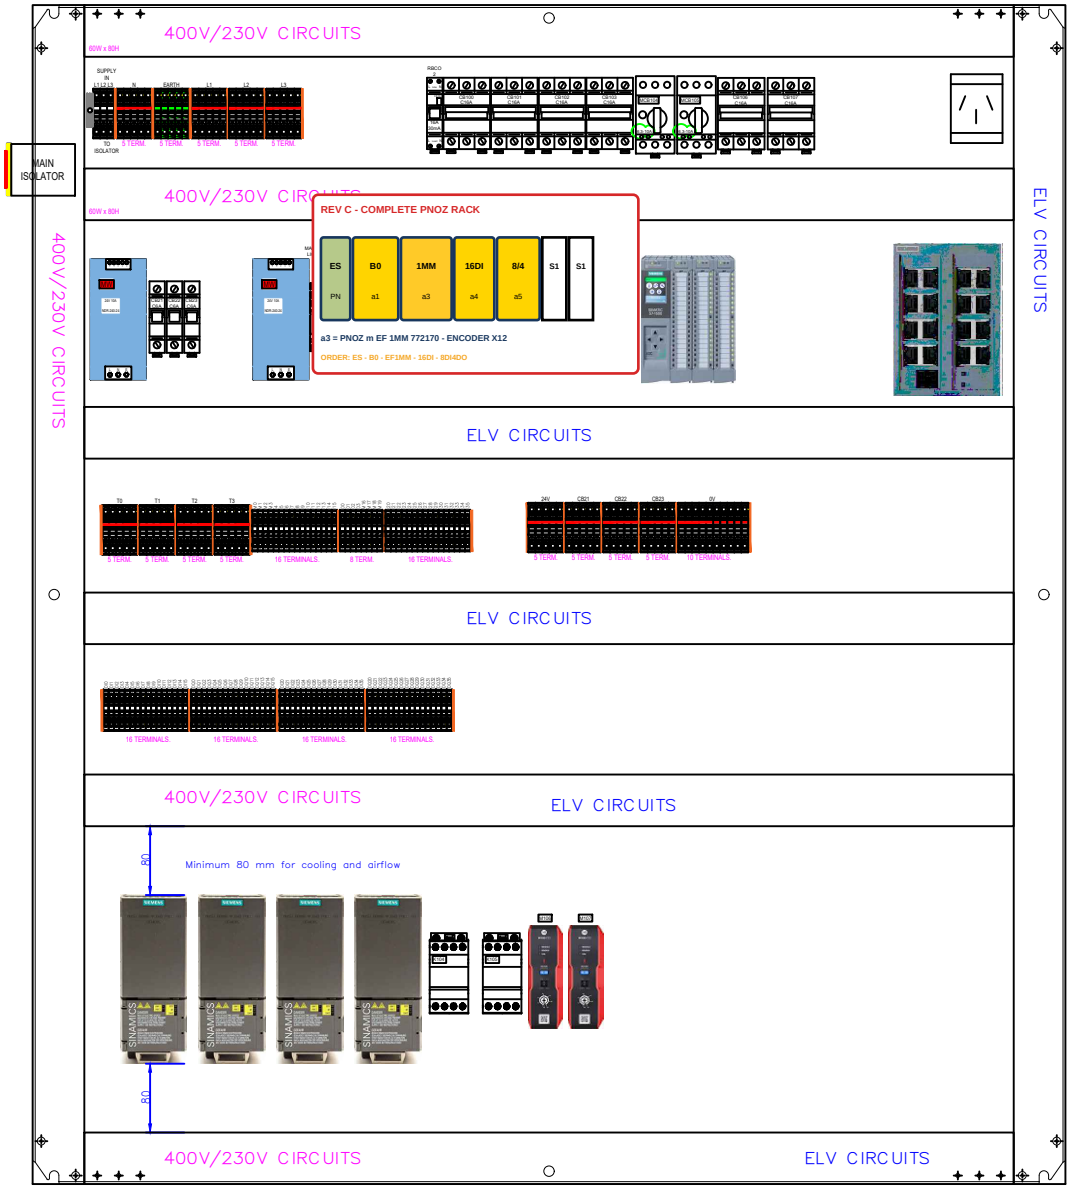

REV	DATE	DWN	CHK	APP	REVISION
E					
D					
C					
B					
A	28/08/26	D.B.	C.W.	C.W.	REVISION ONE, AS BUILT

THIS DRAWING IS OWNED BY FBS SOLUTIONS FOOD AND BEVERAGES AND IS ISSUED ON THE UNDERSTANDING THAT IT MAY NOT BE COPIED OR REPRODUCED IN WHOLE OR IN PART WITHOUT WRITTEN PERMISSION. NOR IS INFORMATION TO BE FURNISHED FROM WHICH COULD BE INJURIOUS TO THE ABOVE COMPANY

SCALE: NOT TO SCALE

	NAME	DATE
DRAWN	D. BORG	28/08/26
DESIGN	D. BORG	28/08/26
CHECKED	C. WHITELEY	28/08/26
APPROVED	C. WHITELEY	28/08/26

PROJECT: SCHLENKER 36/10

Serial No.: FBS Global Serial: 130039

FBS Solutions
45 Pelmet Cres, Thomastown VIC., Australia 3074
FOOD & BEVERAGE
Phone: +61 3 9191 2956
Contact: CLINT WHITELEY
Mobile: +61 418 383 441
E: enquiries@fbsglobal.com.au

DWG. NO.: 8001 A3


REVISION ONE, AS BUILT


SHEET TITLE: MAIN CONTROL PANEL GEARTRAY


REVISION A

SHEET 3

60W x 80H

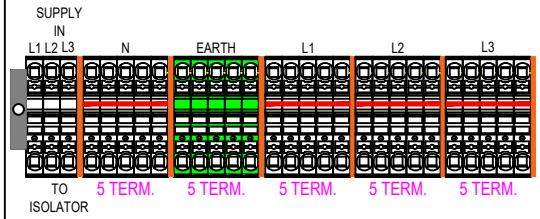


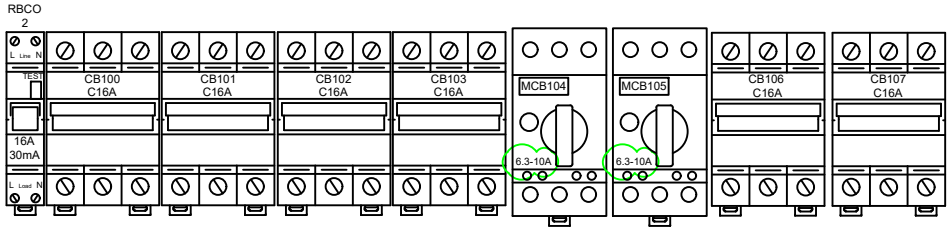


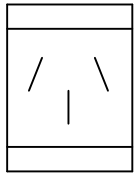


400V/230V CIRCUITS


60W x 80H

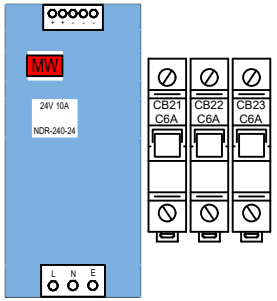

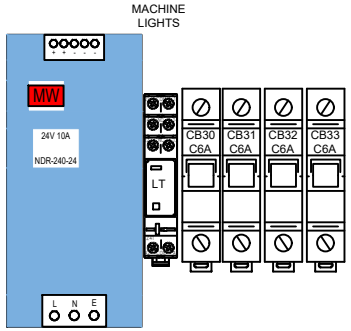


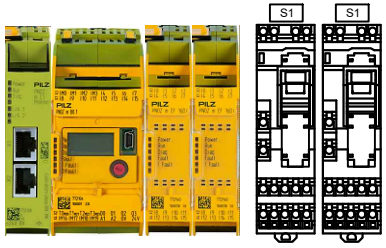




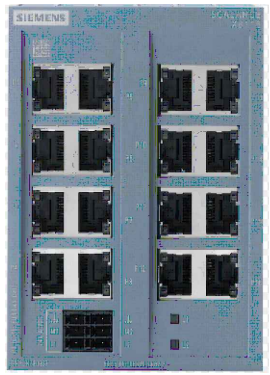


ELV CIRCUITS

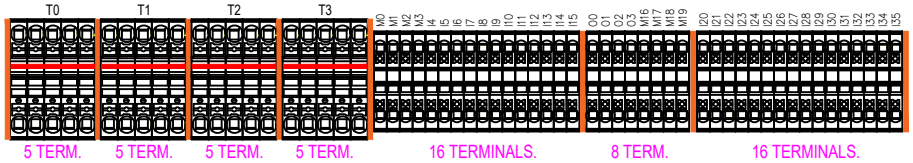

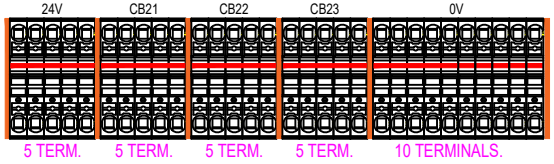

400VAC 50Hz 3 PHASE SUPPLY

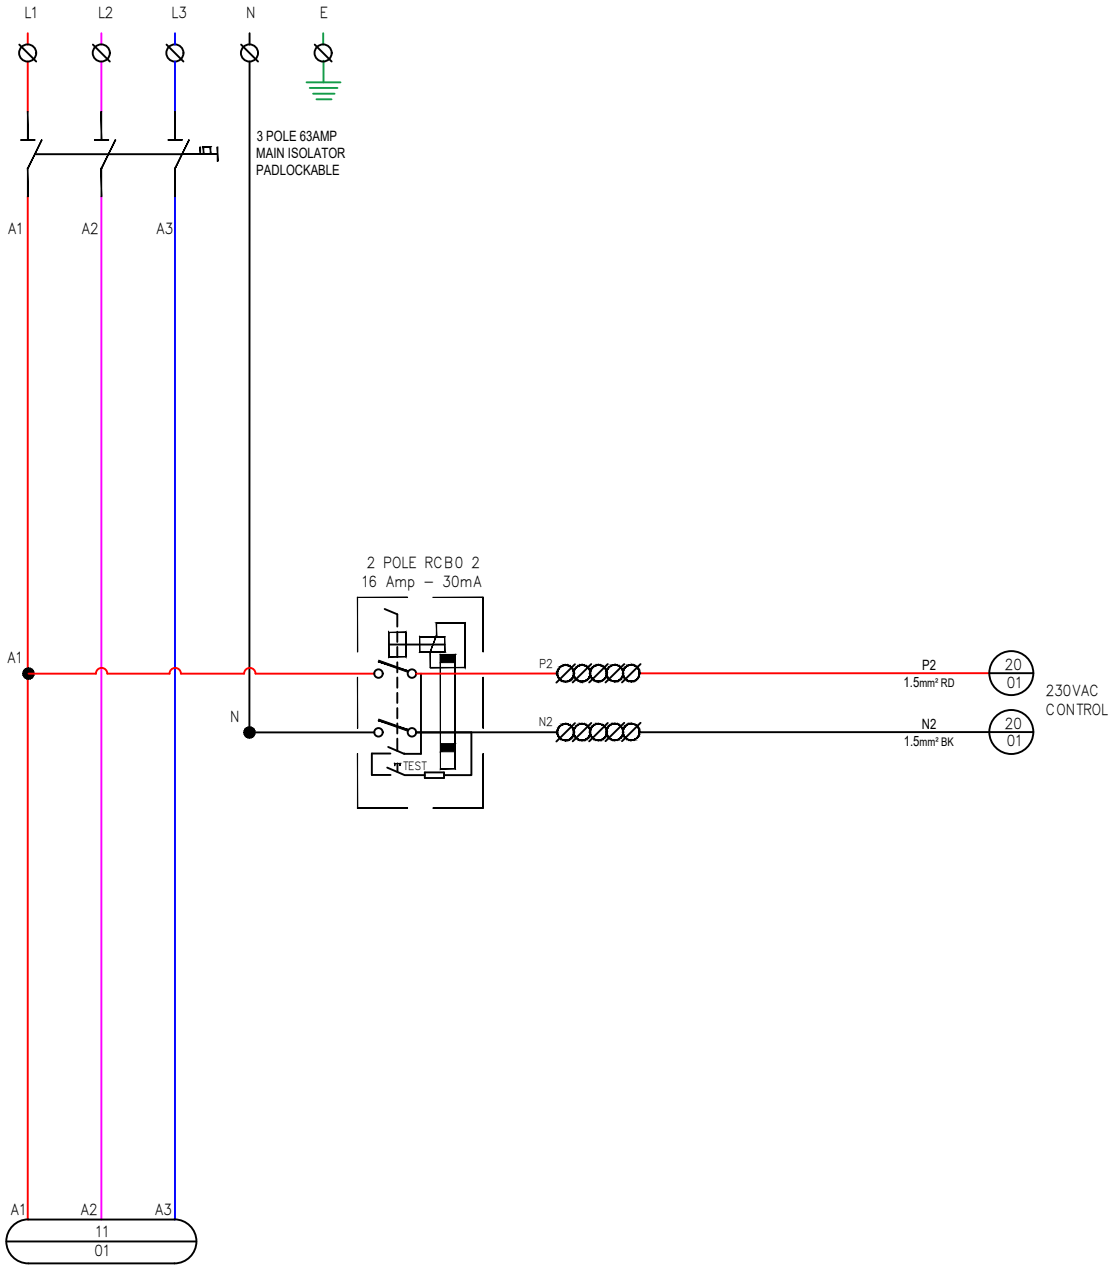

RED, WHITE, BLUE – ACTIVES
BLACK – NEUTRAL
GREEN / YELLOW TRACE – EARTH
PURPLE – 24VDC POSITIVE
GREY – 0VDC NEGATIVE
ORANGE – 24VDC INTERFACE

REV	DATE	DWN	CHK	APP	REVISION
E					
D					
C					
B					
A	28/08/26	D.B.	C.W.	C.W.	REVISION ONE, AS BUILT

THIS DRAWING IS OWNED BY FBS SOLUTIONS FOOD AND BEVERAGES AND IS ISSUED ON THE UNDERSTANDING THAT IT MAY NOT BE COPIED OR REPRODUCED IN WHOLE OR IN PART WITHOUT WRITTEN PERMISSION. NOR IS INFORMATION TO BE FURNISHED FROM WHICH COULD BE INJURIOUS TO THE ABOVE COMPANY

SCALE: NOT TO SCALE

	NAME	DATE
DRAWN	D. BORG	28/08/26
DESIGN	D. BORG	28/08/26
CHECKED	C. WHITELEY	28/08/26
APPROVED	C. WHITELEY	28/08/26

PROJECT: SCHLENKER 36/10

Serial No.: FBS Global Serial: 130039

FBS Solutions
45 Pelmet Cres, Thomastown VIC., Australia 3074
FOOD & BEVERAGE
Phone: +61 3 9191 2956
Contact: CLINT WHITELEY
Mobile: +61 418 383 441
E: enquiries@fbsglobal.com.au


DWG. NO.: 8001 A3

REVISION ONE, AS BUILT

SHEET TITLE: POWER DISTRIBUTION

REVISION A

SHEET 10

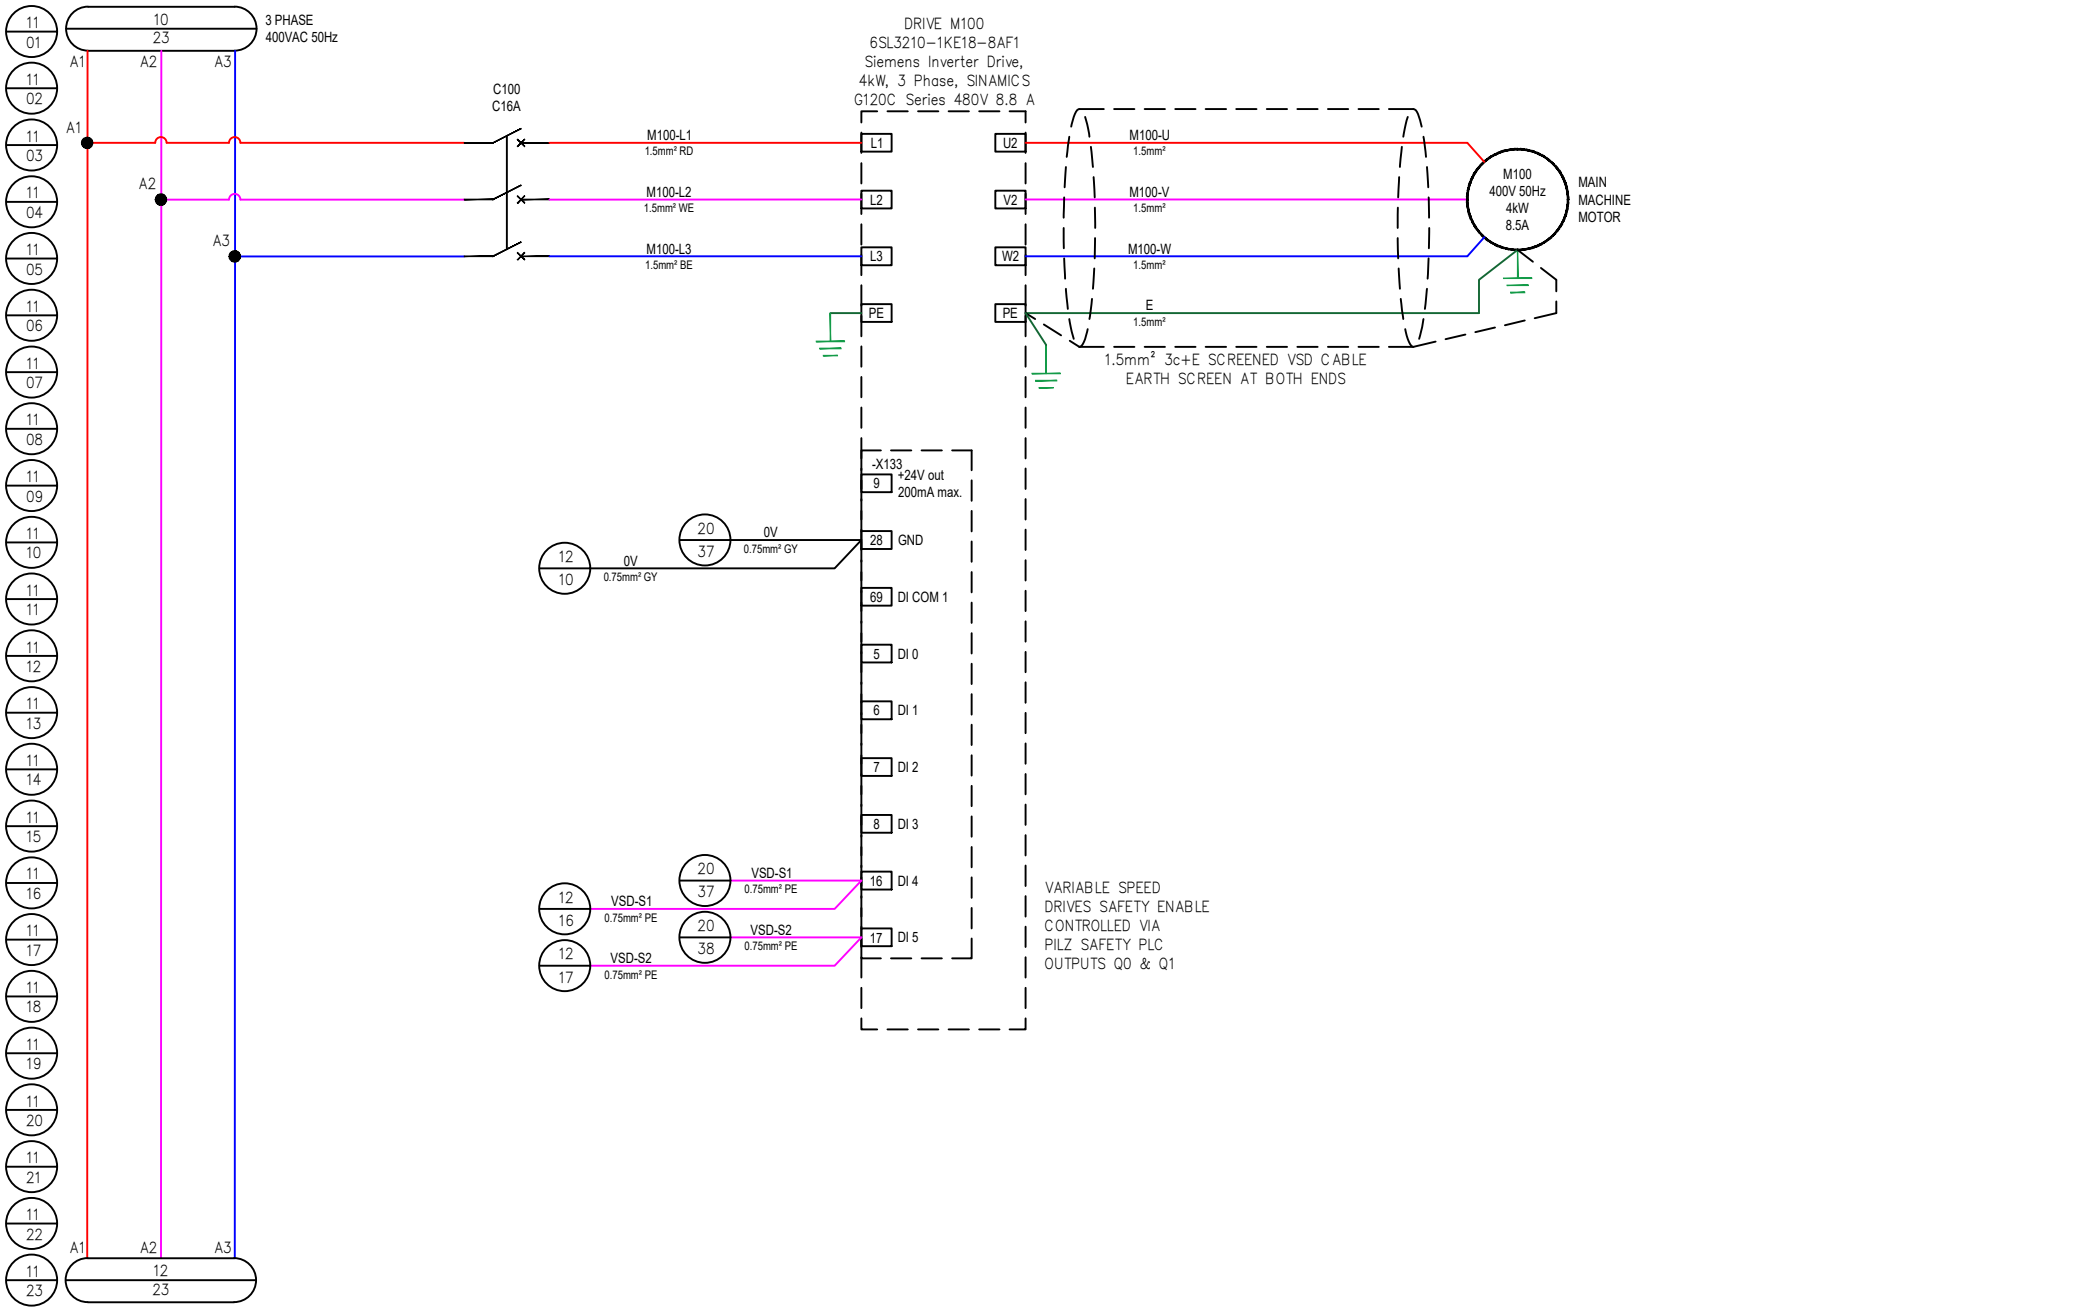

REV	DATE	DWN	CHK	APP	REVISION
E					
D					
C					
B					
A	28/08/26	D.B.	C.W.	C.W.	REVISION ONE, AS BUILT

THIS DRAWING IS OWNED BY FBS SOLUTIONS FOOD AND BEVERAGES AND IS ISSUED ON THE UNDERSTANDING THAT IT MAY NOT BE COPIED OR REPRODUCED IN WHOLE OR IN PART WITHOUT WRITTEN PERMISSION. NOR IS INFORMATION TO BE FURNISHED FROM WHICH COULD BE INJURIOUS TO THE ABOVE COMPANY

SCALE: NOT TO SCALE

	NAME	DATE
DRAWN	D. BORG	28/08/26
DESIGN	D. BORG	28/08/26
CHECKED	C. WHITELEY	28/08/26
APPROVED	C. WHITELEY	28/08/26

PROJECT: SCHLENKER 36/10

Serial No.: FBS Global Serial: 130039

FBS Solutions
45 Pelmet Cres, Thomastown VIC., Australia 3074
FOOD & BEVERAGE
Phone: +61 3 9191 2956
Contact: CLINT WHITELEY
Mobile: +61 418 383 441
E: enquiries@fbsglobal.com.au


DWG. NO.: 8001 A3

REVISION ONE, AS BUILT

SHEET TITLE: DRIVES

REVISION A

SHEET 11

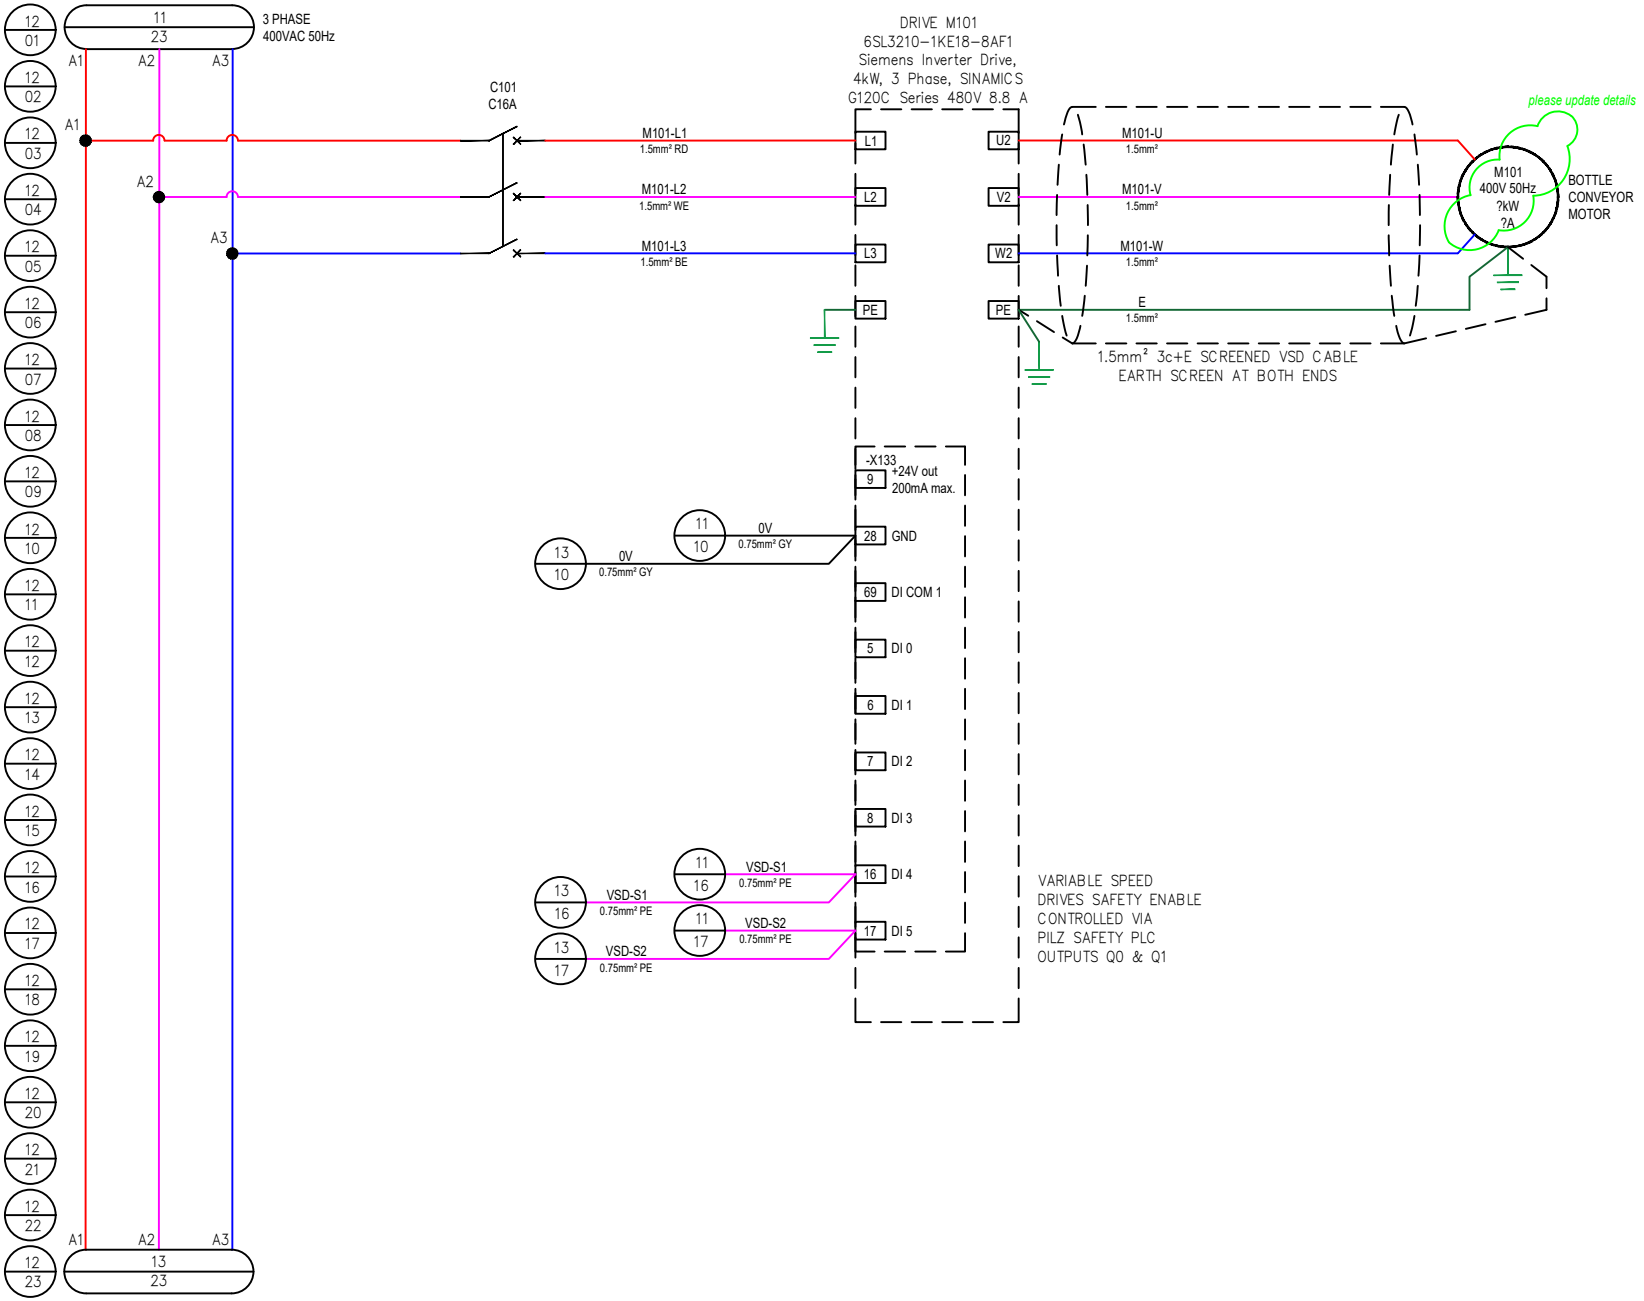

REV	DATE	DWN	CHK	APP	REVISION
E					
D					
C					
B					
A	28/08/26	D.B.	C.W.	C.W.	REVISION ONE, AS BUILT

THIS DRAWING IS OWNED BY FBS SOLUTIONS FOOD AND BEVERAGES AND IS ISSUED ON THE UNDERSTANDING THAT IT MAY NOT BE COPIED OR REPRODUCED IN WHOLE OR IN PART WITHOUT WRITTEN PERMISSION. NOR IS INFORMATION TO BE FURNISHED FROM WHICH COULD BE INJURIOUS TO THE ABOVE COMPANY

SCALE: NOT TO SCALE

	NAME	DATE
DRAWN	D. BORG	28/08/26
DESIGN	D. BORG	28/08/26
CHECKED	C. WHITELEY	28/08/26
APPROVED	C. WHITELEY	28/08/26

PROJECT: SCHLENKER 36/10

Serial No.: FBS Global Serial: 130039

FBS Solutions
45 Pelmet Cres, Thomastown VIC., Australia 3074
FBS FOOD & BEVERAGE
Phone: +61 3 9191 2956
Contact: CLINT WHITELEY
Mobile: +61 418 383 441
E: enquiries@fbsglobal.com.au


DWG. NO.: 8001 A3

REVISION ONE, AS BUILT

SHEET TITLE: DRIVES

REVISION: A

SHEET 12

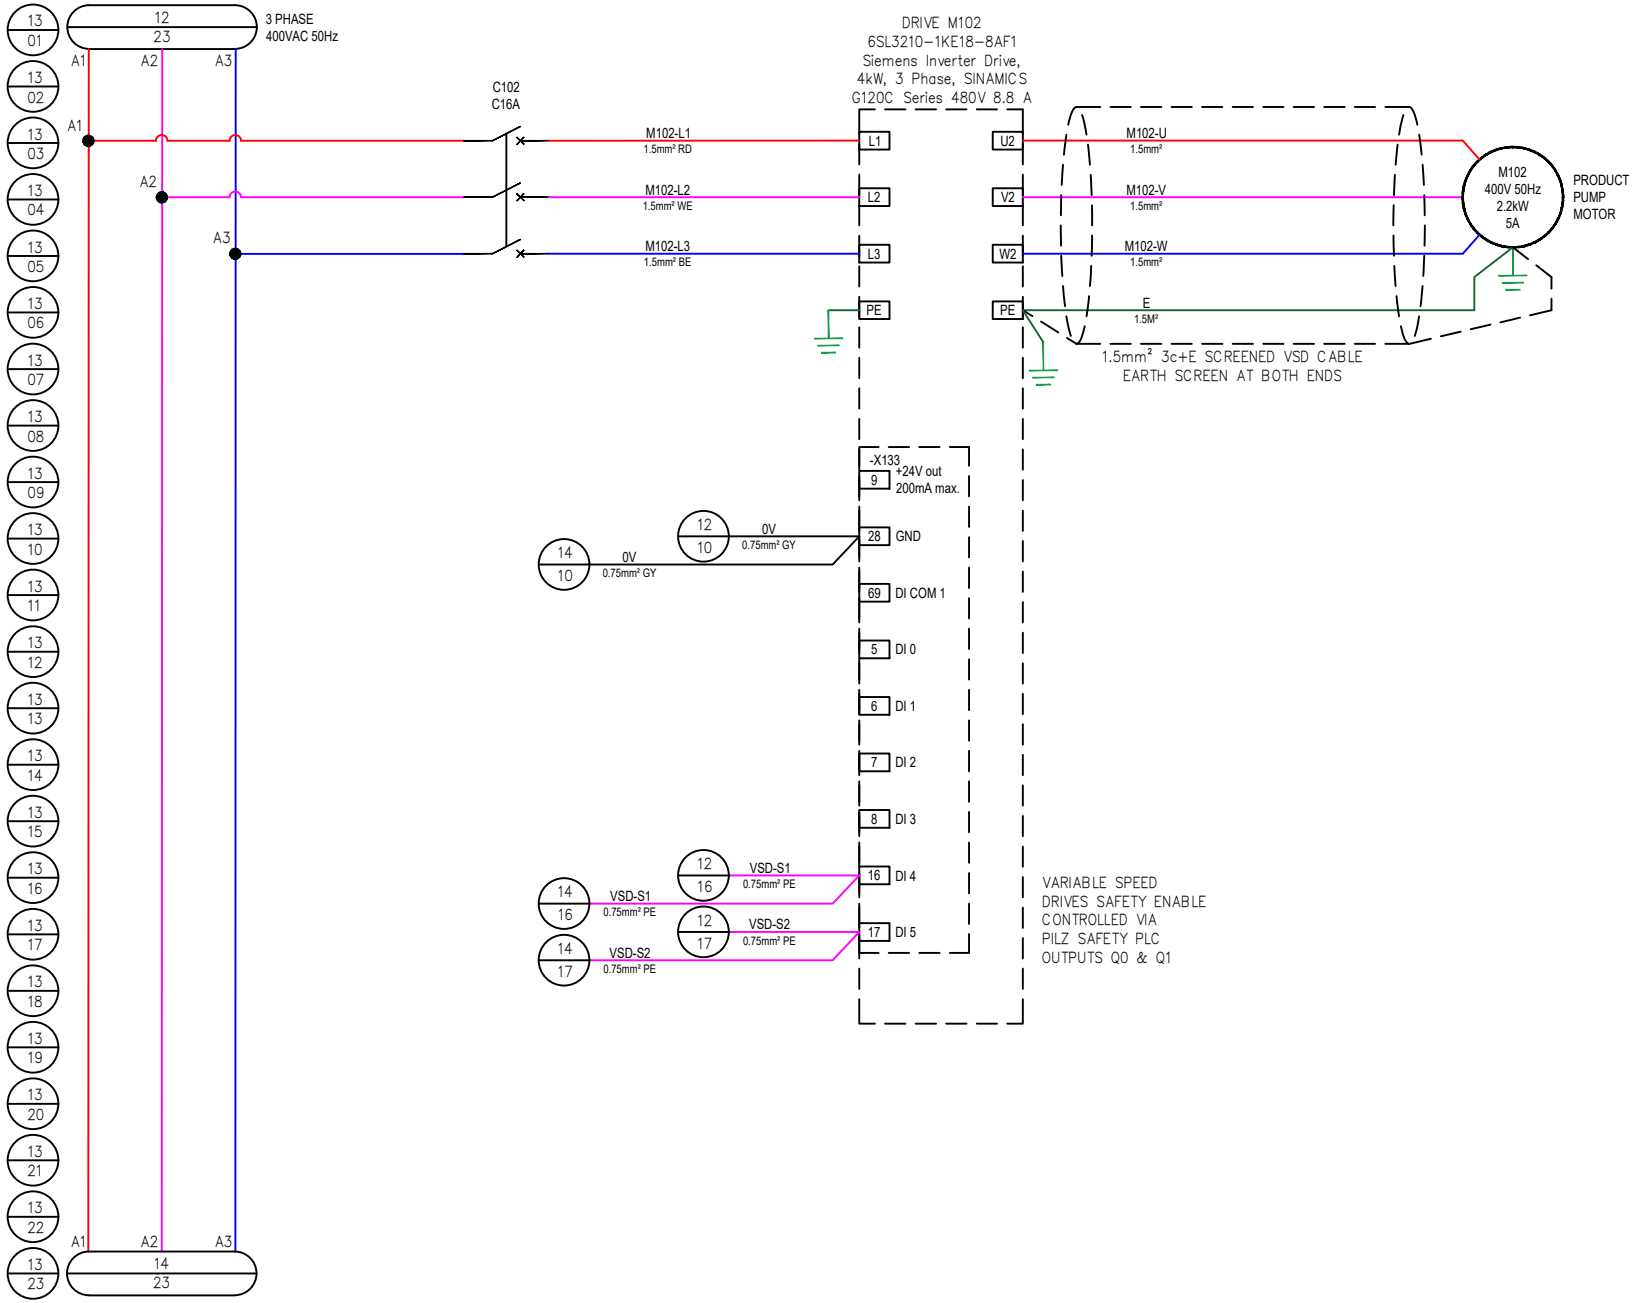

REV	DATE	DWN	CHK	APP	REVISION
E					
D					
C					
B					
A	28/08/26	D.B.	C.W.	C.W.	REVISION ONE, AS BUILT

THIS DRAWING IS OWNED BY FBS SOLUTIONS FOOD AND BEVERAGES AND IS ISSUED ON THE UNDERSTANDING THAT IT MAY NOT BE COPIED OR REPRODUCED IN WHOLE OR IN PART WITHOUT WRITTEN PERMISSION. NOR IS INFORMATION TO BE FURNISHED FROM WHICH COULD BE INJURIOUS TO THE ABOVE COMPANY

SCALE: NOT TO SCALE

	NAME	DATE
DRAWN	D. BORG	28/08/26
DESIGN	D. BORG	28/08/26
CHECKED	C. WHITELEY	28/08/26
APPROVED	C. WHITELEY	28/08/26

PROJECT: SCHLENKER 36/10

Serial No.: FBS Global Serial: 130039

FBS Solutions
45 Pelmet Cres, Thomastown VIC., Australia 3074
FOOD & BEVERAGE
Phone: +61 3 9191 2956
Contact: CLINT WHITELEY
Mobile: +61 418 383 441
E: enquiries@fbsglobal.com.au


DWG. NO.: 8001 A3

REVISION ONE, AS BUILT

SHEET TITLE: DRIVES

REVISION A

SHEET 13

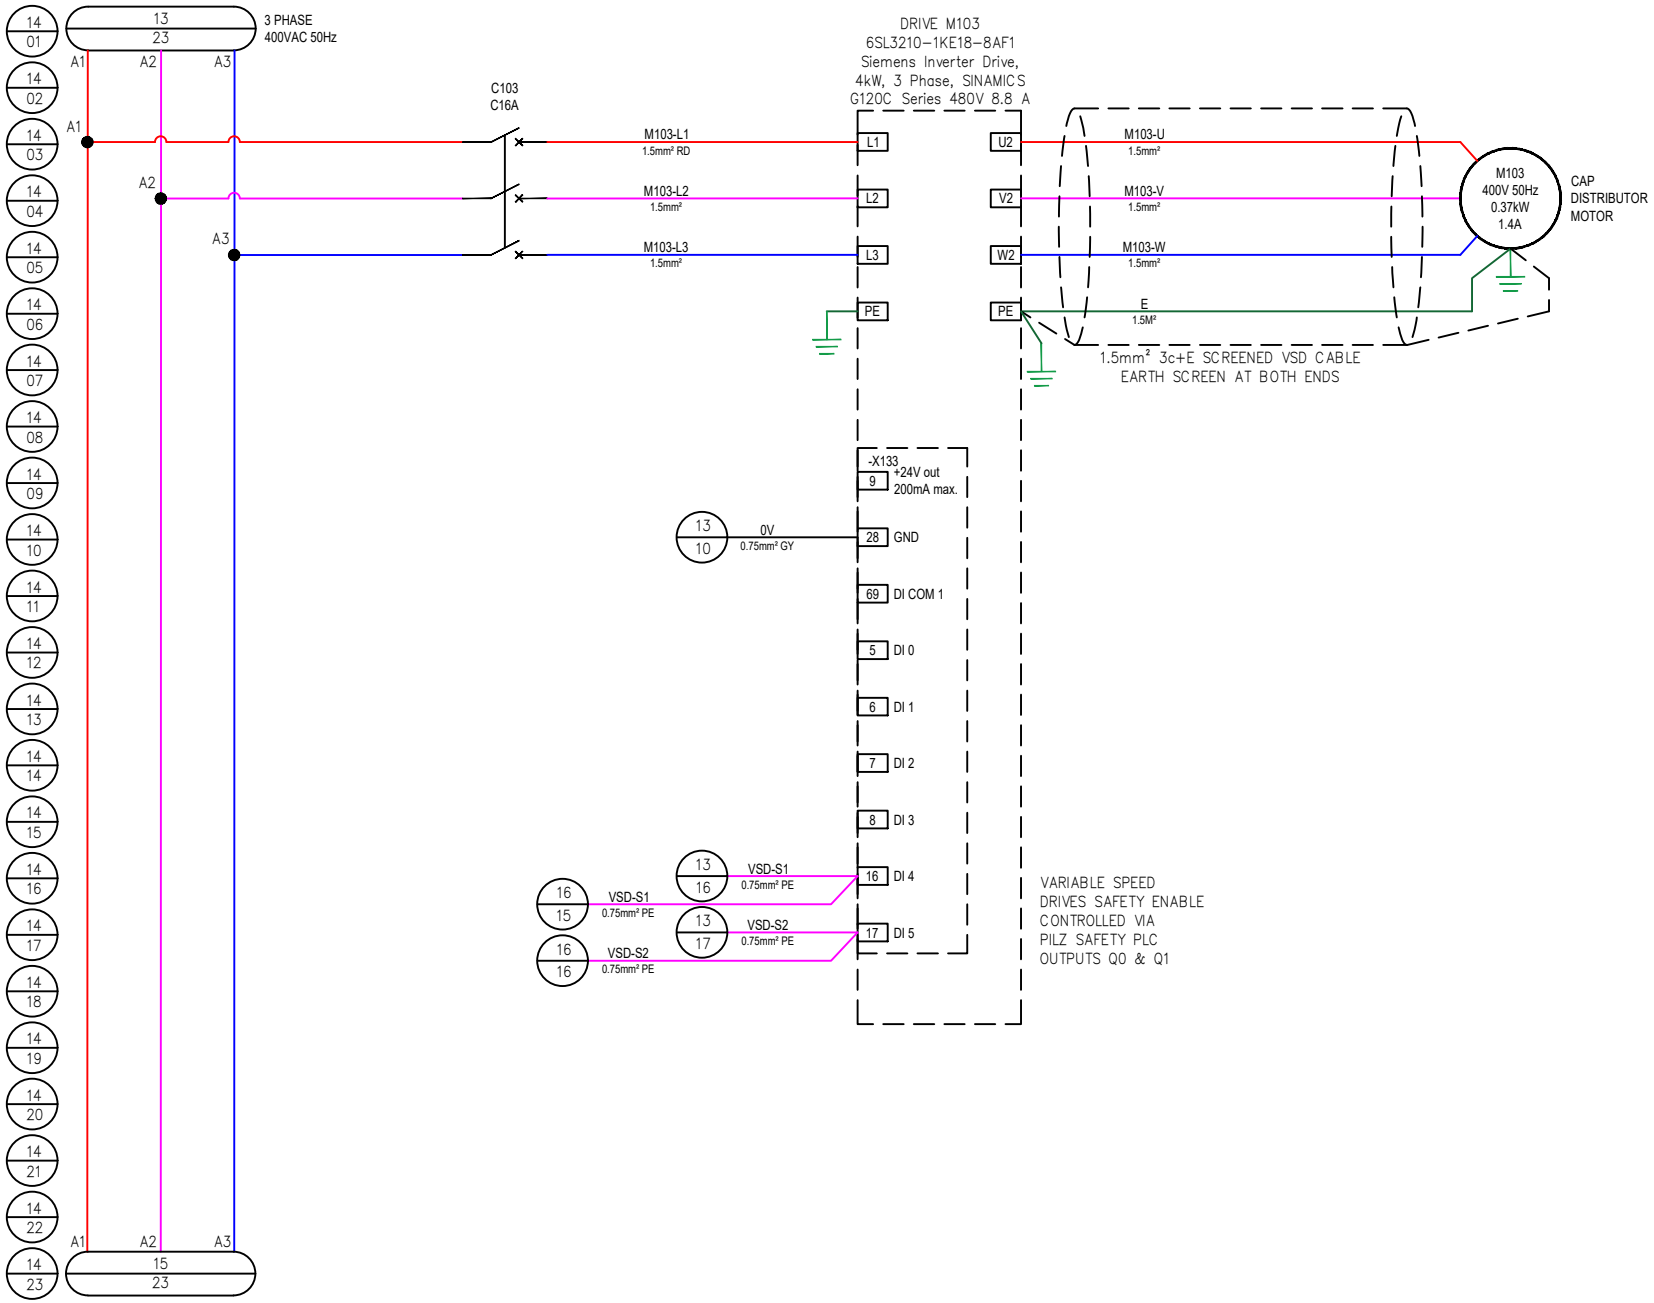

REV	DATE	DWN	CHK	APP	REVISION
E					
D					
C					
B					
A	28/08/26	D.B.	C.W.	C.W.	REVISION ONE, AS BUILT

THIS DRAWING IS OWNED BY FBS SOLUTIONS FOOD AND BEVERAGES AND IS ISSUED ON THE UNDERSTANDING THAT IT MAY NOT BE COPIED OR REPRODUCED IN WHOLE OR IN PART WITHOUT WRITTEN PERMISSION. NOR IS INFORMATION TO BE FURNISHED FROM WHICH COULD BE INJURIOUS TO THE ABOVE COMPANY

SCALE: NOT TO SCALE

	NAME	DATE
DRAWN	D. BORG	28/08/26
DESIGN	D. BORG	28/08/26
CHECKED	C. WHITELEY	28/08/26
APPROVED	C. WHITELEY	28/08/26

PROJECT: SCHLENKER 36/10

Serial No.: FBS Global Serial: 130039

FBS Solutions
45 Pelmet Cres, Thomastown VIC., Australia 3074
FOOD & BEVERAGE
Phone: +61 3 9191 2956
Contact: CLINT WHITELEY
Mobile: +61 418 383 441
E: enquiries@fbsglobal.com.au


DWG. NO.: 8001 A3

REVISION ONE, AS BUILT

SHEET TITLE: DRIVES

REVISION: A

SHEET 14

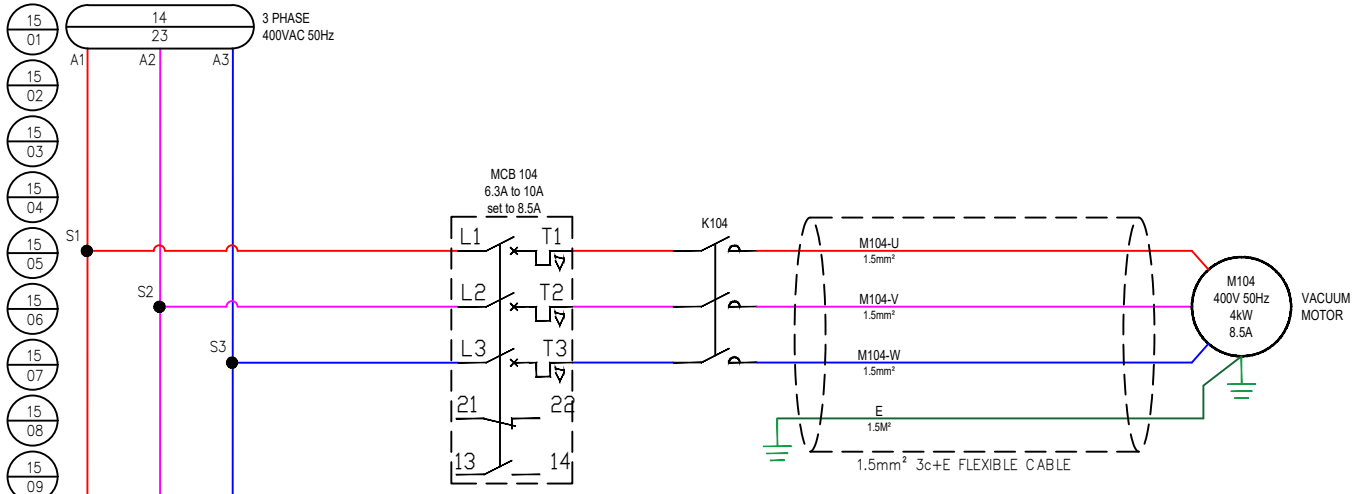


TWO COMPLETE HOOD ASSEMBLIES - 230 VAC SINGLE PHASE

L
N
PE

M104A - HOOD 1

Complete hood input: L + N + PE

Associated/integrated brushless electronics

Motor: Nidec SIC-67FV-F15B-1

DC 310 V motor bus | 58 W | 8P | 1350 rpm

M104B - HOOD 2

Complete hood input: L + N + PE

Associated/integrated brushless electronics

Motor plate: VERIFY ON INSTALLED HOOD

Same 230 VAC assembly architecture stated by operator

DO NOT CONNECT MOTOR LEADS DIRECTLY TO MAINS, VFD, CONTACTOR OUTPUT OR PLC 24 VDC.

Protection rating, assembly terminals, controller/control interface and Hood 2 nameplate: VERIFY BEFORE CONSTRUCTION.

REV	DATE	DWN	CHK	APP	REVISION
E					
D					
C					
B					
A	28/08/26	D.B.	C.W.	C.W.	REVISION ONE, AS BUILT

THIS DRAWING IS OWNED BY FBS SOLUTIONS FOOD AND BEVERAGES AND IS ISSUED ON THE UNDERSTANDING THAT IT MAY NOT BE COPIED OR REPRODUCED IN WHOLE OR IN PART WITHOUT WRITTEN PERMISSION. NOR IS INFORMATION TO BE FURNISHED FROM WHICH COULD BE INJURIOUS TO THE ABOVE COMPANY

SCALE: NOT TO SCALE

	NAME	DATE
DRAWN	D. BORG	28/08/26
DESIGN	D. BORG	28/08/26
CHECKED	C. WHITELEY	28/08/26
APPROVED	C. WHITELEY	28/08/26

PROJECT: SCHLENKER 36/10

Serial No.: FBS Global Serial: 130039

FBS Solutions
45 Pelmet Cres, Thomastown VIC., Australia 3074
FOOD & BEVERAGE
Phone: +61 3 9191 2956
Contact: CLINT WHITELEY
Mobile: +61 418 383 441
E: enquiries@fbsglobal.com.au


DWG. NO.: 8001 A3

REVISION ONE, AS BUILT

SHEET TITLE: MOTORS

REVISION A

SHEET 15

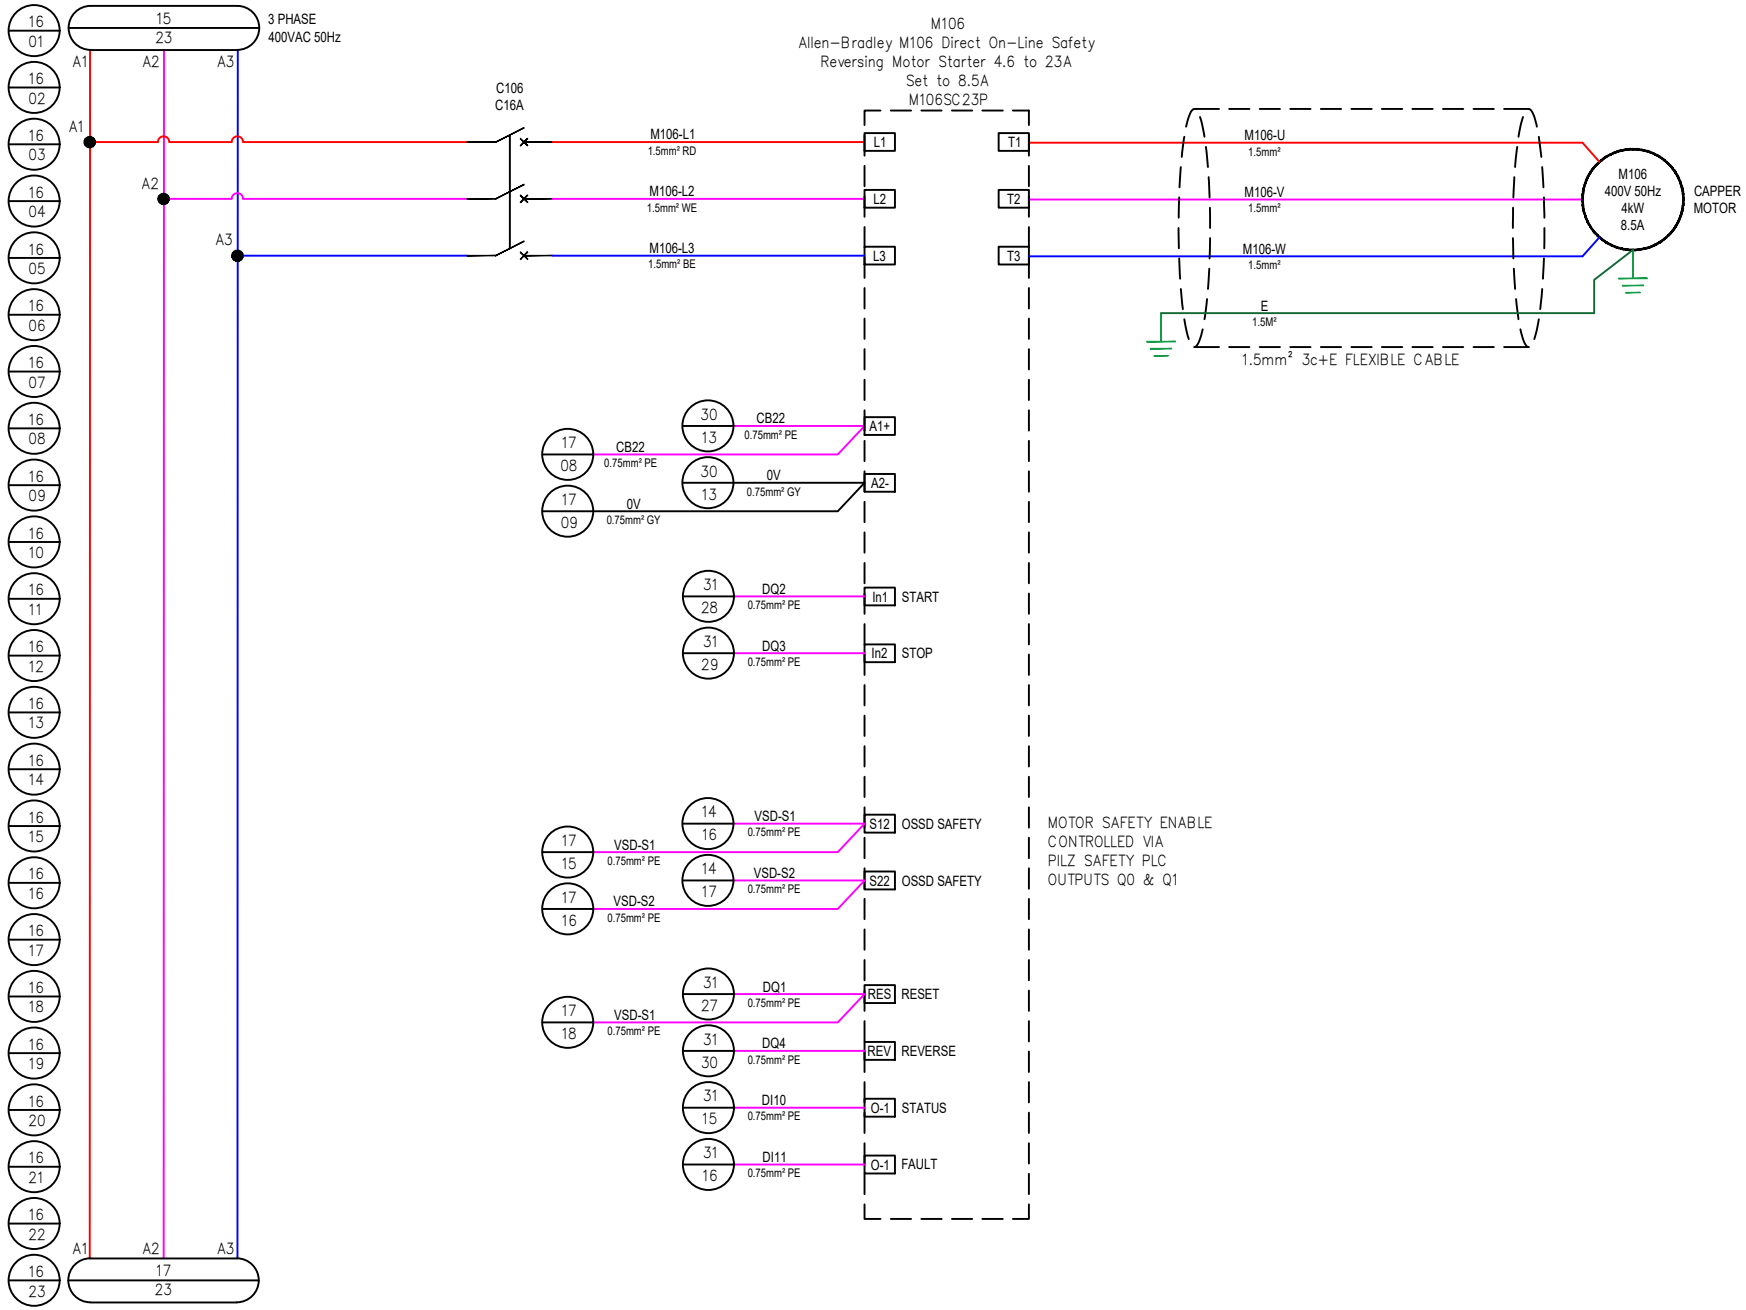

REV	DATE	DWN	CHK	APP	REVISION
E					
D					
C					
B					
A	28/08/26	D.B.	C.W.	C.W.	REVISION ONE, AS BUILT

THIS DRAWING IS OWNED BY FBS SOLUTIONS FOOD AND BEVERAGES AND IS ISSUED ON THE UNDERSTANDING THAT IT MAY NOT BE COPIED OR REPRODUCED IN WHOLE OR IN PART WITHOUT WRITTEN PERMISSION. NOR IS INFORMATION TO BE FURNISHED FROM WHICH COULD BE INJURIOUS TO THE ABOVE COMPANY

SCALE: NOT TO SCALE

	NAME	DATE
DRAWN	D. BORG	28/08/26
DESIGN	D. BORG	28/08/26
CHECKED	C. WHITELEY	28/08/26
APPROVED	C. WHITELEY	28/08/26

PROJECT: SCHLENKER 36/10

Serial No.: FBS Global Serial: 130039

FBS Solutions
45 Pelmet Cres, Thomastown VIC., Australia 3074
FOOD & BEVERAGE
Phone: +61 3 9191 2956
Contact: CLINT WHITELEY
Mobile: +61 418 383 441
E: enquiries@fbsglobal.com.au


DWG. NO.: 8001 A3

REVISION ONE, AS BUILT

SHEET TITLE: MOTORS

REVISION A

SHEET 16

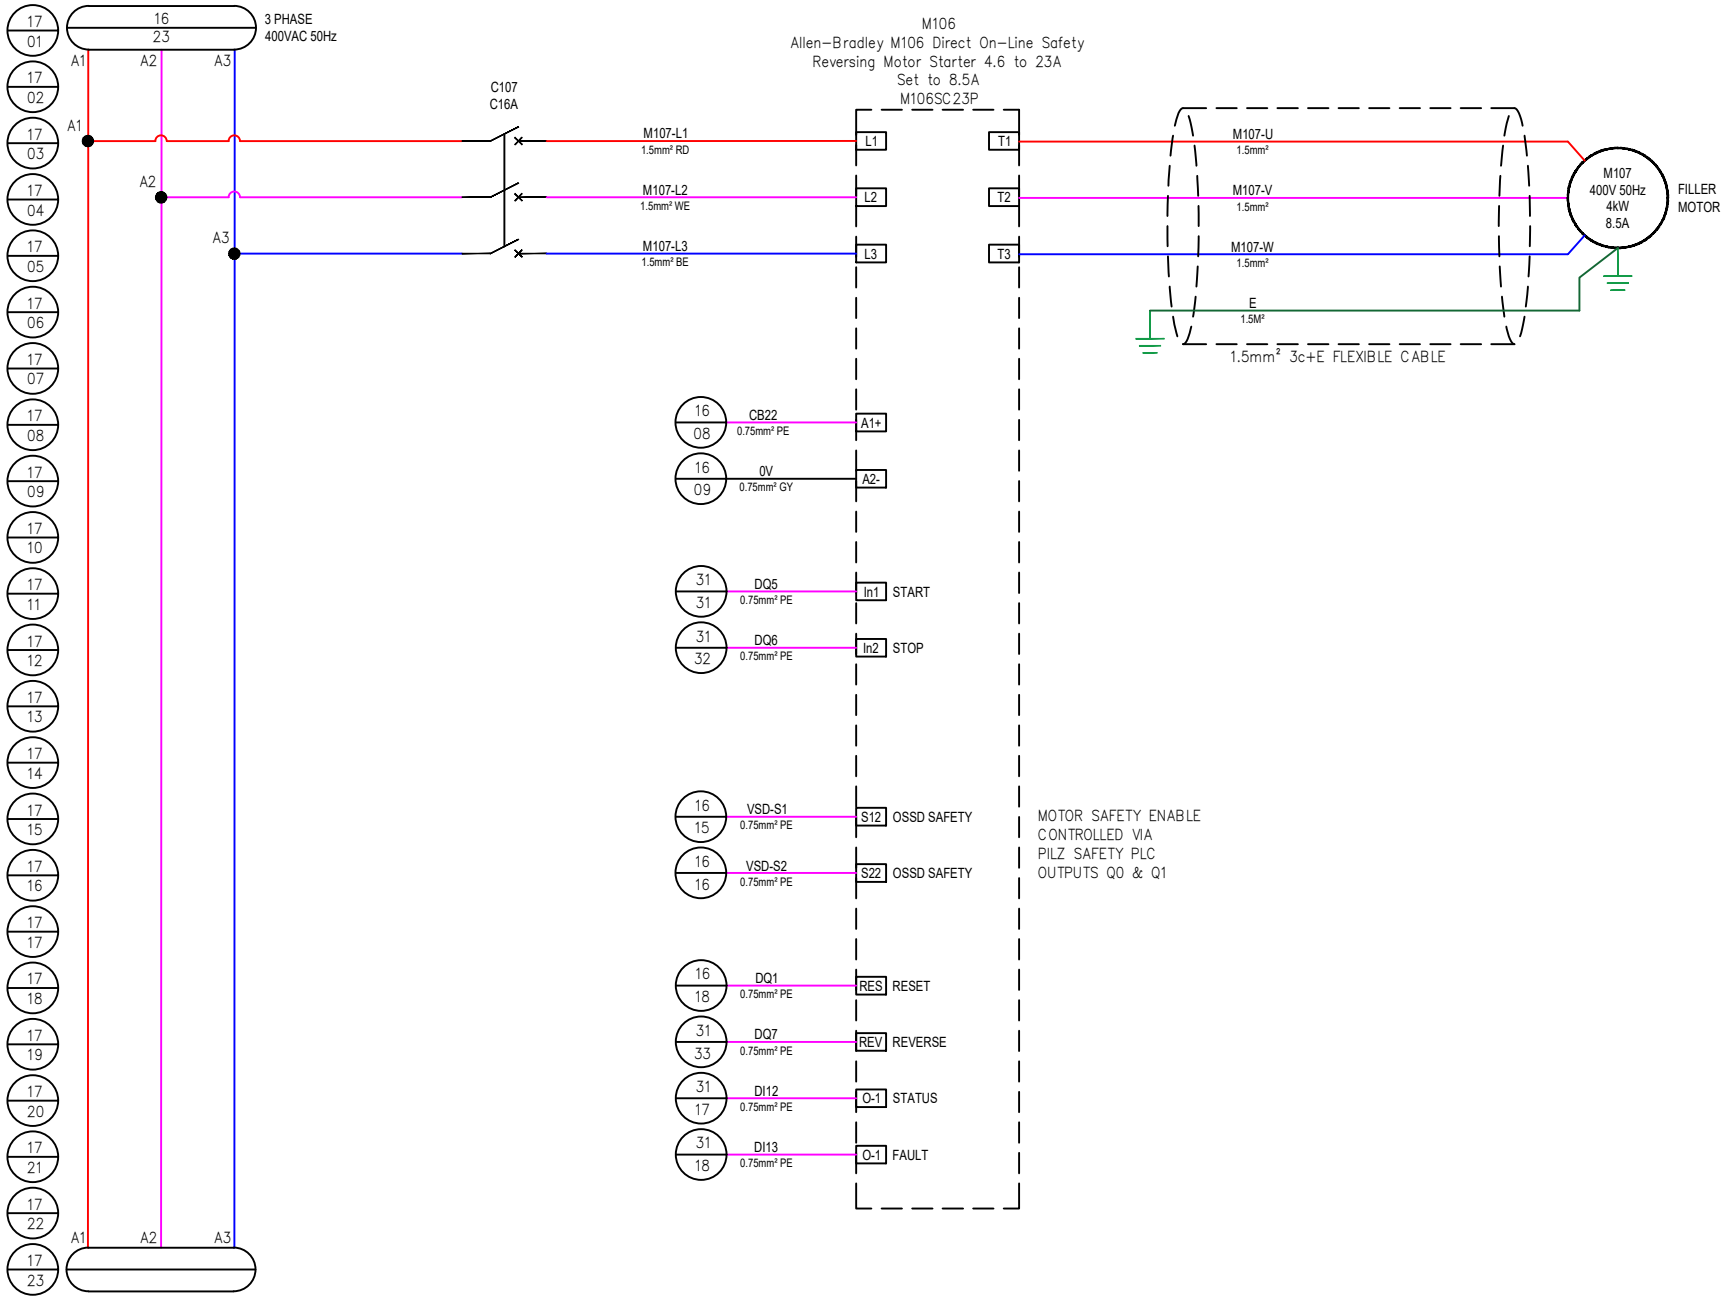

REV	DATE	DWN	CHK	APP	REVISION
E					
D					
C					
B					
A	28/08/26	D.B.	C.W.	C.W.	REVISION ONE, AS BUILT

THIS DRAWING IS OWNED BY FBS SOLUTIONS FOOD AND BEVERAGES AND IS ISSUED ON THE UNDERSTANDING THAT IT MAY NOT BE COPIED OR REPRODUCED IN WHOLE OR IN PART WITHOUT WRITTEN PERMISSION. NOR IS INFORMATION TO BE FURNISHED FROM WHICH COULD BE INJURIOUS TO THE ABOVE COMPANY

SCALE: NOT TO SCALE

	NAME	DATE
DRAWN	D. BORG	28/08/26
DESIGN	D. BORG	28/08/26
CHECKED	C. WHITELEY	28/08/26
APPROVED	C. WHITELEY	28/08/26

PROJECT: SCHLENKER 36/10

Serial No.: FBS Global Serial: 130039

FBS Solutions
45 Pelmet Cres, Thomastown VIC., Australia 3074
FOOD & BEVERAGE
Phone: +61 3 9191 2956
Contact: CLINT WHITELEY
Mobile: +61 418 383 441
E: enquiries@fbsglobal.com.au


DWG. NO.: 8001 A3

REVISION ONE, AS BUILT

SHEET TITLE: MOTORS

REVISION A

SHEET 17

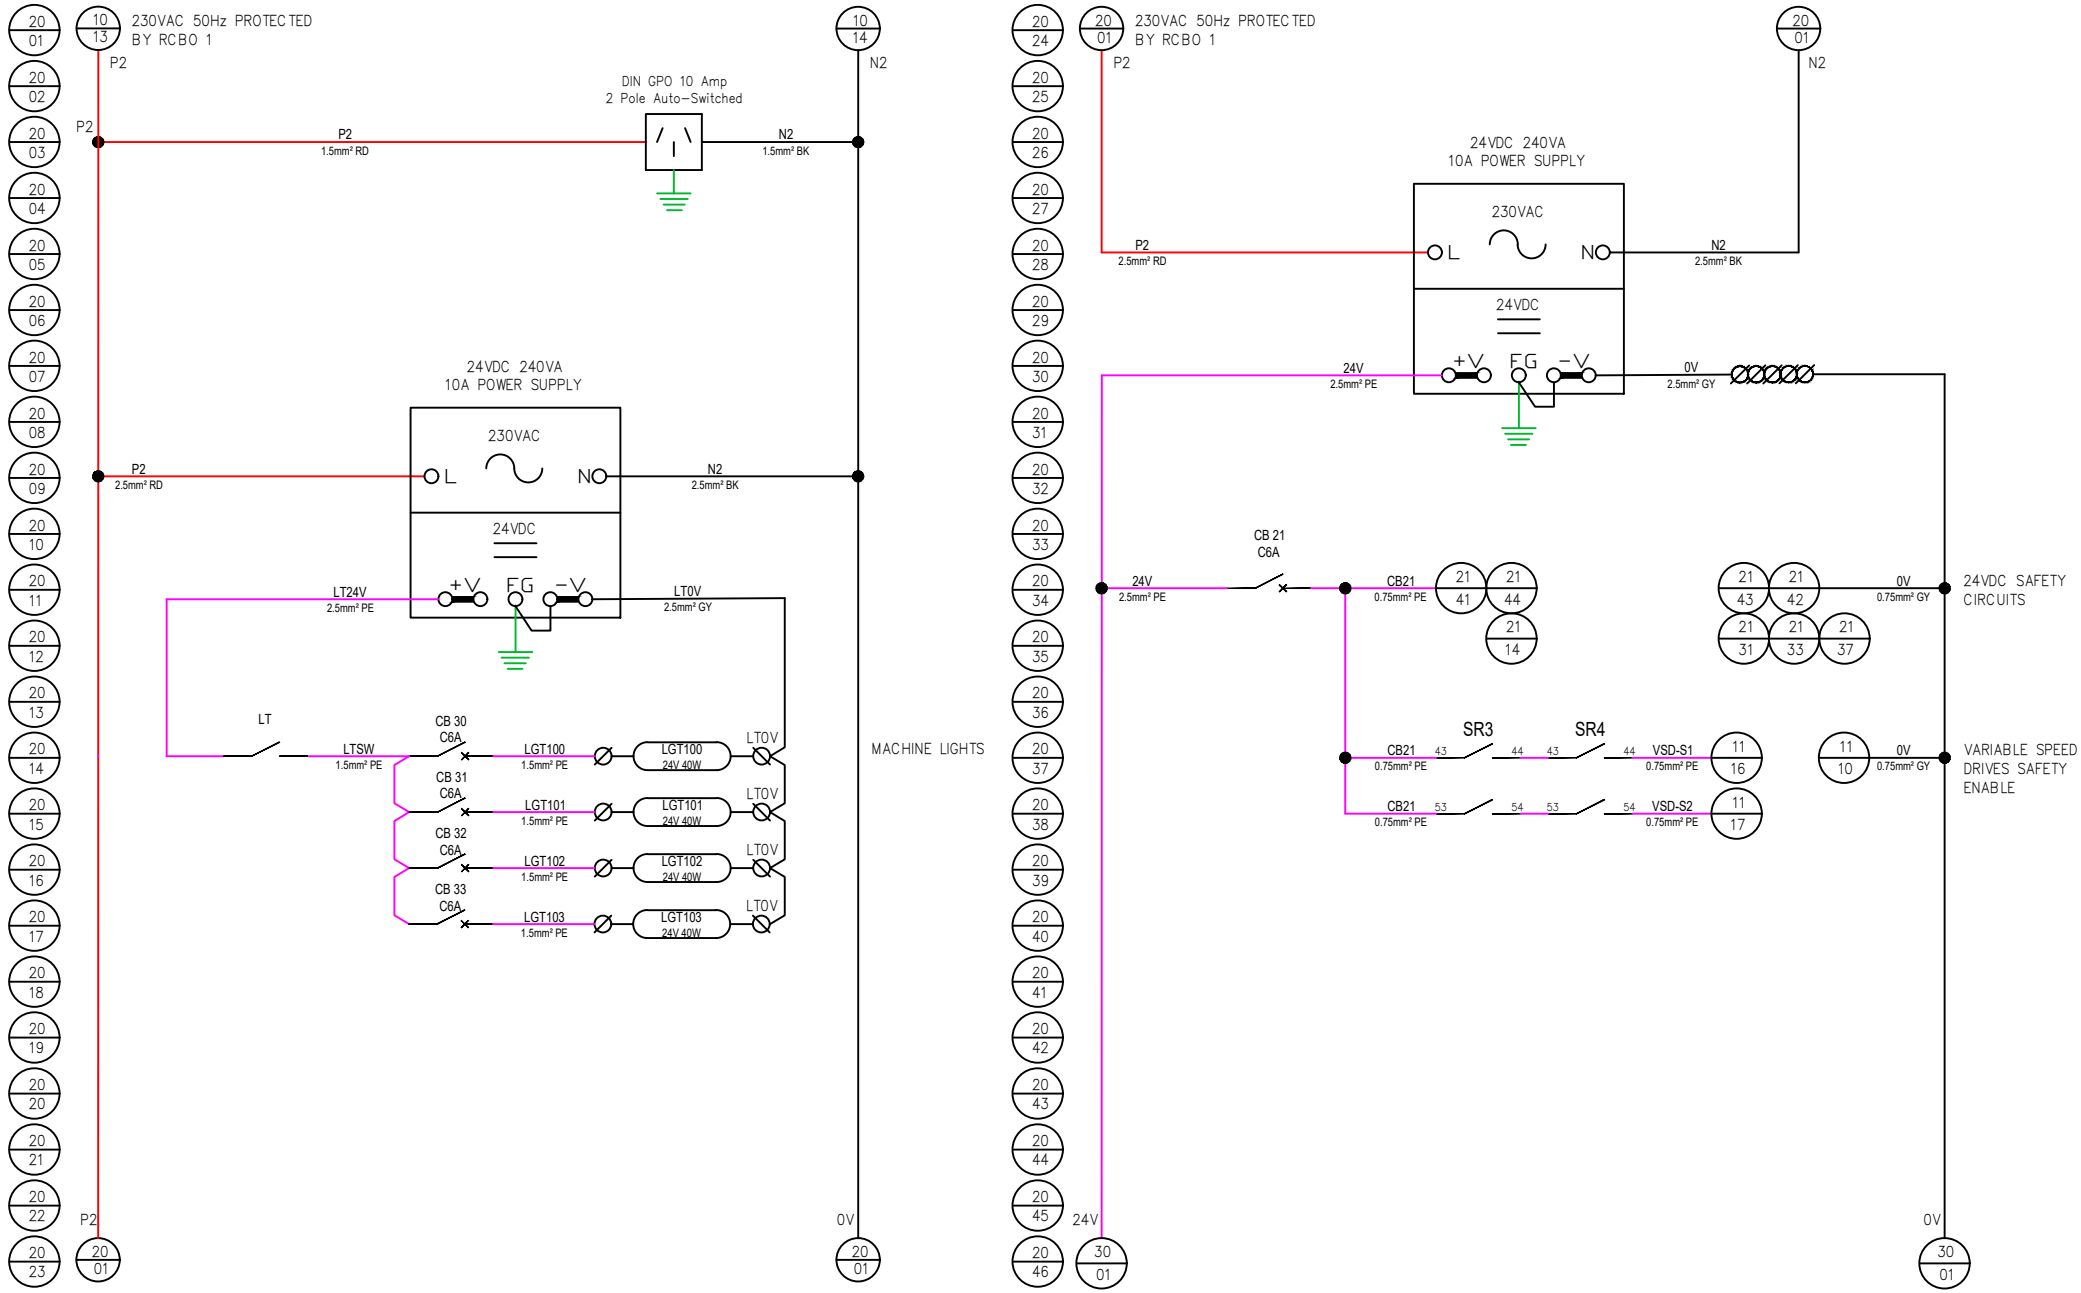

REV	DATE	DWN	CHK	APP	REVISION
E					
D					
C					
B					
A	28/08/26	D.B.	C.W.	C.W.	REVISION ONE, AS BUILT

THIS DRAWING IS OWNED BY FBS SOLUTIONS FOOD AND BEVERAGES AND IS ISSUED ON THE UNDERSTANDING THAT IT MAY NOT BE COPIED OR REPRODUCED IN WHOLE OR IN PART WITHOUT WRITTEN PERMISSION. NOR IS INFORMATION TO BE FURNISHED FROM WHICH COULD BE INJURIOUS TO THE ABOVE COMPANY

SCALE: NOT TO SCALE

	NAME	DATE
DRAWN	D. BORG	28/08/26
DESIGN	D. BORG	28/08/26
CHECKED	C. WHITELEY	28/08/26
APPROVED	C. WHITELEY	28/08/26

PROJECT: SCHLENKER 36/10

Serial No.: FBS Global Serial: 130039

FBS Solutions
45 Pelmet Cres, Thomastown VIC., Australia 3074
FOOD & BEVERAGE
Phone: +61 3 9191 2956
Contact: CLINT WHITELEY
Mobile: +61 418 383 441
E: enquiries@fbsglobal.com.au

DWG. NO.: 8001 A3

REVISION ONE, AS BUILT

SHEET TITLE: CIRCUITS

REVISION A

SHEET 20

BASE UNIT

Pilz PNOZ M B0
Controller Base Unit

X3

T0 0.75mm² PE	M0 ES1-M0 0.75mm² PE	CONFIG. In/Out 0.5A 12W — HMI PANEL ESTOP CH.1
T1 0.75mm² PE	M1 ES1-M1 0.75mm² PE	CONFIG. In/Out 0.5A 12W — HMI PANEL ESTOP CH.2
T0	M2 ES2-M2 0.75mm² PE	CONFIG. In/Out 0.5A 12W — FRONT ESTOP 2 CH.1
T1	M3 ES2-M3 0.75mm² PE	CONFIG. In/Out 0.5A 12W — FRONT ESTOP 2 CH.2
T0	I4 ES3-I4 0.75mm² PE	SIDE ESTOP 3 CH.1
T1	I5 ES3-I5 0.75mm² PE	SIDE ESTOP 3 CH.2
T0	I6 ES4-I6 0.75mm² PE	BACK ESTOP 4 CH.1
T1	I7 ES4-I7 0.75mm² PE	BACK ESTOP 4 CH.2

X1

CB21 0.75mm² PE	I8 RST-I8 0.75mm² PE	SAFETY RESET PUSH BUTTON
CB21	I9 DR-I9 0.75mm² PE	DOOR REQUEST PUSH BUTTON
CB21	I10 DR-I10 0.75mm² PE	DOOR REQUEST PUSH BUTTON
CB21 S2 S1A S1	I11 EDM-I10 0.75mm² PE	VARIABLE SPEED DRIVES ENABLE SAFETY RELAYS FEEDBACK LOOP
T0 0.75mm² PE	I12 I12 0.75mm² PE	JOG PENDANT ENABLING SWITCH CH. 1.
T1 0.75mm² PE	I13 I13 0.75mm² PE	JOG PENDANT ENABLING SWITCH CH. 2.
	I14 I14 0.75mm² PE	
	I15 I15 0.75mm² PE	

BASE UNIT

REV B - SAFE MOTION MODULE ADDED

PNOZ m EF 1MM | ORDER 772170 | AXIS 1

Installed in the PNOZmulti rack and connected by lateral bus.

DFS60S Pro encoder connects to X12 - see new Sheet 23A.

Validate hardware order and Axis 1 project assignment before operation.

T3 0.75mm² PE	T3 TEST PULSE — GATES CH.2
0V 0.75mm² GY	S1 — O0 240V 6A 1440VA — VARIABLE SPEED DRIVES ENABLE SAFETY RELAY 1
	S2 — O1 240V 6A 1440VA — VARIABLE SPEED DRIVES ENABLE SAFETY RELAY 2
G7SA-4A2B 24VDC	O2 240V 6A 1440VA
	O3 240V 6A 1440VA

X4

0V 0.75mm² GY	M16 RST-M16 0.75mm² PE	CONFIG. In/Out 0.5A 12W — SAFETY RESET PUSH BUTTON INDICATOR
0V	M17 M17 0.75mm² PE	CONFIG. In/Out 0.5A 12W — DOOR REQUEST PUSH BUTTON INDICATOR
0V	M18 M18 0.75mm² PE	CONFIG. In/Out 0.5A 12W — DOOR REQUEST PUSH BUTTON INDICATOR
	M19 M19 0.75mm² PE	CONFIG. In/Out 0.5A 12W
CB21 0.75mm² PE	A1	
0V 0.75mm² GY	A2	
0V 0.75mm² GY	0V	
CB21 0.75mm² PE	24V	

REV	DATE	DWN	CHK	APP	REVISION
A	28/08/26	D.B.	C.W.	C.W.	REVISION ONE, AS BUILT

THIS DRAWING IS OWNED BY FBS SOLUTIONS FOOD AND BEVERAGES AND IS ISSUED ON THE UNDERSTANDING THAT IT MAY NOT BE COPIED OR REPRODUCED IN WHOLE OR IN PART WITHOUT WRITTEN PERMISSION. NOR IS INFORMATION TO BE FURNISHED FROM WHICH COULD BE INJURIOUS TO THE ABOVE COMPANY

SCALE: NOT TO SCALE

	NAME	DATE
DRAWN	D. BORG	28/08/26
DESIGN	D. BORG	28/08/26
CHECKED	C. WHITELEY	28/08/26
APPROVED	C. WHITELEY	28/08/26

PROJECT: SCHLENKER 36/10

Serial No.: FBS Global Serial: 130039

FBS Solutions
45 Pelmet Cres, Thomastown VIC., Australia 3074
FOOD & BEVERAGE
Phone: +61 3 9191 2956
Contact: CLINT WHITELEY
Mobile: +61 418 383 441
E: enquiries@fbsglobal.com.au

DWG. NO.: 8001 A3


REVISION ONE, AS BUILT

SHEET TITLE: SAFETY CIRCUITS

REVISION A

SHEET 21

MODULE 1

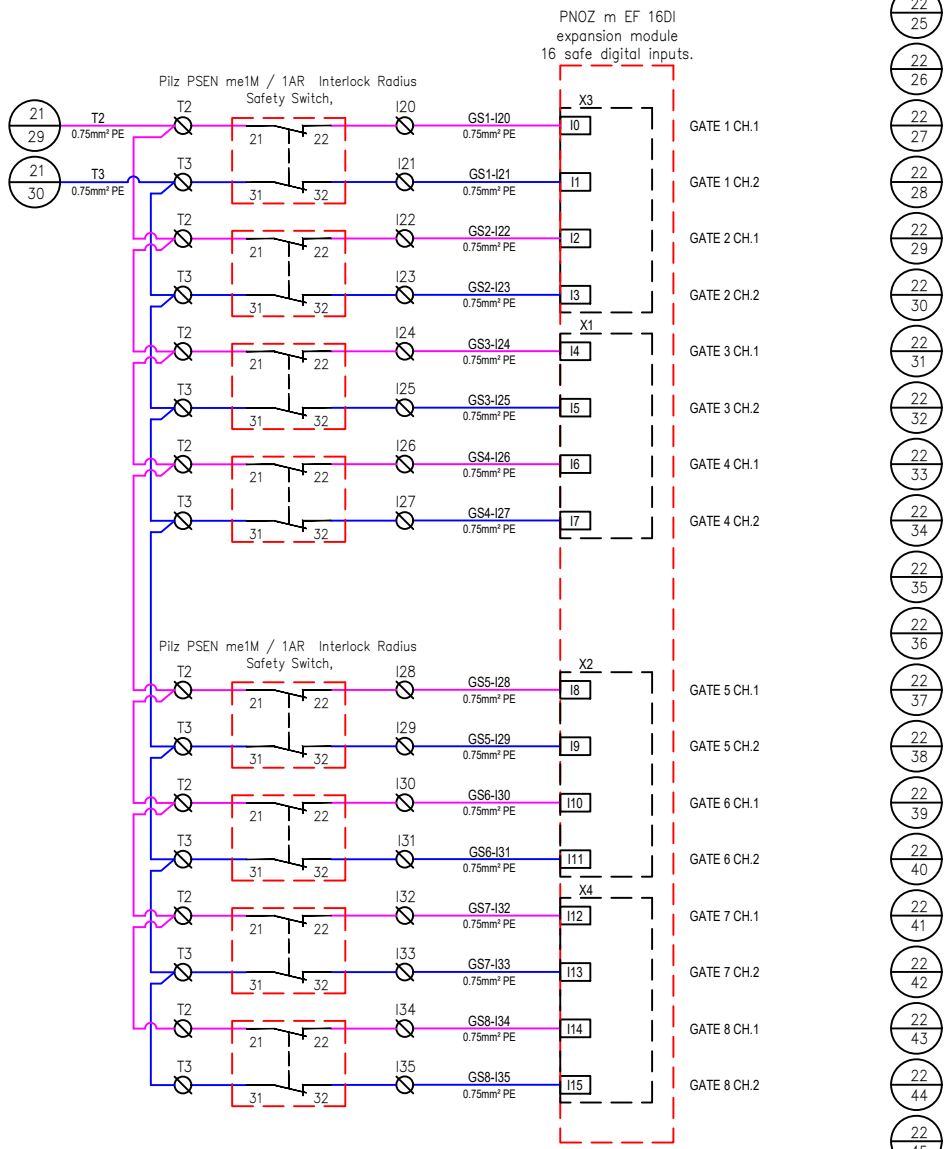

REV	DATE	DWN	CHK	APP	REVISION
A	28/08/26	D.B.	C.W.	C.W.	REVISION ONE, AS BUILT

THIS DRAWING IS OWNED BY FBS SOLUTIONS FOOD AND BEVERAGES AND IS ISSUED ON THE UNDERSTANDING THAT IT MAY NOT BE COPIED OR REPRODUCED IN WHOLE OR IN PART WITHOUT WRITTEN PERMISSION. NOR IS INFORMATION TO BE FURNISHED FROM WHICH COULD BE INJURIOUS TO THE ABOVE COMPANY

SCALE: NOT TO SCALE

	NAME	DATE
DRAWN	D. BORG	28/08/26
DESIGN	D. BORG	28/08/26
CHECKED	C. WHITELEY	28/08/26
APPROVED	C. WHITELEY	28/08/26

PROJECT: SCHLENKER 36/10

Serial No.: FBS Global Serial: 130039

FBS Solutions
45 Pelmet Cres, Thomastown VIC., Australia 3074
FOOD & BEVERAGE
Phone: +61 3 9191 2956
Contact: CLINT WHITELEY
Mobile: +61 418 383 441
E: enquiries@fbsglobal.com.au

DWG. NO.: 8001 A3


REVISION ONE, AS BUILT

SHEET TITLE: SAFETY CIRCUITS


REVISION A

SHEET 22

MODULE 2

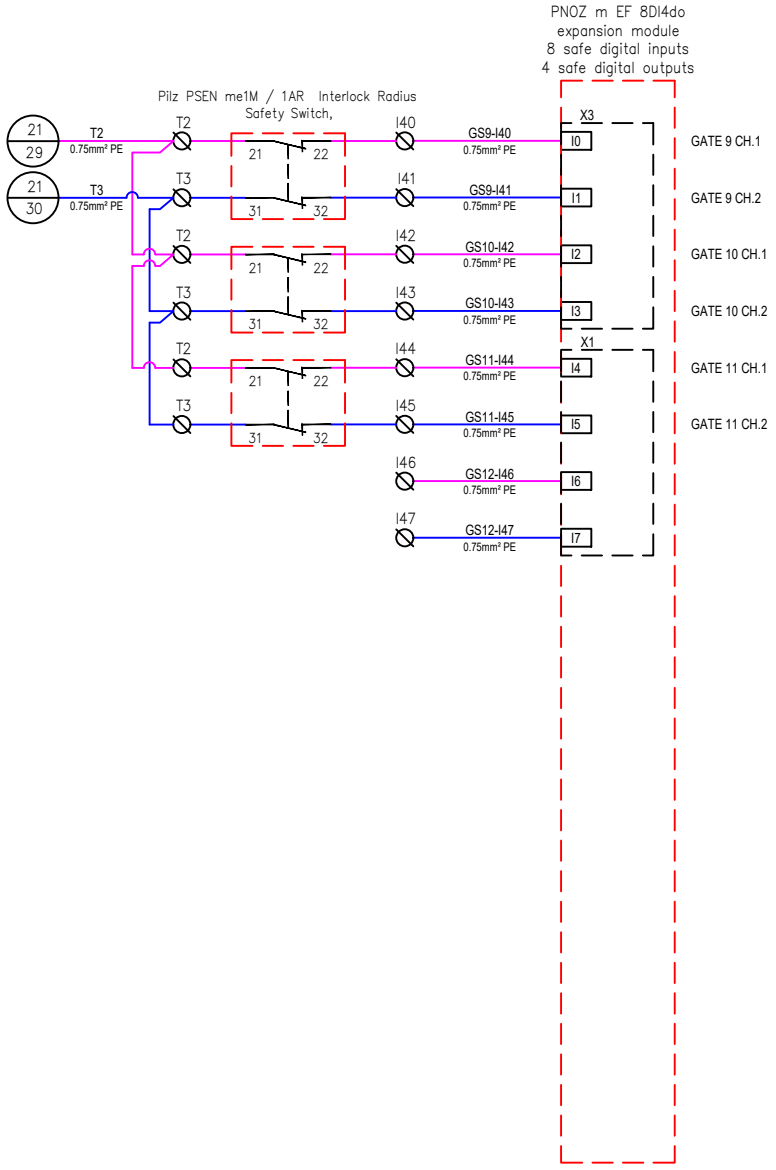

MODULE 2

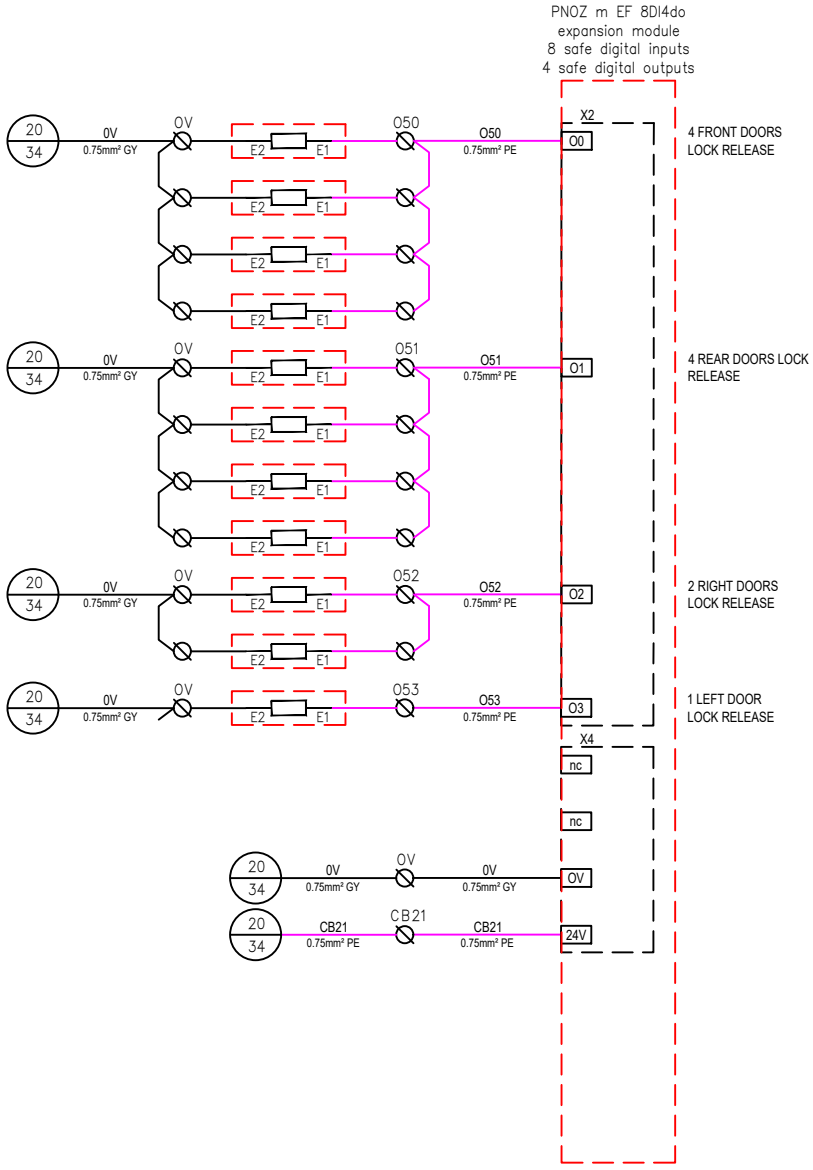

REV	DATE	DWN	CHK	APP	REVISION
E		0	1		2 3 4 5 6
D					
C					
B					
A	28/08/26	D.B.	C.W.	C.W.	REVISION ONE, AS BUILT

THIS DRAWING IS OWNED BY FBS SOLUTIONS FOOD AND BEVERAGES AND IS ISSUED ON THE UNDERSTANDING THAT IT MAY NOT BE COPIED OR REPRODUCED IN WHOLE OR IN PART WITHOUT WRITTEN PERMISSION. NOR IS INFORMATION TO BE FURNISHED FROM WHICH COULD BE INJURIOUS TO THE ABOVE COMPANY

SCALE: NOT TO SCALE

	NAME	DATE
DRAWN	D. BORG	28/08/26
DESIGN	D. BORG	28/08/26
CHECKED	C. WHITELEY	28/08/26
APPROVED	C. WHITELEY	28/08/26

PROJECT: SCHLENKER 36/10

Serial No.: FBS Global Serial: 130039

FBS Solutions
45 Pelmet Cres, Thomastown VIC., Australia 3074
FOOD & BEVERAGE
Phone: +61 3 9191 2956
Contact: CLINT WHITELEY
Mobile: +61 418 383 441
E: enquiries@fbsglobal.com.au

DWG. NO.: 8001 A3

REVISION ONE, AS BUILT

SHEET TITLE: SAFETY CIRCUITS

REVISION A

SHEET 23

PNOZ m EF 1MM - DFS60S PRO ENCODER WIRING

RACK POSITION



X12 TERMINAL-TO-TERMINAL CONNECTION

PNOZ X12		DFS60S PRO CONDUCTOR	ENCODER FUNCTION
1	S	RED	+U / monitored +24 VDC
2	GND	BLUE	GND / 0 V
3	Z	PURPLE	Z index
4	A	WHITE	A track
5	/A	BROWN	/A track
6	/Z	YELLOW	/Z index
7	B	PINK	B track
8	/B	BLACK	/B track

+24 VDC PELV/SELV -> encoder +U (red) and X12 pin 1 S. Pin 1 monitors supply; it does not power the encoder.


0 VDC -> encoder GND (blue) and X12 pin 2 GND. Connect cable shield to PE at one point only.

Remove the old direct encoder connection to Siemens DI0...DI5. Do not parallel signals without an approved adapter and assessment.

COMMISSIONING HOLD

Verify encoder label/continuity, PNOZmulti Axis 1 assignment, signal type and safety validation before operation.

All physical wiring shall be carried out de-energised by qualified electrical and functional-safety personnel.

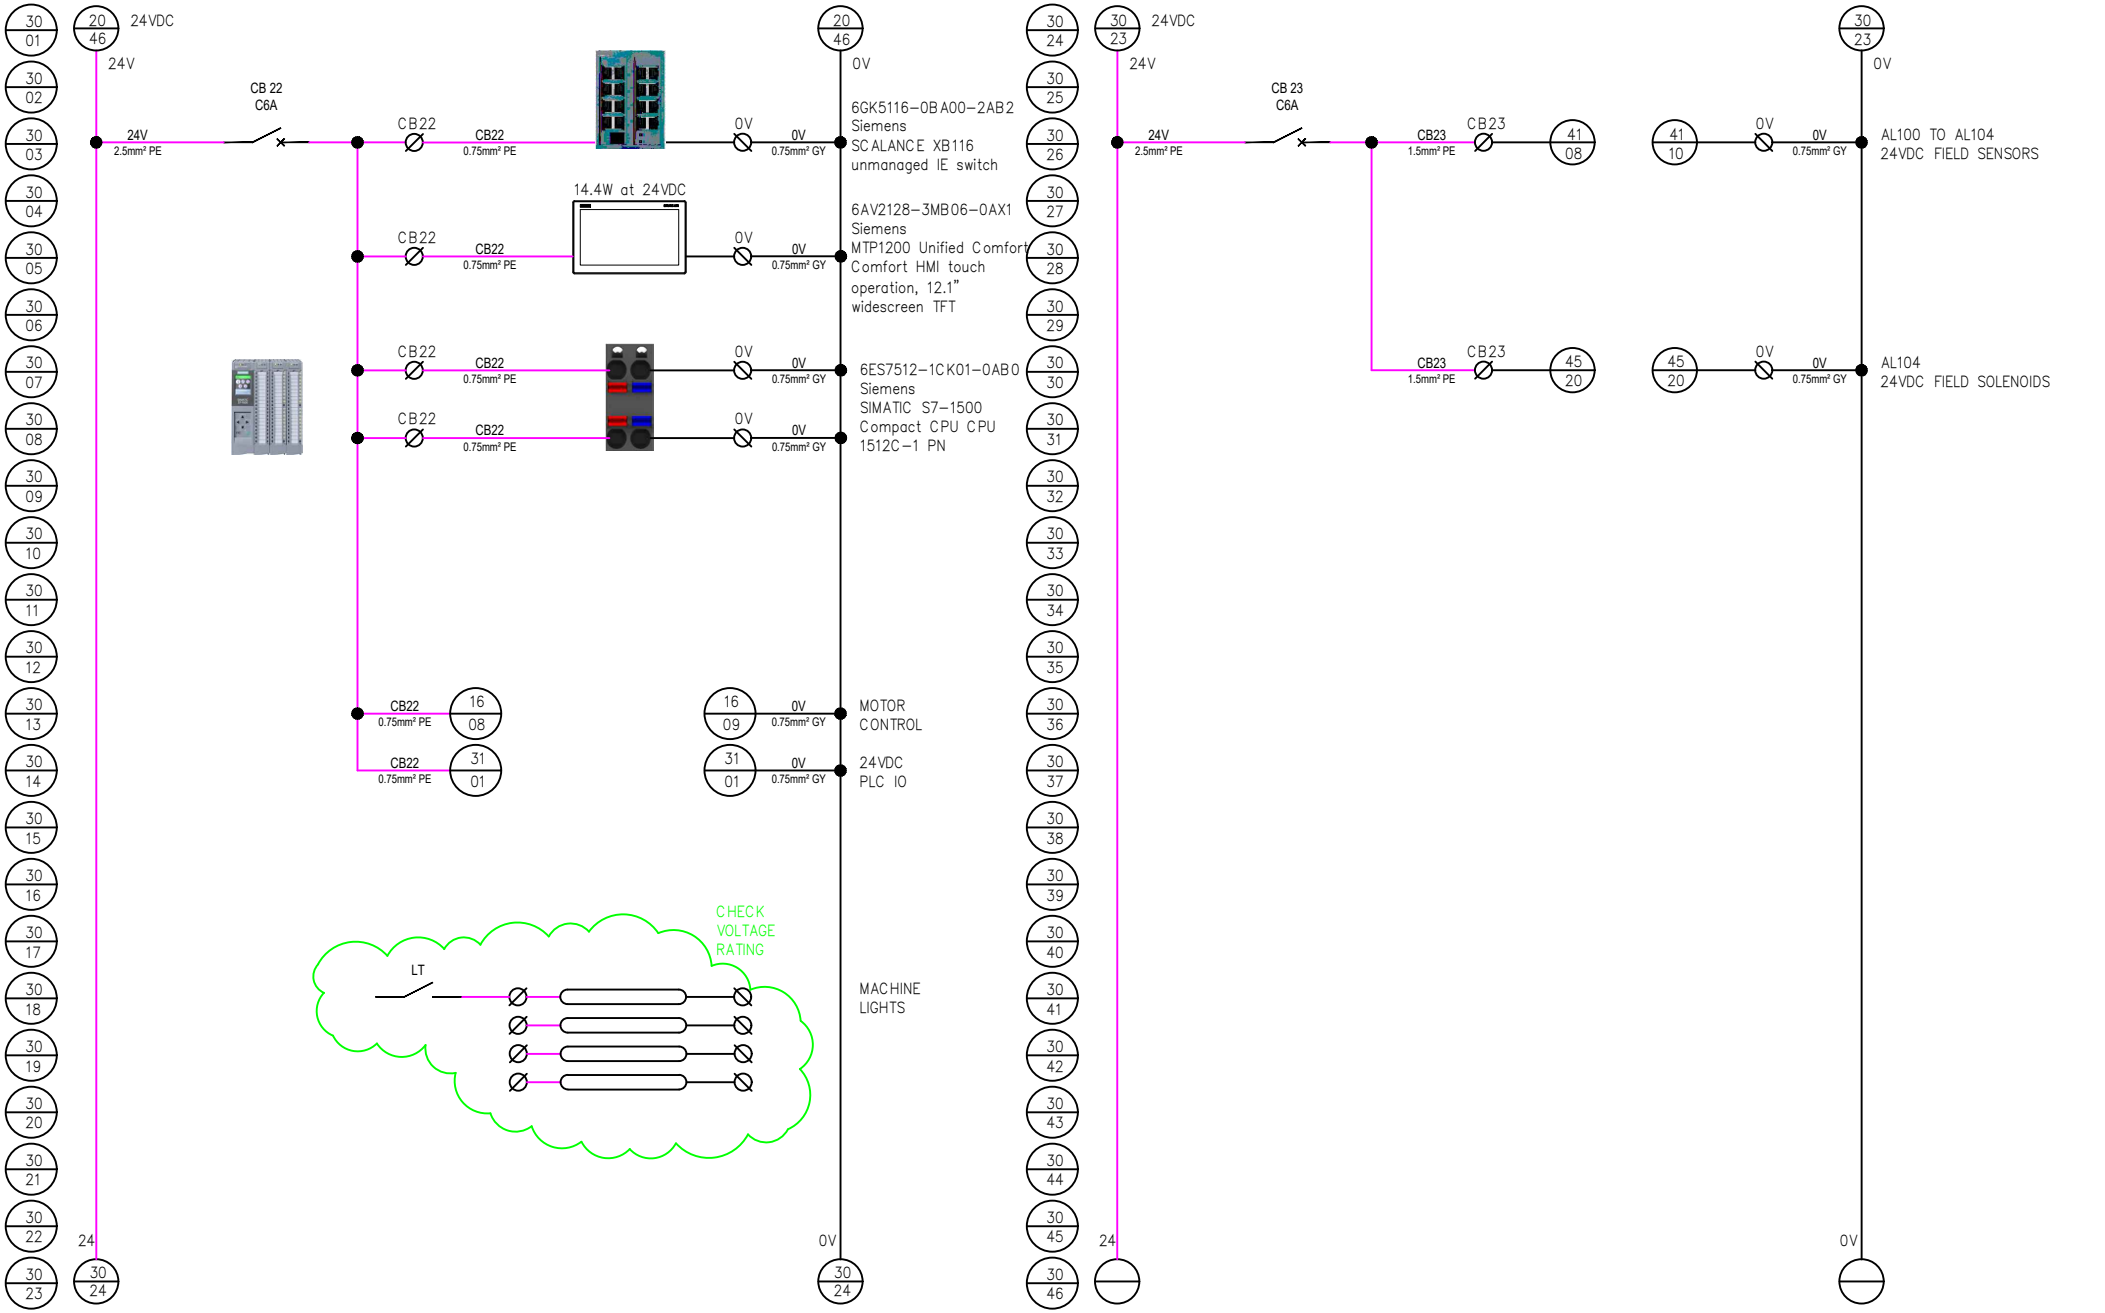

REV	DATE	DWN	CHK	APP	REVISION
E		0	1		2 3 4 5 6
D					
C					
B					
A	28/08/26	D.B.	C.W.	C.W.	REVISION ONE, AS BUILT

THIS DRAWING IS OWNED BY FBS SOLUTIONS FOOD AND BEVERAGES AND IS ISSUED ON THE UNDERSTANDING THAT IT MAY NOT BE COPIED OR REPRODUCED IN WHOLE OR IN PART WITHOUT WRITTEN PERMISSION. NOR IS INFORMATION TO BE FURNISHED FROM WHICH COULD BE INJURIOUS TO THE ABOVE COMPANY

SCALE: NOT TO SCALE

	NAME	DATE
DRAWN	D. BORG	28/08/26
DESIGN	D. BORG	28/08/26
CHECKED	C. WHITELEY	28/08/26
APPROVED	C. WHITELEY	28/08/26

PROJECT: SCHLENKER 36/10

Serial No.: FBS Global Serial: 130039

FBS Solutions
45 Pelmet Cres, Thomastown VIC., Australia 3074
FOOD & BEVERAGE
Phone: +61 3 9191 2956
Contact: CLINT WHITELEY
Mobile: +61 418 383 441
E: enquiries@fbsglobal.com.au

DWG. NO.: 8001 A3

REVISION ONE, AS BUILT

SHEET TITLE: CIRCUITS

REVISION A

SHEET 30

REV B - OLD ENCODER DI0...DI5 WIRING SUPERSEDED


DFS60S PRO -> PNOZ m EF 1MM X12

Do not parallel encoder tracks directly to the Siemens DI module.

Siemens DI0...DI5 allocation requires review before reuse.

Complete pin, colour, supply and shield wiring: Sheet 23A.

Cabinet wiring by qualified personnel with supply isolated.

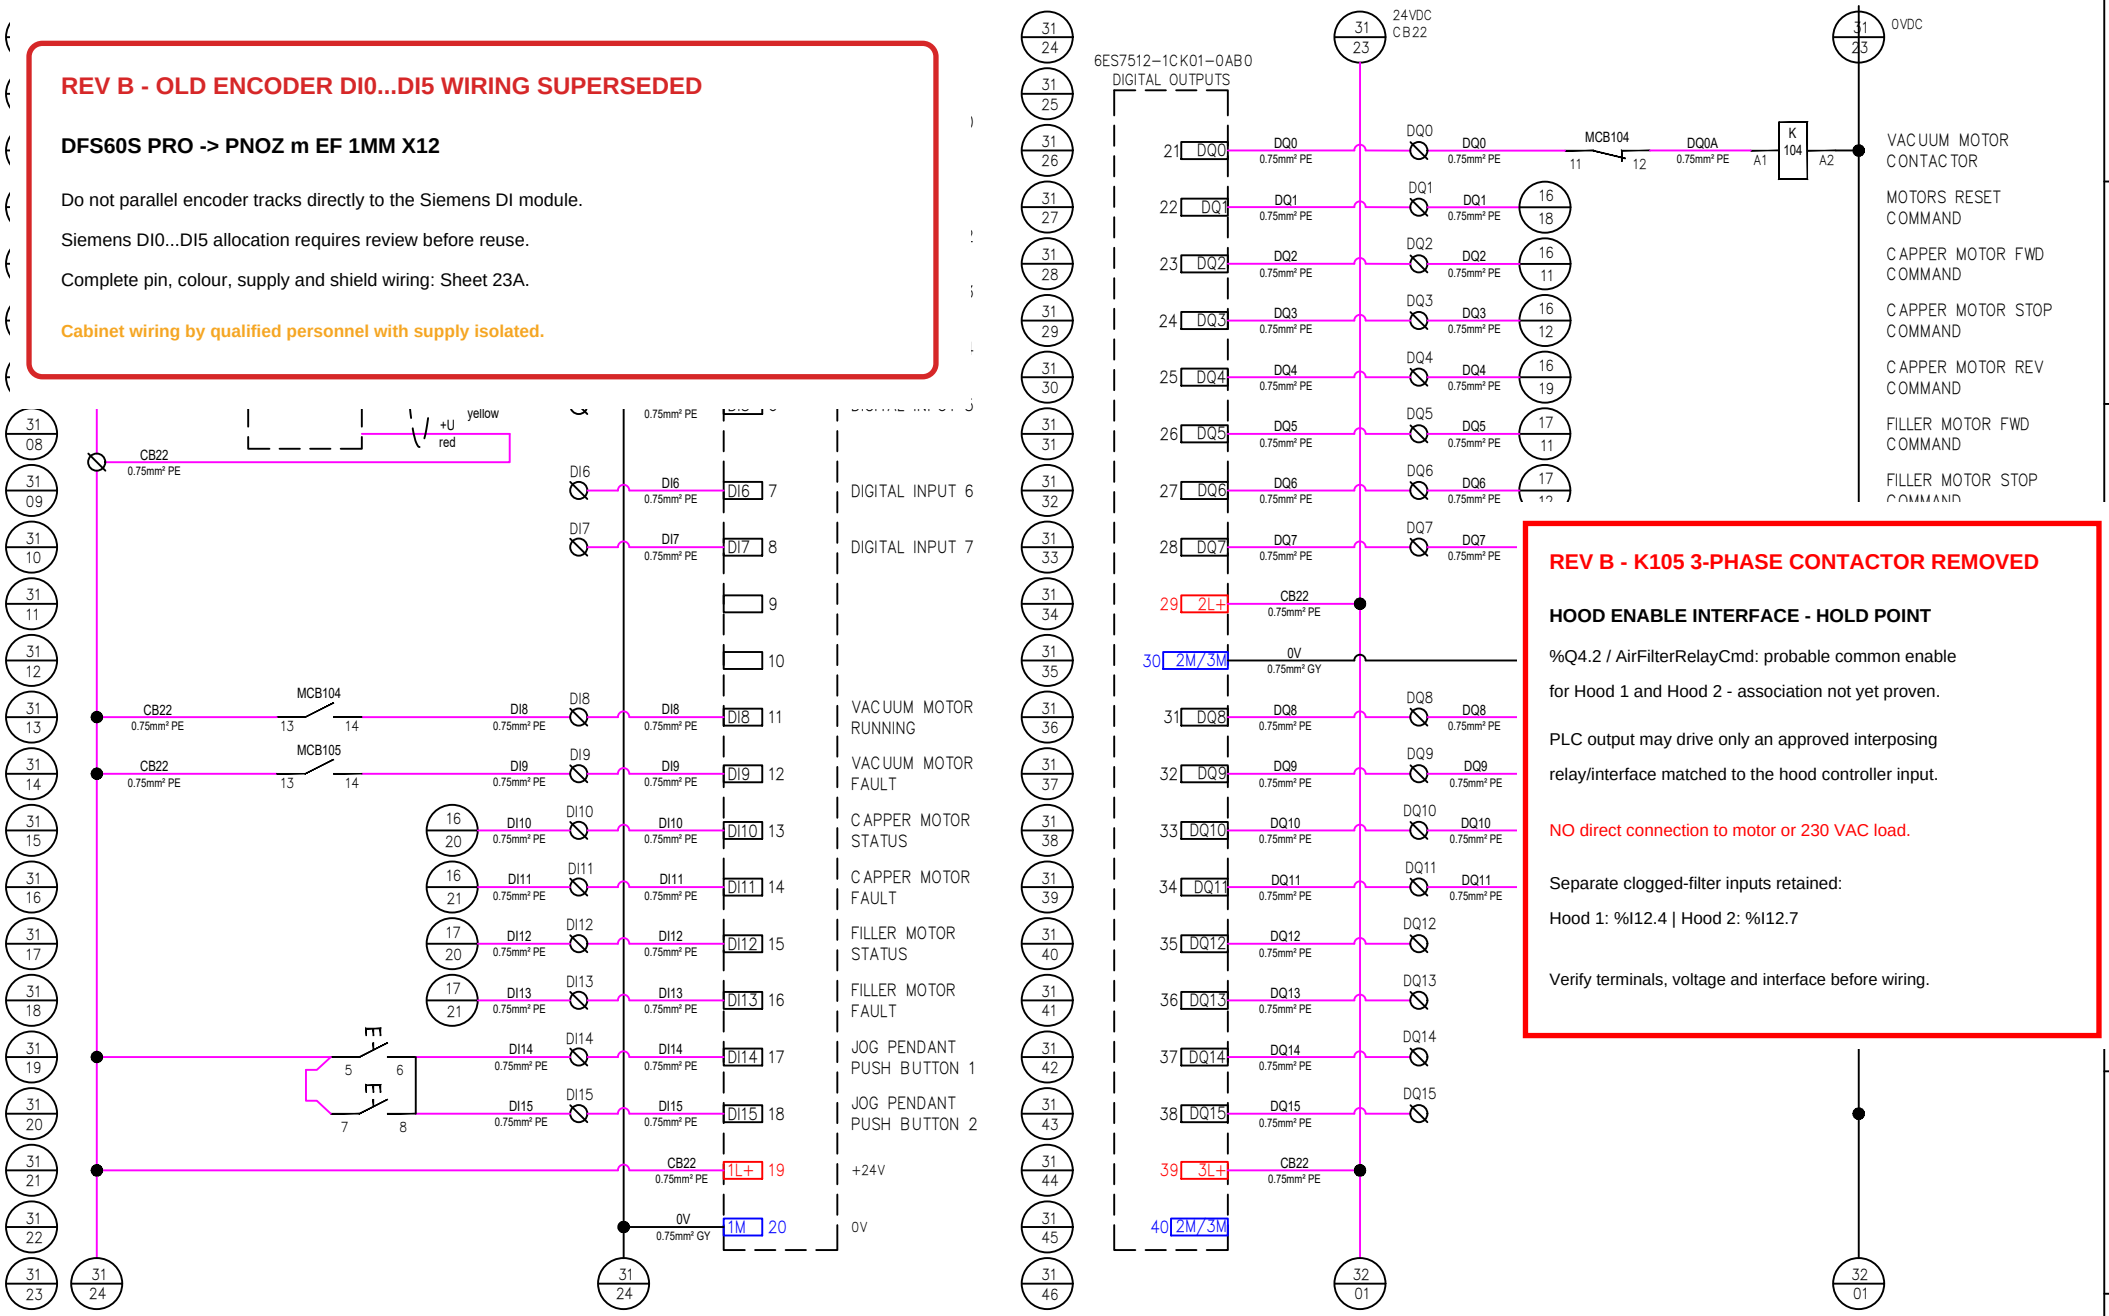

REV B - K105 3-PHASE CONTACTOR REMOVED

HOOD ENABLE INTERFACE - HOLD POINT

%Q4.2 / AirFilterRelayCmd: probable common enable for Hood 1 and Hood 2 - association not yet proven.

PLC output may drive only an approved interposing relay/interface matched to the hood controller input.

NO direct connection to motor or 230 VAC load.

Separate clogged-filter inputs retained:

Hood 1: %I12.4 | Hood 2: %I12.7

Verify terminals, voltage and interface before wiring.

REV	DATE	DWN	CHK	APP	REVISION
A	28/08/26	D.B.	C.W.	C.W.	REVISION ONE, AS BUILT

THIS DRAWING IS OWNED BY FBS SOLUTIONS FOOD AND BEVERAGES AND IS ISSUED ON THE UNDERSTANDING THAT IT MAY NOT BE COPIED OR REPRODUCED IN WHOLE OR IN PART WITHOUT WRITTEN PERMISSION. NOR IS INFORMATION TO BE FURNISHED FROM WHICH COULD BE INJURIOUS TO THE ABOVE COMPANY

SCALE: NOT TO SCALE	NAME	DATE
DRAWN	D. BORG	28/08/26
DESIGN	D. BORG	28/08/26
CHECKED	C. WHITELEY	28/08/26
APPROVED	C. WHITELEY	28/08/26

PROJECT: SCHLENKER 36/10

Serial No.: FBS Global Serial: 130039

FBS Solutions
45 Pelmet Cres, Thomastown VIC., Australia 3074
FOOD & BEVERAGE
Phone: +61 3 9191 2956
Contact: CLINT WHITELEY
Mobile: +61 418 383 441
E: enquiries@fbsglobal.com.au


DWG. NO.: 8001 A3

REVISION ONE, AS BUILT

SHEET TITLE: DIGITAL INPUTS/OUTPUTS

REVISION A

SHEET 31

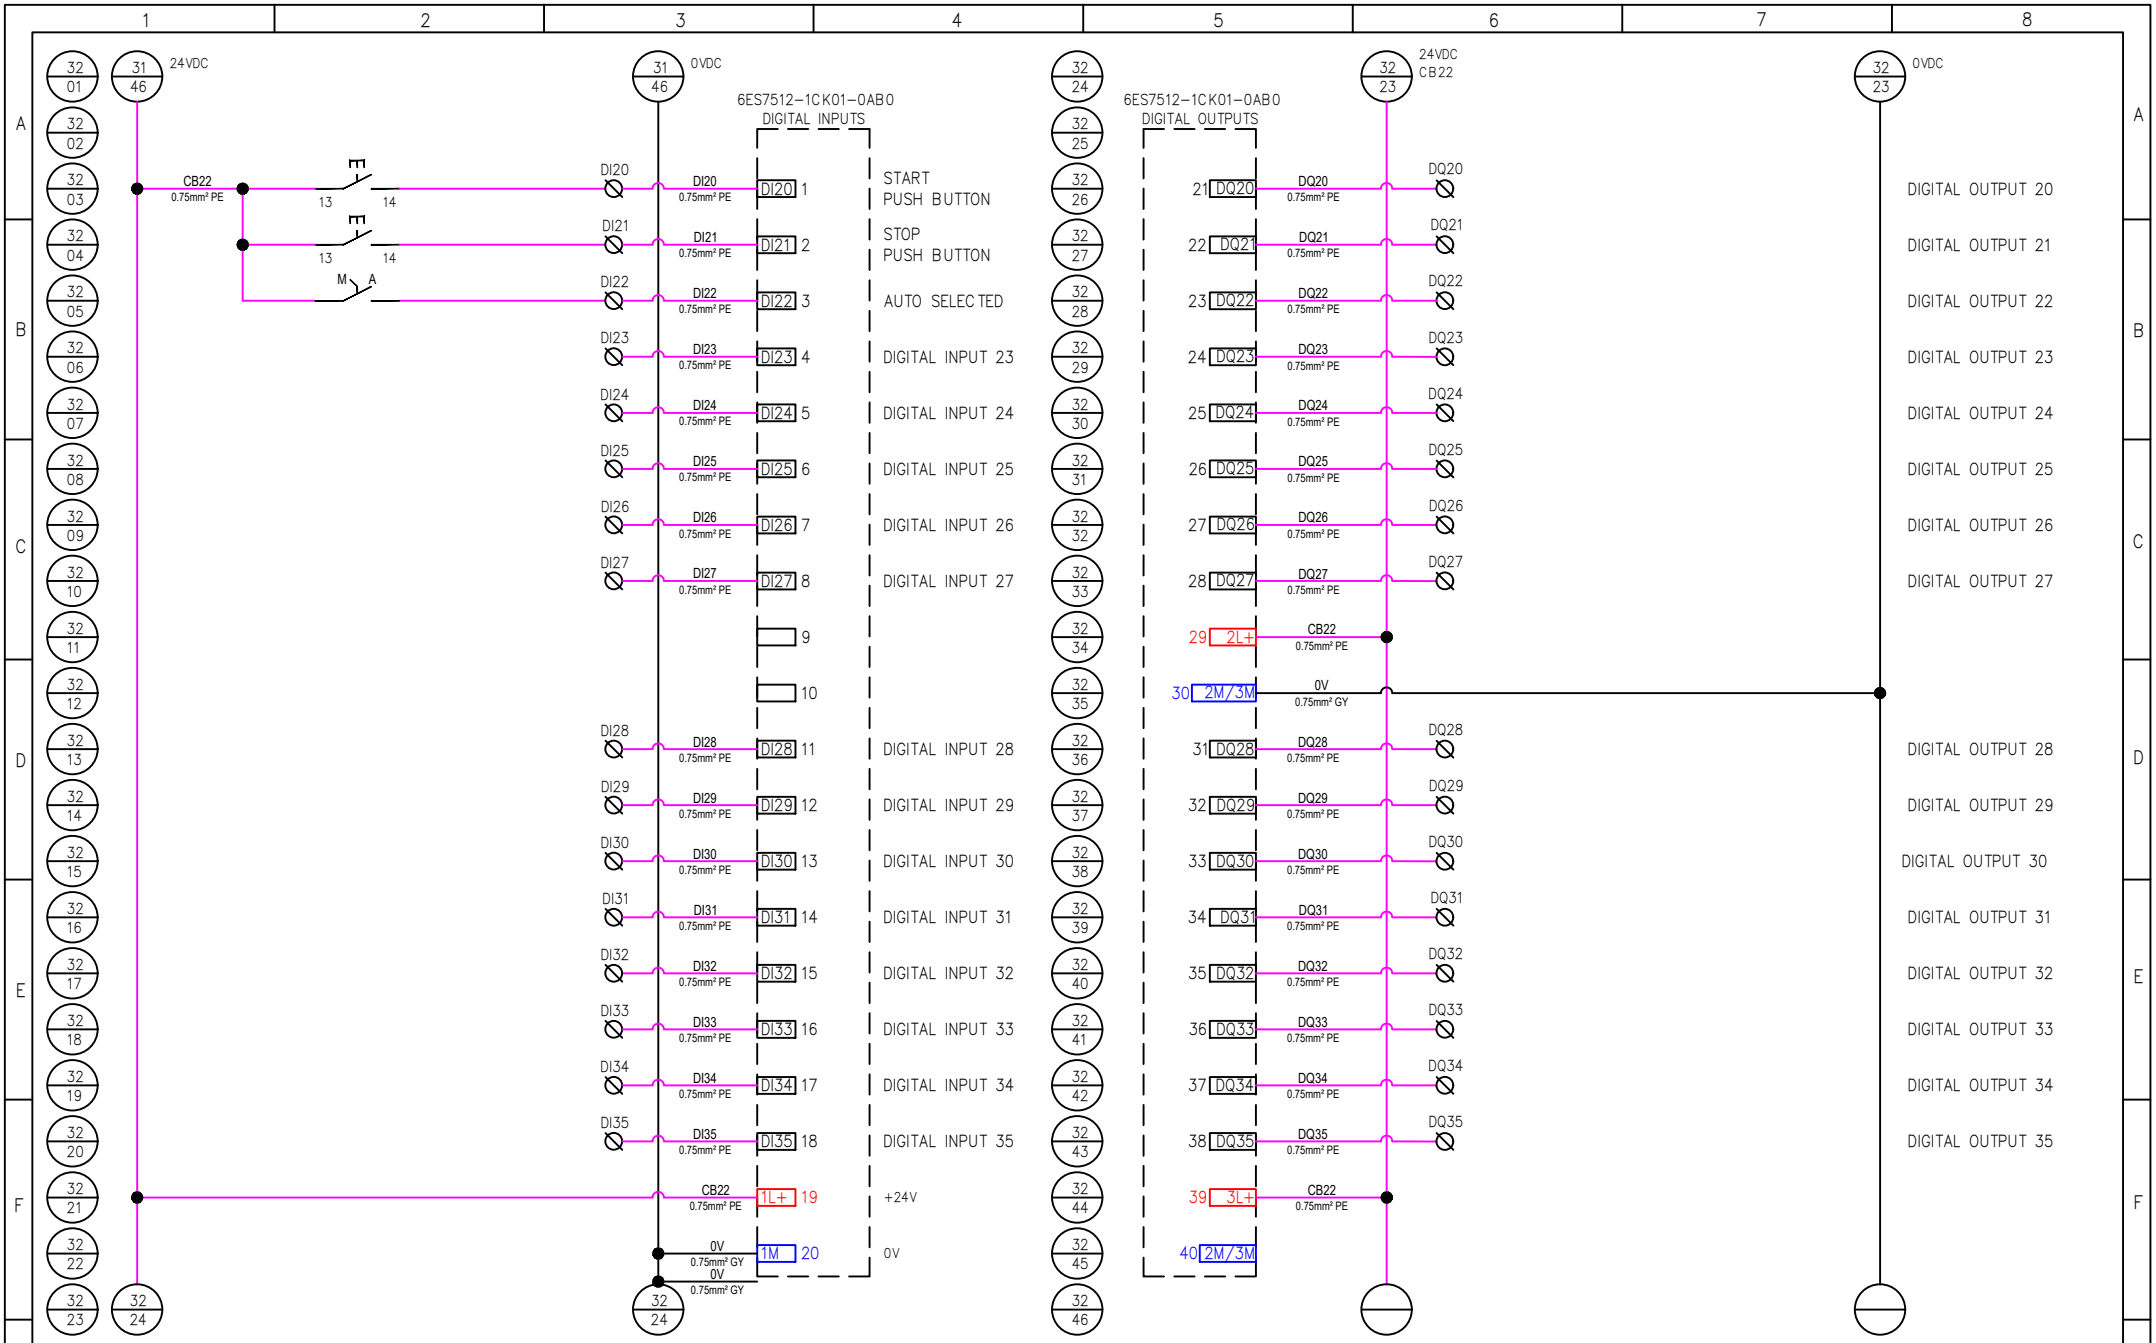

REV	DATE	DWN	CHK	APP	REVISION
A	28/08/26	D.B.	C.W.	C.W.	REVISION ONE, AS BUILT

THIS DRAWING IS OWNED BY FBS SOLUTIONS FOOD AND BEVERAGES AND IS ISSUED ON THE UNDERSTANDING THAT IT MAY NOT BE COPIED OR REPRODUCED IN WHOLE OR IN PART WITHOUT WRITTEN PERMISSION. NOR IS INFORMATION TO BE FURNISHED FROM WHICH COULD BE INJURIOUS TO THE ABOVE COMPANY

SCALE: NOT TO SCALE

	NAME	DATE
DRAWN	D. BORG	28/08/26
DESIGN	D. BORG	28/08/26
CHECKED	C. WHITELEY	28/08/26
APPROVED	C. WHITELEY	28/08/26

PROJECT: SCHLENKER 36/10

Serial No.: FBS Global Serial: 130039

FBS Solutions
45 Pelmet Cres, Thomastown VIC., Australia 3074
FOOD & BEVERAGE
Phone: +61 3 9191 2956
Contact: CLINT WHITELEY
Mobile: +61 418 383 441
E: enquiries@fbsglobal.com.au


DWG. NO.: 8001 A3

REVISION ONE, AS BUILT

SHEET TITLE: DIGITAL INPUTS/OUTPUTS

REVISION A

SHEET 32

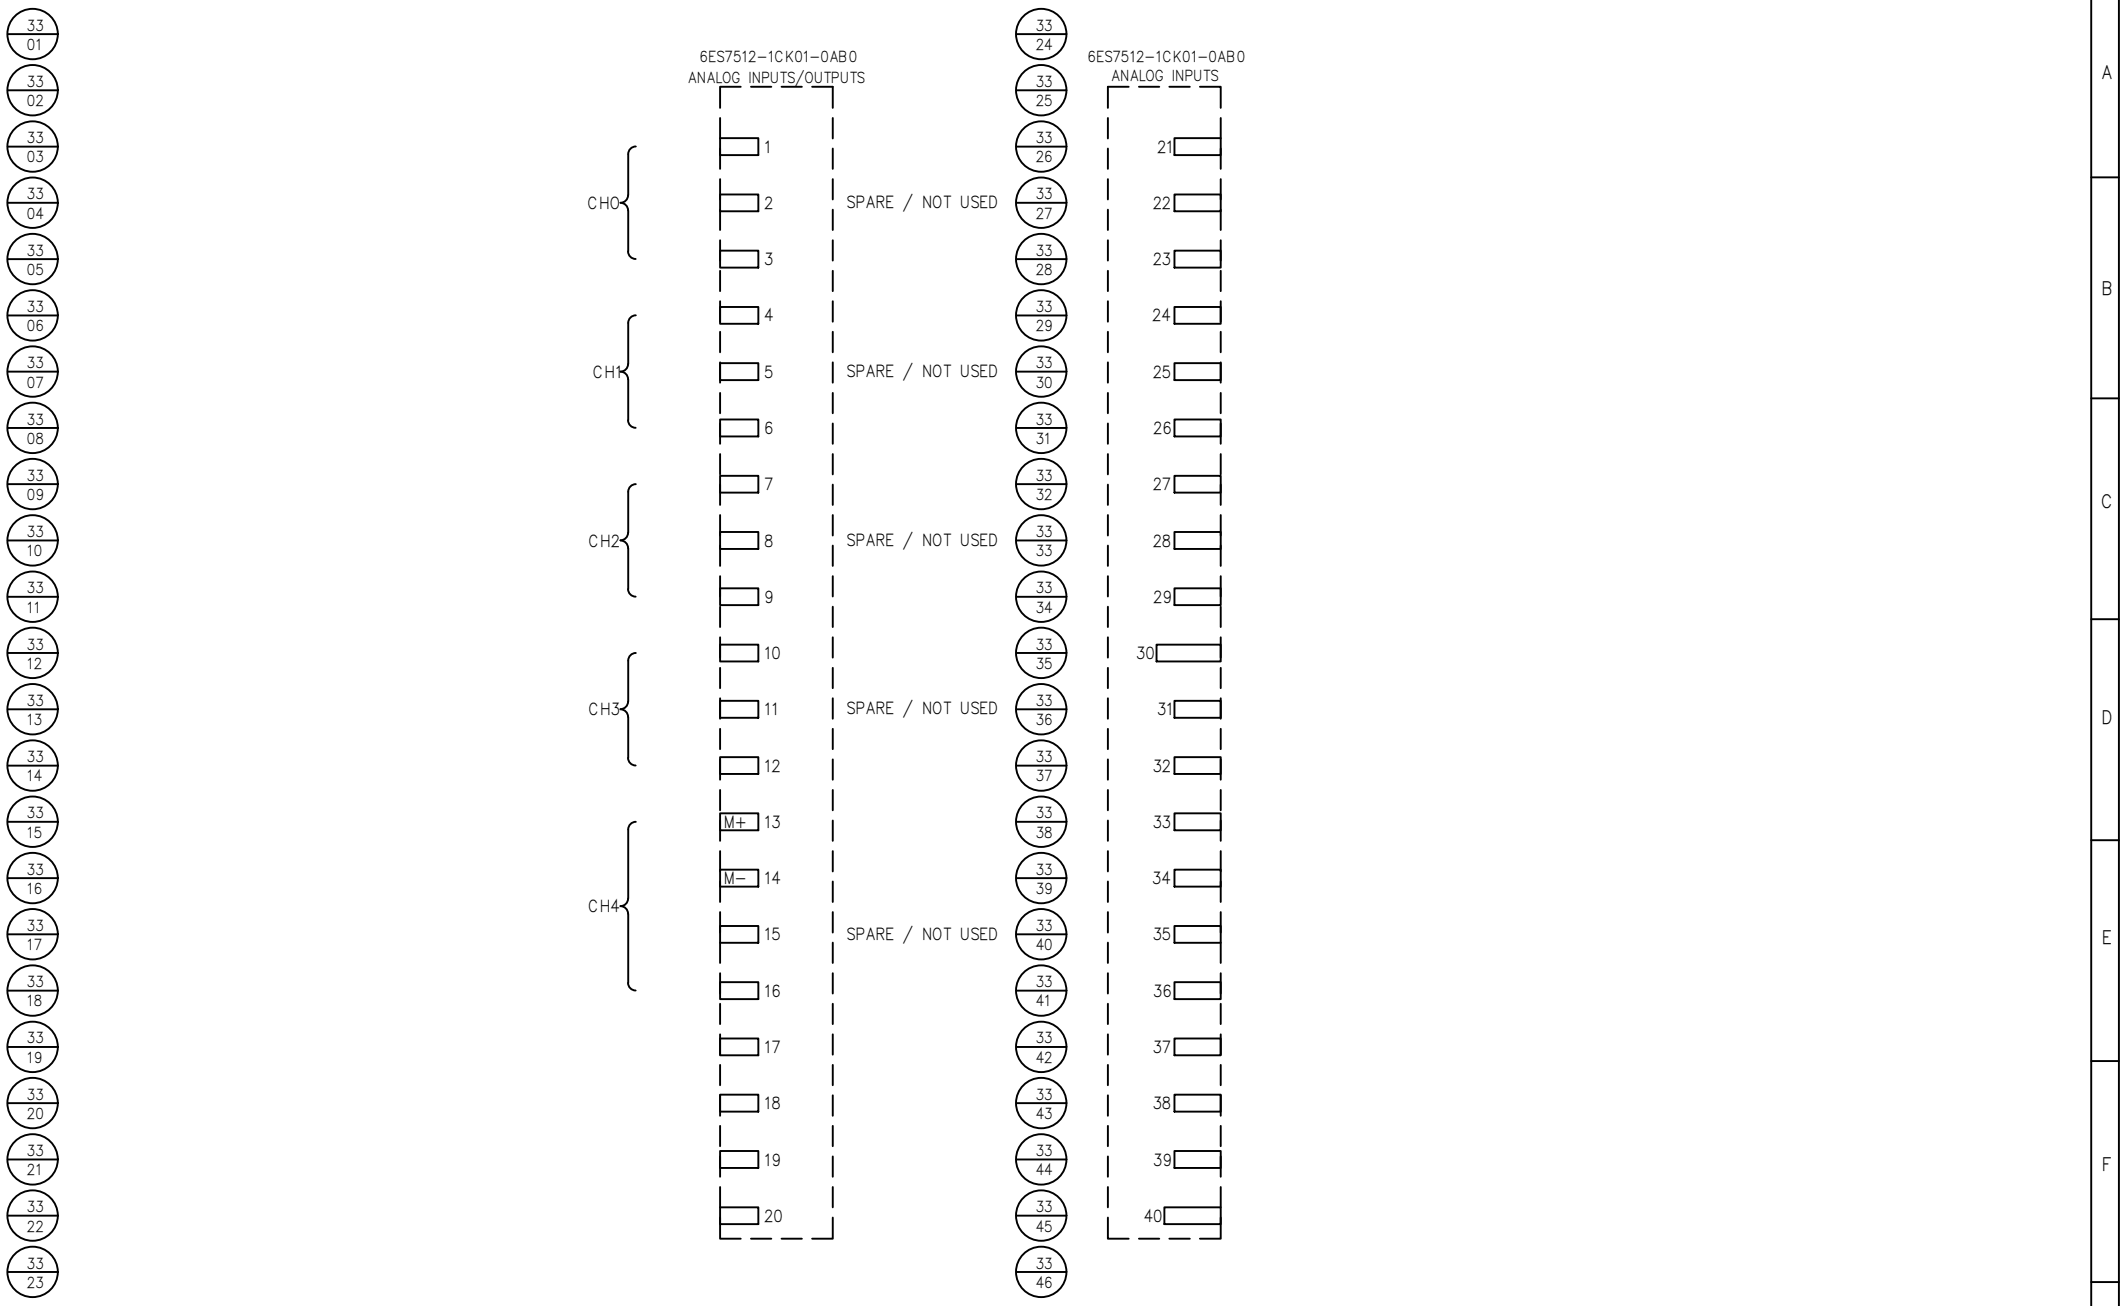

REV	DATE	DWN	CHK	APP	REVISION
A	28/08/26	D.B.	C.W.	C.W.	REVISION ONE, AS BUILT

THIS DRAWING IS OWNED BY FBS SOLUTIONS FOOD AND BEVERAGES AND IS ISSUED ON THE UNDERSTANDING THAT IT MAY NOT BE COPIED OR REPRODUCED IN WHOLE OR IN PART WITHOUT WRITTEN PERMISSION. NOR IS INFORMATION TO BE FURNISHED FROM WHICH COULD BE INJURIOUS TO THE ABOVE COMPANY

SCALE: NOT TO SCALE

	NAME	DATE
DRAWN	D. BORG	28/08/26
DESIGN	D. BORG	28/08/26
CHECKED	C. WHITELEY	28/08/26
APPROVED	C. WHITELEY	28/08/26

PROJECT: SCHLENKER 36/10

Serial No.: FBS Global Serial: 130039

FBS Solutions
45 Pelmet Cres, Thomastown VIC., Australia 3074
FOOD & BEVERAGE
Phone: +61 3 9191 2956
Contact: CLINT WHITELEY
Mobile: +61 418 383 441
E: enquiries@fbsglobal.com.au


DWG. NO.: 8001 A3

REVISION ONE, AS BUILT

SHEET TITLE: ANALOG INPUTS/OUTPUTS

REVISION A

SHEET 33

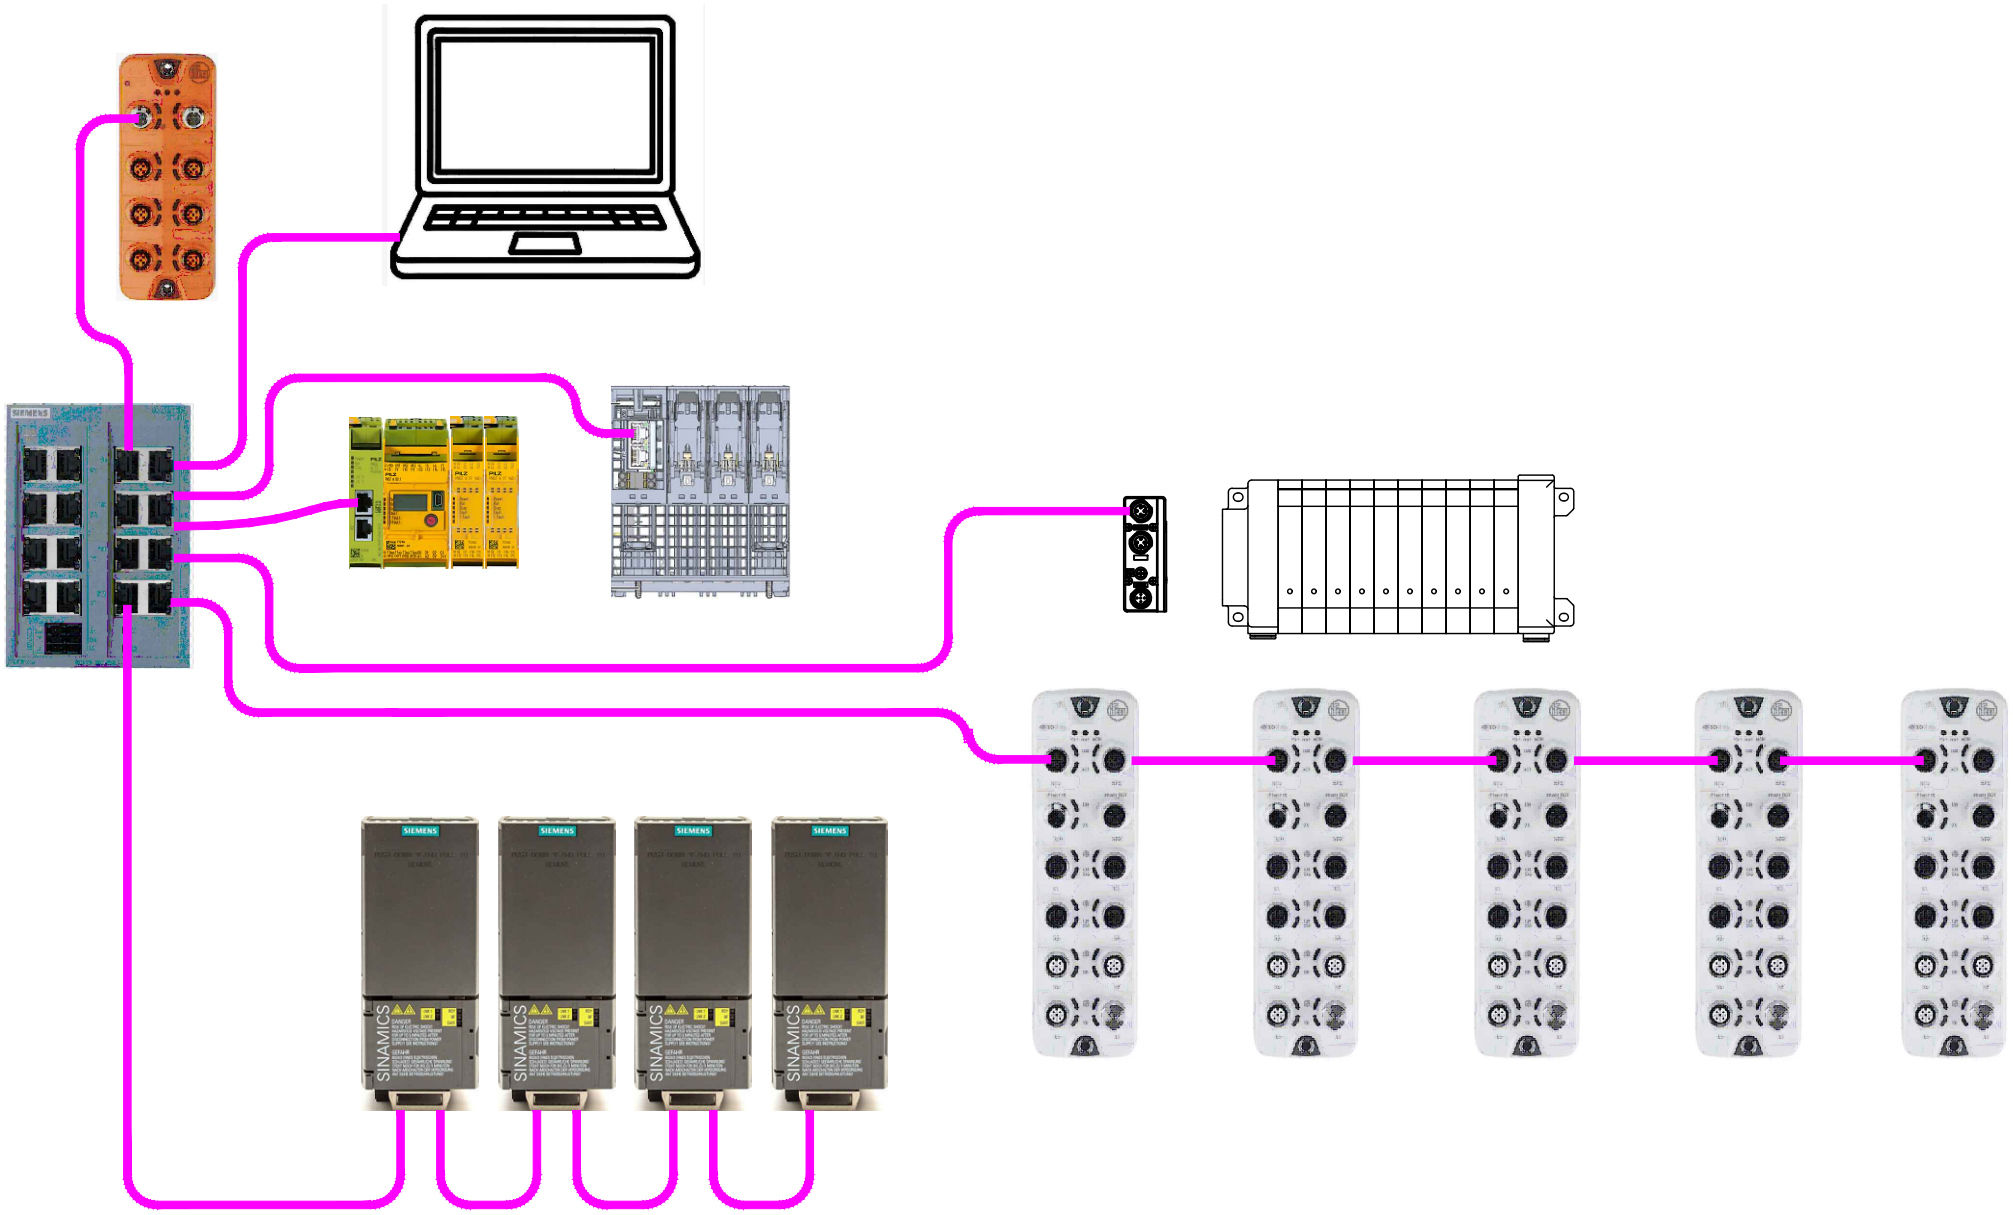

REV	DATE	DWN	CHK	APP	REVISION
E					
D					
C					
B					
A	28/08/26	D.B.	C.W.	C.W.	REVISION ONE, AS BUILT

THIS DRAWING IS OWNED BY FBS SOLUTIONS FOOD AND BEVERAGES AND IS ISSUED ON THE UNDERSTANDING THAT IT MAY NOT BE COPIED OR REPRODUCED IN WHOLE OR IN PART WITHOUT WRITTEN PERMISSION. NOR IS INFORMATION TO BE FURNISHED FROM WHICH COULD BE INJURIOUS TO THE ABOVE COMPANY

SCALE: NOT TO SCALE

	NAME	DATE
DRAWN	D. BORG	28/08/26
DESIGN	D. BORG	28/08/26
CHECKED	C. WHITELEY	28/08/26
APPROVED	C. WHITELEY	28/08/26

PROJECT: SCHLENKER 36/10

Serial No.: FBS Global Serial: 130039

FBS Solutions
45 Pelmet Cres, Thomastown VIC., Australia 3074
FOOD & BEVERAGE
Phone: +61 3 9191 2956
Contact: CLINT WHITELEY
Mobile: +61 418 383 441
E: enquiries@fbsglobal.com.au

DWG. NO.: 8001 A3


REVISION ONE, AS BUILT

SHEET TITLE: NETWORK TYPOLOGY

REVISION A

SHEET 40

AL100
BOTTLE AND ACCUMULATION SENSORS

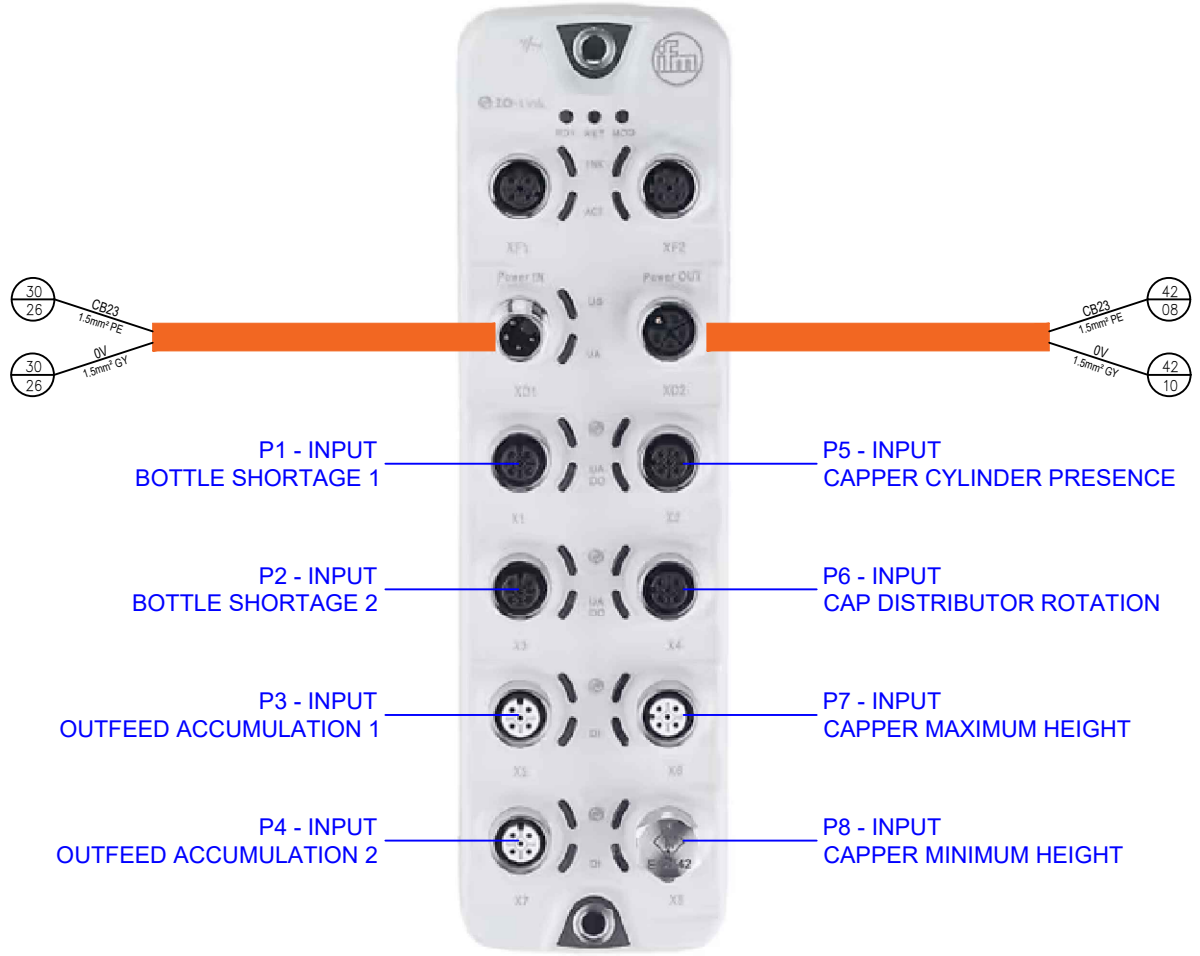

REV	DATE	DWN	CHK	APP	REVISION
E					
D					
C					
B					
A	28/08/26	D.B.	C.W.	C.W.	REVISION ONE, AS BUILT

THIS DRAWING IS OWNED BY FBS SOLUTIONS FOOD AND BEVERAGES AND IS ISSUED ON THE UNDERSTANDING THAT IT MAY NOT BE COPIED OR REPRODUCED IN WHOLE OR IN PART WITHOUT WRITTEN PERMISSION. NOR IS INFORMATION TO BE FURNISHED FROM WHICH COULD BE INJURIOUS TO THE ABOVE COMPANY

SCALE: NOT TO SCALE

	NAME	DATE
DRAWN	D. BORG	28/08/26
DESIGN	D. BORG	28/08/26
CHECKED	C. WHITELEY	28/08/26
APPROVED	C. WHITELEY	28/08/26

PROJECT: SCHLENKER 36/10

Serial No.: FBS Global Serial: 130039

FBS Solutions
45 Pelmet Cres, Thomastown VIC., Australia 3074
FOOD & BEVERAGE
Phone: +61 3 9191 2956
Contact: CLINT WHITELEY
Mobile: +61 418 383 441
E: enquiries@fbsglobal.com.au

DWG. NO.: 8001 A3


REVISION ONE, AS BUILT

SHEET TITLE: FIELD SENSORS

REVISION A

SHEET 41

AL101
CAP SYSTEM AND AIR PRESSURE

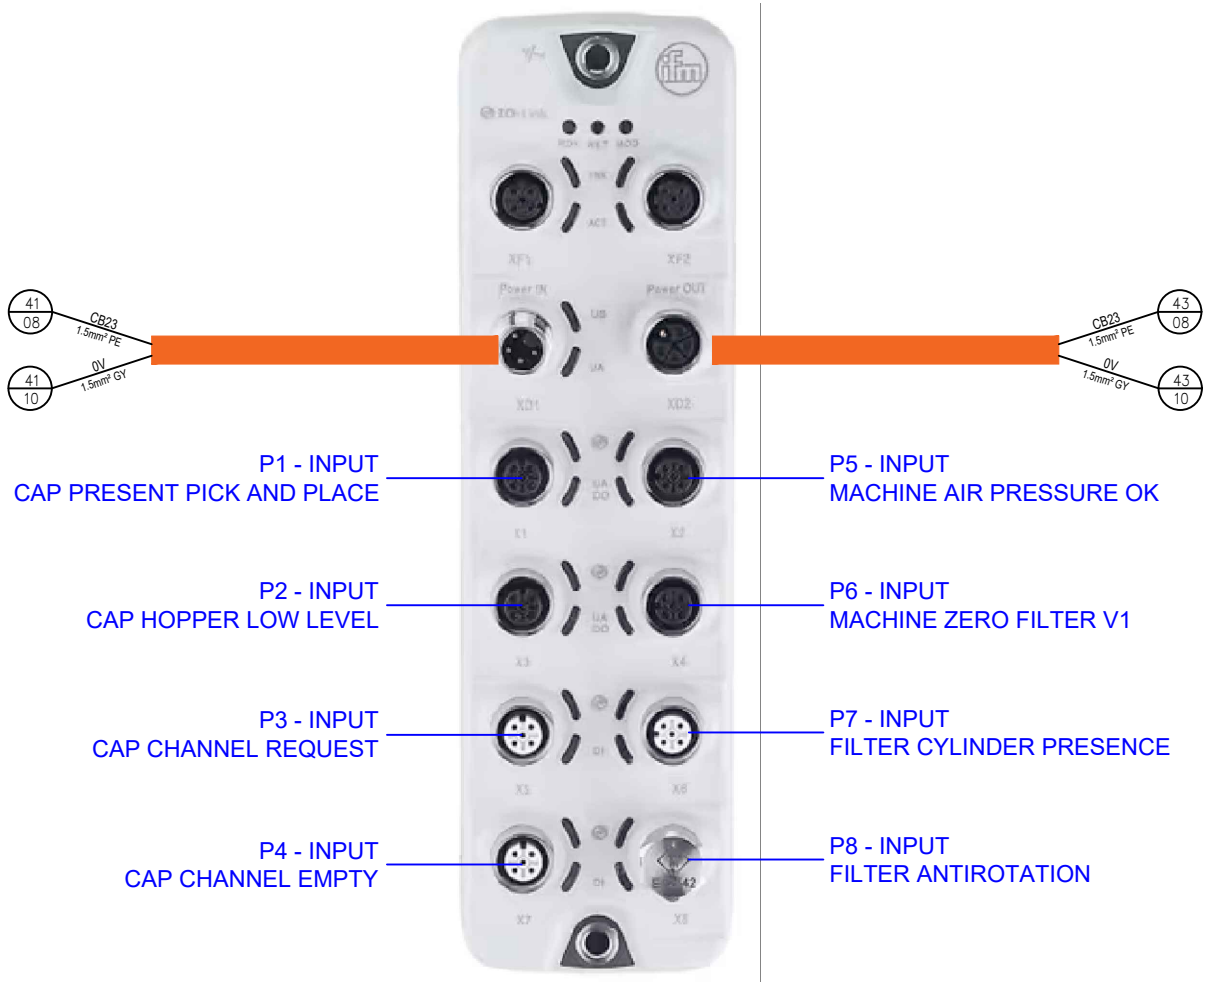

REV	DATE	DWN	CHK	APP	REVISION
E					
D					
C					
B					
A	28/08/26	D.B.	C.W.	C.W.	REVISION ONE, AS BUILT

THIS DRAWING IS OWNED BY FBS SOLUTIONS FOOD AND BEVERAGES AND IS ISSUED ON THE UNDERSTANDING THAT IT MAY NOT BE COPIED OR REPRODUCED IN WHOLE OR IN PART WITHOUT WRITTEN PERMISSION. NOR IS INFORMATION TO BE FURNISHED FROM WHICH COULD BE INJURIOUS TO THE ABOVE COMPANY

SCALE: NOT TO SCALE

	NAME	DATE
DRAWN	D. BORG	28/08/26
DESIGN	D. BORG	28/08/26
CHECKED	C. WHITELEY	28/08/26
APPROVED	C. WHITELEY	28/08/26

PROJECT: SCHLENKER 36/10

Serial No.: FBS Global Serial: 130039

FBS Solutions
45 Pelmet Cres, Thomastown VIC., Australia 3074
FOOD & BEVERAGE
Phone: +61 3 9191 2956
Contact: CLINT WHITELEY
Mobile: +61 418 383 441
E: enquiries@fbsglobal.com.au

DWG. NO.: 8001 A3


REVISION ONE, AS BUILT

SHEET TITLE: FIELD SENSORS

REVISION A

SHEET 42

AL102
PROCESS INSTRUMENTATION

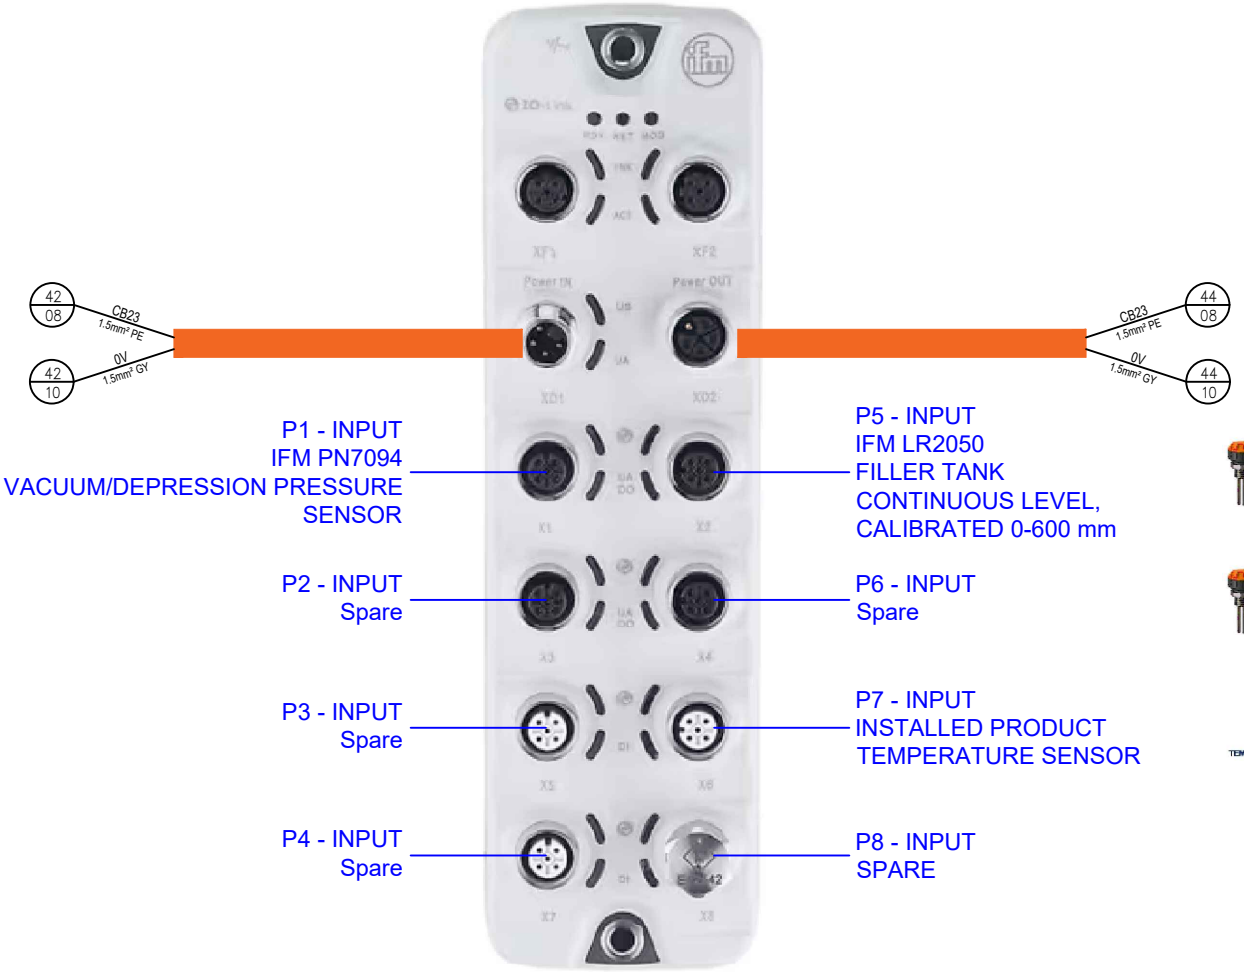

REV	DATE	DWN	CHK	APP	REVISION
E					
D					
C					
B					
A	28/08/26	D.B.	C.W.	C.W.	REVISION ONE, AS BUILT

THIS DRAWING IS OWNED BY FBS SOLUTIONS FOOD AND BEVERAGES AND IS ISSUED ON THE UNDERSTANDING THAT IT MAY NOT BE COPIED OR REPRODUCED IN WHOLE OR IN PART WITHOUT WRITTEN PERMISSION. NOR IS INFORMATION TO BE FURNISHED FROM WHICH COULD BE INJURIOUS TO THE ABOVE COMPANY

SCALE: NOT TO SCALE

	NAME	DATE
DRAWN	D. BORG	28/08/26
DESIGN	D. BORG	28/08/26
CHECKED	C. WHITELEY	28/08/26
APPROVED	C. WHITELEY	28/08/26

PROJECT: SCHLENKER 36/10

Serial No.: FBS Global Serial: 130039

FBS Solutions
45 Pelmet Cres, Thomastown VIC., Australia 3074
FOOD & BEVERAGE
Phone: +61 3 9191 2956
Contact: CLINT WHITELEY
Mobile: +61 418 383 441
E: enquiries@fbsglobal.com.au

DWG. NO.: 8001 A3


REVISION ONE, AS BUILT

SHEET TITLE: FIELD SENSORS

REVISION A

SHEET 43

AL103

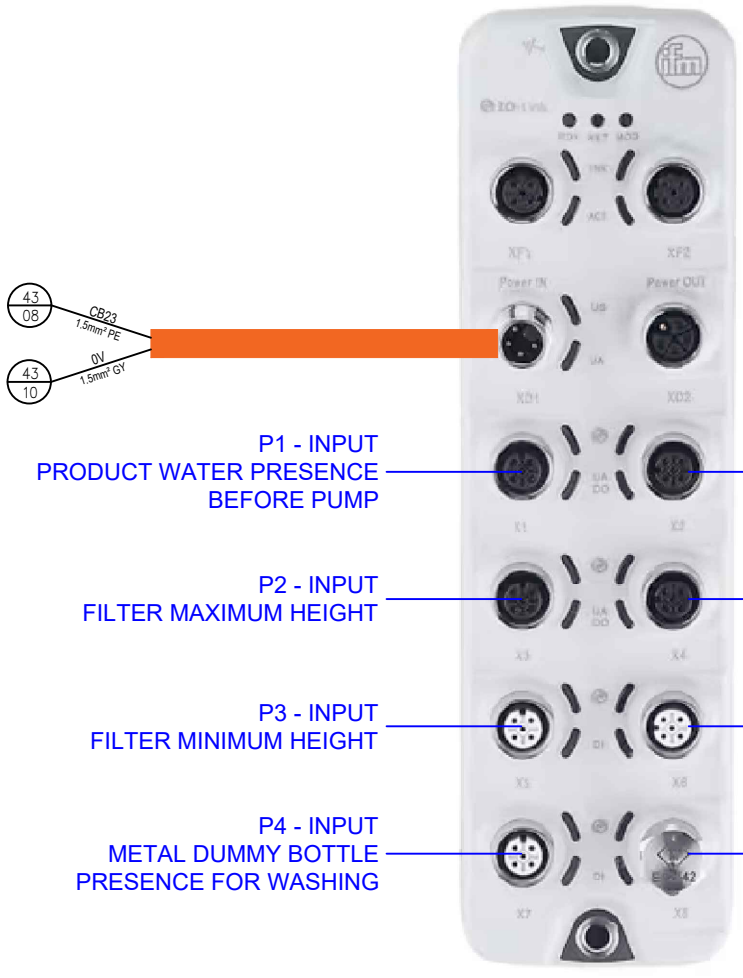

REV	DATE	DWN	CHK	APP	REVISION
E					
D					
C					
B					
A	28/08/26	D.B.	C.W.	C.W.	REVISION ONE, AS BUILT

THIS DRAWING IS OWNED BY FBS SOLUTIONS FOOD AND BEVERAGES AND IS ISSUED ON THE UNDERSTANDING THAT IT MAY NOT BE COPIED OR REPRODUCED IN WHOLE OR IN PART WITHOUT WRITTEN PERMISSION. NOR IS INFORMATION TO BE FURNISHED FROM WHICH COULD BE INJURIOUS TO THE ABOVE COMPANY

SCALE: NOT TO SCALE

	NAME	DATE
DRAWN	D. BORG	28/08/26
DESIGN	D. BORG	28/08/26
CHECKED	C. WHITELEY	28/08/26
APPROVED	C. WHITELEY	28/08/26

PROJECT: SCHLENKER 36/10

Serial No.: FBS Global Serial: 130039

FBS Solutions
45 Pelmet Cres, Thomastown VIC., Australia 3074
FOOD & BEVERAGE
Phone: +61 3 9191 2956
Contact: CLINT WHITELEY
Mobile: +61 418 383 441
E: enquiries@fbsglobal.com.au

DWG. NO.: 8001 A3


REVISION ONE, AS BUILT

SHEET TITLE: FIELD SENSORS

REVISION A

SHEET 44

AL104

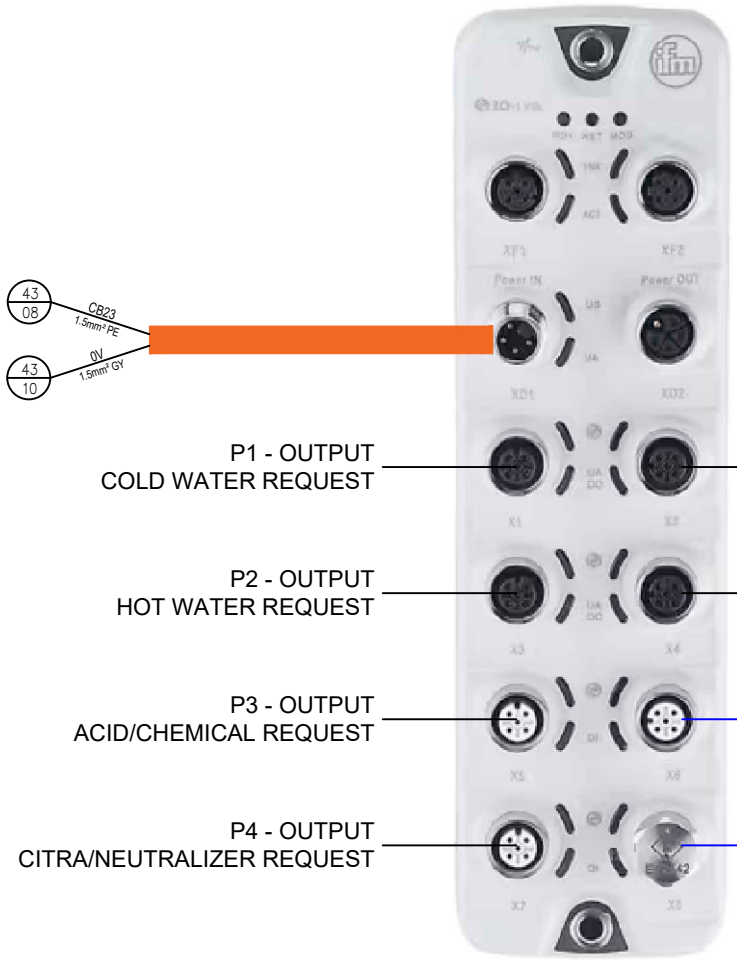

REV	DATE	DWN	CHK	APP	REVISION
E					
D					
C					
B					
A	28/08/26	D.B.	C.W.	C.W.	REVISION ONE, AS BUILT

THIS DRAWING IS OWNED BY FBS SOLUTIONS FOOD AND BEVERAGES AND IS ISSUED ON THE UNDERSTANDING THAT IT MAY NOT BE COPIED OR REPRODUCED IN WHOLE OR IN PART WITHOUT WRITTEN PERMISSION. NOR IS INFORMATION TO BE FURNISHED FROM WHICH COULD BE INJURIOUS TO THE ABOVE COMPANY

SCALE: NOT TO SCALE

	NAME	DATE
DRAWN	D. BORG	28/08/26
DESIGN	D. BORG	28/08/26
CHECKED	C. WHITELEY	28/08/26
APPROVED	C. WHITELEY	28/08/26

PROJECT: SCHLENKER 36/10

Serial No.: FBS Global Serial: 130039

FBS Solutions
45 Pelmet Cres, Thomastown VIC., Australia 3074
FOOD & BEVERAGE
Phone: +61 3 9191 2956
Contact: CLINT WHITELEY
Mobile: +61 418 383 441
E: enquiries@fbsglobal.com.au

DWG. NO.: 8001 A3


REVISION ONE, AS BUILT


SHEET TITLE: FIELD COMPONENTS

REVISION A

SHEET 45

ANYBUS
SMC EX260

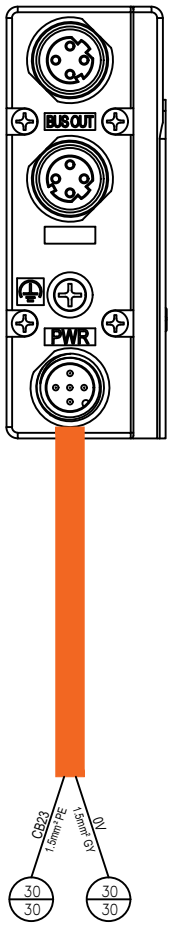

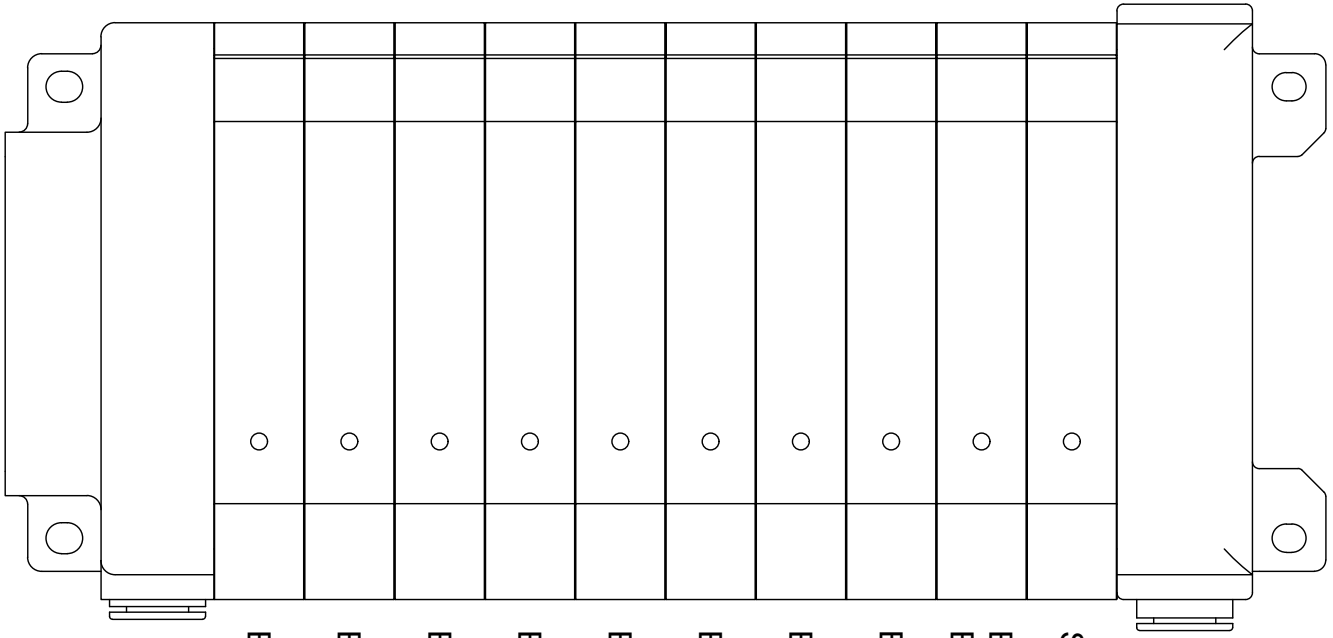

EV010 - PRODUCT INLET
EV011 - PRODUCT SHUTOFF
EV210 - VACUUM AFTER PUMP
EV211 - VACUUM IN PUMP
EV212 - VACUUM BEFORE PUMP
EV220 - CAP DISTRIBUTOR AIR
EV221 - CAP CHANNEL AIR
BOTTLE WASH PNEUMATIC ENABLE
EV001 CLOSE INFEED GATE
EV001 - OPEN INFEED GATE
SPARE

REV	DATE	DWN	CHK	APP	REVISION
E					
D					
C					
B					
A	28/08/26	D.B.	C.W.	C.W.	REVISION ONE, AS BUILT

THIS DRAWING IS OWNED BY FBS SOLUTIONS FOOD AND BEVERAGES AND IS ISSUED ON THE UNDERSTANDING THAT IT MAY NOT BE COPIED OR REPRODUCED IN WHOLE OR IN PART WITHOUT WRITTEN PERMISSION. NOR IS INFORMATION TO BE FURNISHED FROM WHICH COULD BE INJURIOUS TO THE ABOVE COMPANY

SCALE: NOT TO SCALE

	NAME	DATE
DRAWN	D. BORG	28/08/26
DESIGN	D. BORG	28/08/26
CHECKED	C. WHITELEY	28/08/26
APPROVED	C. WHITELEY	28/08/26

PROJECT: SCHLENKER 36/10

Serial No.: FBS Global Serial: 130039

FBS Solutions
45 Pelmet Cres, Thomastown VIC., Australia 3074
FOOD & BEVERAGE
Phone: +61 3 9191 2956
Contact: CLINT WHITELEY
Mobile: +61 418 383 441
E: enquiries@fbsglobal.com.au

DWG. NO.: 8001 A3


REVISION ONE, AS BUILT

SHEET TITLE: FIELD SOLENOIDS

REVISION A

SHEET 46

IO-Link CompactLine module AL2330

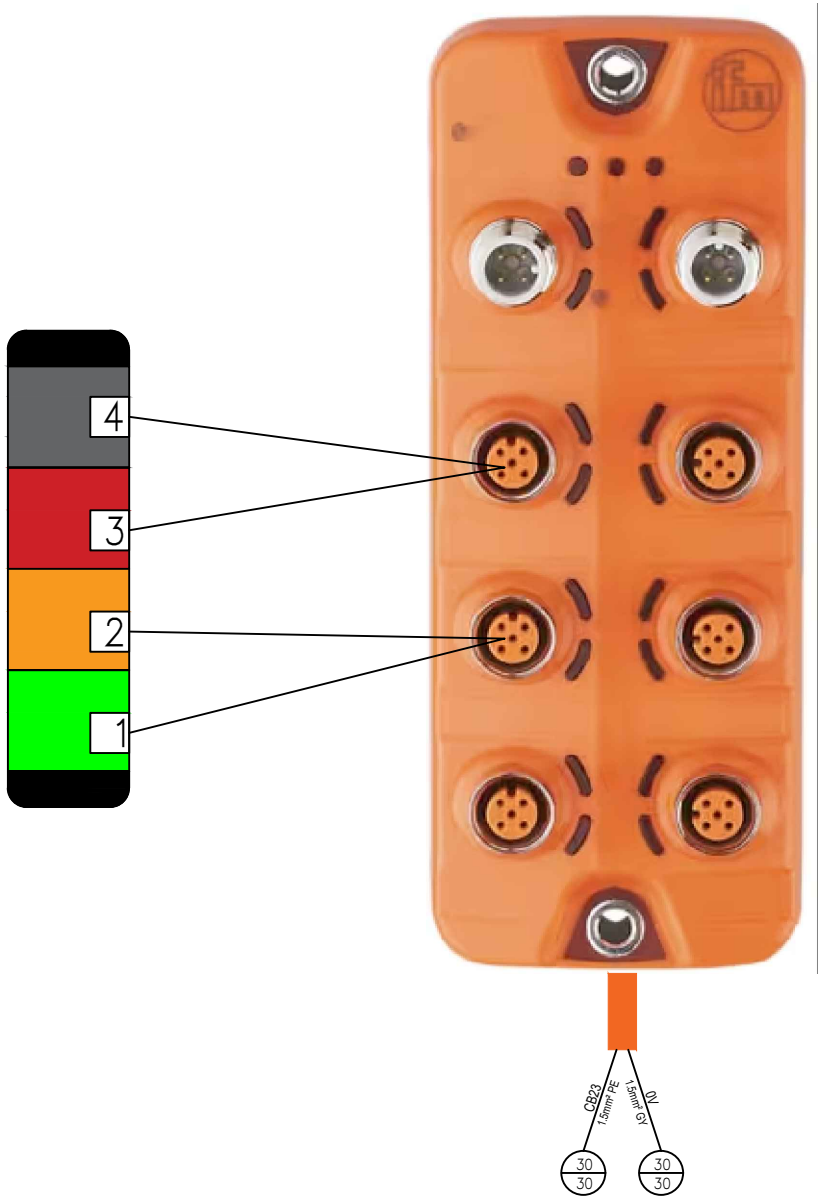

M12 Port & Pinout Wiring Structure

- Outputs (Ports X1.0 to X1.5 - M12, A-coded, 4-pin):
  - Pin 1: Not used
  - Pin 2: Digital Output 2 (DO2)
  - Pin 3: Ground (GND / UA)
  - Pin 4: Digital Output 1 (DO1)
  - Pin 5: Not used

REV	DATE	DWN	CHK	APP	REVISION
E					
D					
C					
B					
A	28/08/26	D.B.	C.W.	C.W.	REVISION ONE, AS BUILT

THIS DRAWING IS OWNED BY FBS SOLUTIONS FOOD AND BEVERAGES AND IS ISSUED ON THE UNDERSTANDING THAT IT MAY NOT BE COPIED OR REPRODUCED IN WHOLE OR IN PART WITHOUT WRITTEN PERMISSION. NOR IS INFORMATION TO BE FURNISHED FROM WHICH COULD BE INJURIOUS TO THE ABOVE COMPANY

SCALE: NOT TO SCALE

	NAME	DATE
DRAWN	D. BORG	28/08/26
DESIGN	D. BORG	28/08/26
CHECKED	C. WHITELEY	28/08/26
APPROVED	C. WHITELEY	28/08/26

PROJECT: SCHLENKER 36/10

Serial No.: FBS Global Serial: 130039

FBS Solutions
45 Pelmet Cres, Thomastown VIC., Australia 3074
FOOD & BEVERAGE
Phone: +61 3 9191 2956
Contact: CLINT WHITELEY
Mobile: +61 418 383 441
E: enquiries@fbsglobal.com.au

DWG. NO.: 8001 A3

REVISION ONE, AS BUILT

SHEET TITLE: FIELD COMPONENTS

REVISION A

SHEET 47