FBS Global

SCHLENKER 36/10
Filling and Capping Line
FBS Global Serial: 130039

ELECTRICAL DRAWINGS

REV	DATE	DWN	CHK	APP	REVISION
E					
D					
C					
B					
A	28/08/26	D.B.	C.W.	C.W.	REVISION ONE, AS BUILT

THIS DRAWING IS OWNED BY FBS SOLUTIONS FOOD AND BEVERAGES AND IS ISSUED ON THE UNDERSTANDING THAT IT MAY NOT BE COPIED OR REPRODUCED IN WHOLE OR IN PART WITHOUT WRITTEN PERMISSION. NOR IS INFORMATION TO BE FURNISHED FROM WHICH COULD BE INJURIOUS TO THE ABOVE COMPANY

SCALE: NOT TO SCALE

	NAME	DATE
DRAWN	D. BORG	28/08/26
DESIGN	D. BORG	28/08/26
CHECKED	C. WHITELEY	28/08/26
APPROVED	C. WHITELEY	28/08/26

PROJECT: SCHLENKER 36/10

Serial No.: FBS Global Serial: 130039

FBS Solutions
45 Pelmet Cres, Thomastown VIC., Australia 3074
FOOD & BEVERAGE
Phone: +61 3 9191 2956
Contact: CLINT WHITELEY
Mobile: +61 418 383 441
E: enquiries@fbsglobal.com.au


DWG. NO.: 8001 A3


REVISION ONE, AS BUILT

SHEET TITLE: COVER

REVISION A

COVER

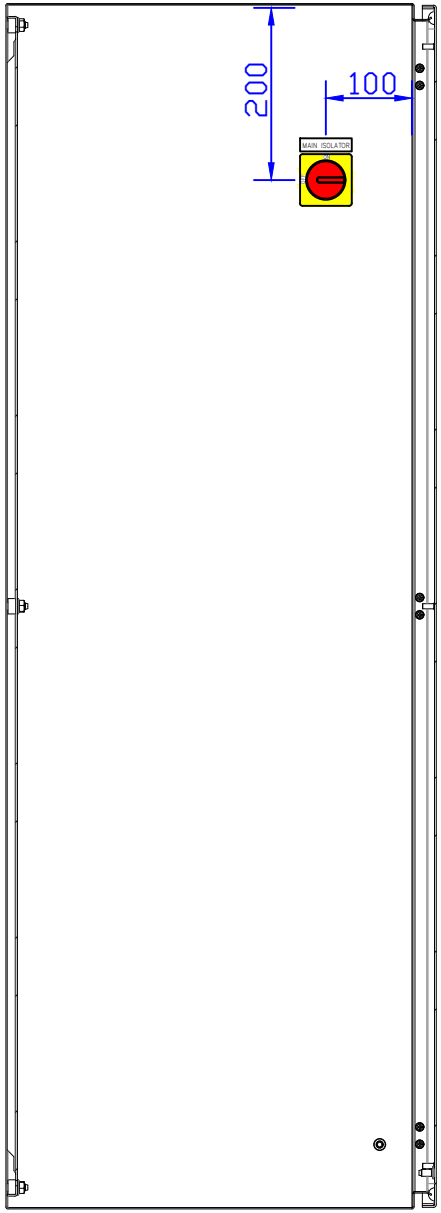

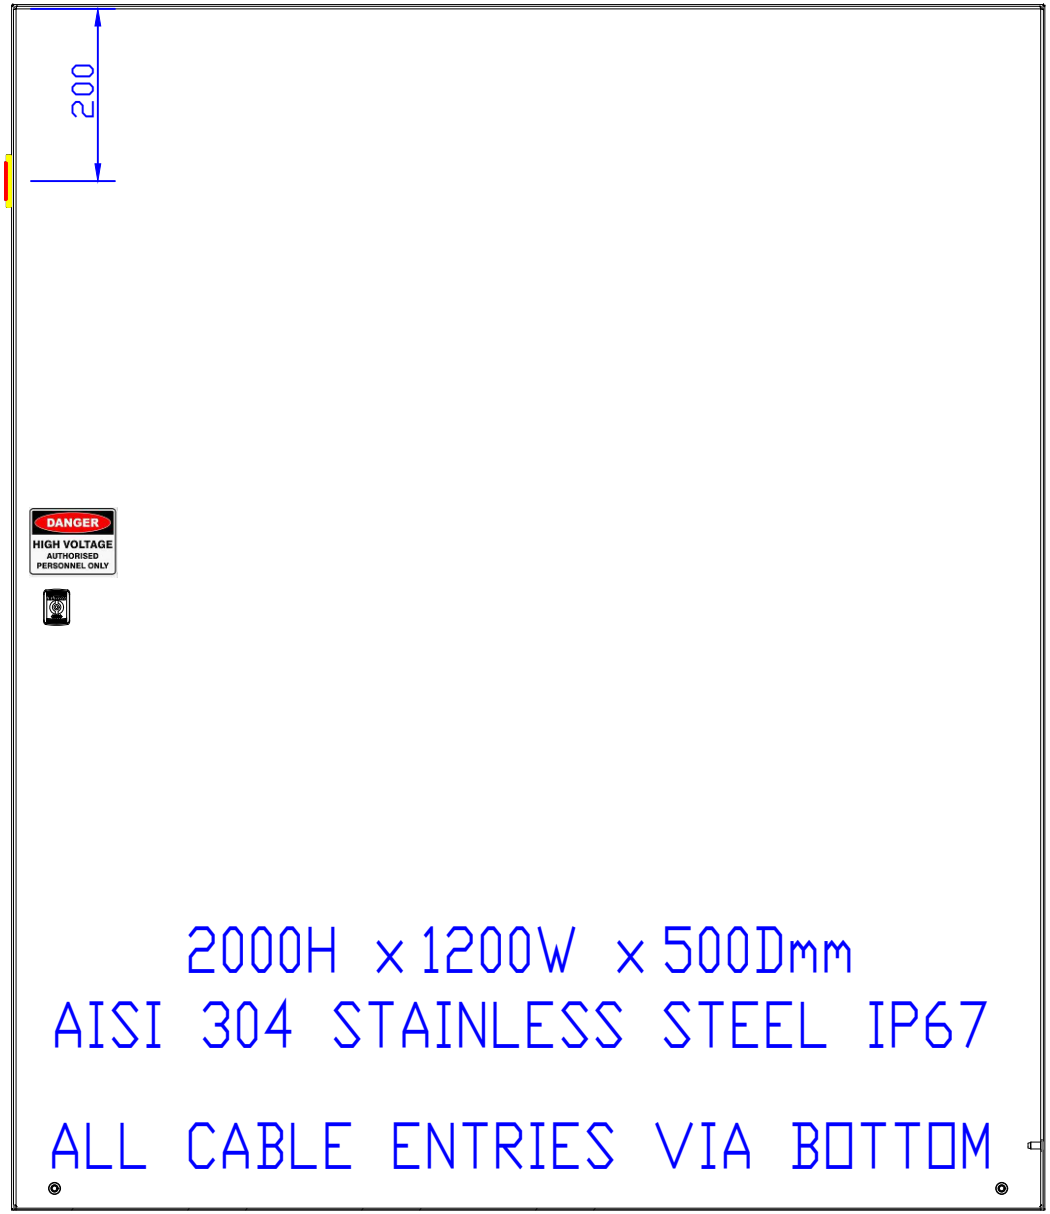

2000H x 1200W x 500Dmm
AISI 304 STAINLESS STEEL IP67

ALL CABLE ENTRIES VIA BOTTOM

REV	DATE	DWN	CHK	APP	REVISION
E					
D					
C					
B					
A	28/08/26	D.B.	C.W.	C.W.	REVISION ONE, AS BUILT

THIS DRAWING IS OWNED BY FBS SOLUTIONS FOOD AND BEVERAGES AND IS ISSUED ON THE UNDERSTANDING THAT IT MAY NOT BE COPIED OR REPRODUCED IN WHOLE OR IN PART WITHOUT WRITTEN PERMISSION. NOR IS INFORMATION TO BE FURNISHED FROM WHICH COULD BE INJURIOUS TO THE ABOVE COMPANY

SCALE: NOT TO SCALE

	NAME	DATE
DRAWN	D. BORG	28/08/26
DESIGN	D. BORG	28/08/26
CHECKED	C. WHITELEY	28/08/26
APPROVED	C. WHITELEY	28/08/26

PROJECT: SCHLENKER 36/10

Serial No.: FBS Global Serial: 130039

FBS Solutions
45 Pelmet Cres, Thomastown VIC., Australia 3074
FOOD & BEVERAGE
Phone: +61 3 9191 2956
Contact: CLINT WHITELEY
Mobile: +61 418 383 441
E: enquiries@fbsglobal.com.au


DWG. NO.: 8001 A3

REVISION ONE, AS BUILT

SHEET TITLE: MAIN CONTROL PANEL

REVISION A

SHEET 1

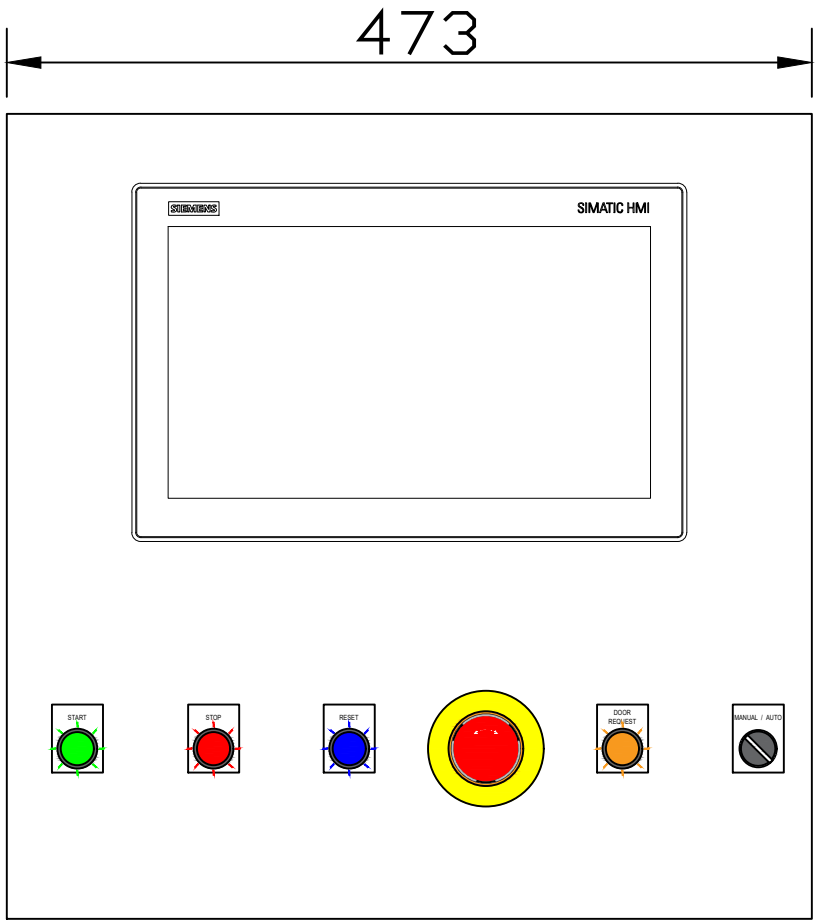



HAND HELD
MANUAL JOG PENDANT

REV	DATE	DWN	CHK	APP	REVISION
E					
D					
C					
B					
A	28/08/26	D.B.	C.W.	C.W.	REVISION ONE, AS BUILT

THIS DRAWING IS OWNED BY FBS SOLUTIONS FOOD AND BEVERAGES AND IS ISSUED ON THE UNDERSTANDING THAT IT MAY NOT BE COPIED OR REPRODUCED IN WHOLE OR IN PART WITHOUT WRITTEN PERMISSION. NOR IS INFORMATION TO BE FURNISHED FROM WHICH COULD BE INJURIOUS TO THE ABOVE COMPANY

SCALE: NOT TO SCALE

	NAME	DATE
DRAWN	D. BORG	28/08/26
DESIGN	D. BORG	28/08/26
CHECKED	C. WHITELEY	28/08/26
APPROVED	C. WHITELEY	28/08/26

PROJECT: SCHLENKER 36/10

Serial No.: FBS Global Serial: 130039

FBS Solutions
45 Pelmet Cres, Thomastown VIC., Australia 3074
FOOD & BEVERAGE
Phone: +61 3 9191 2956
Contact: CLINT WHITELEY
Mobile: +61 418 383 441
E: enquiries@fbsglobal.com.au


DWG. NO.: 8001 A3


REVISION ONE, AS BUILT

SHEET TITLE: OPERATOR CONSOLE

REVISION A

SHEET 2

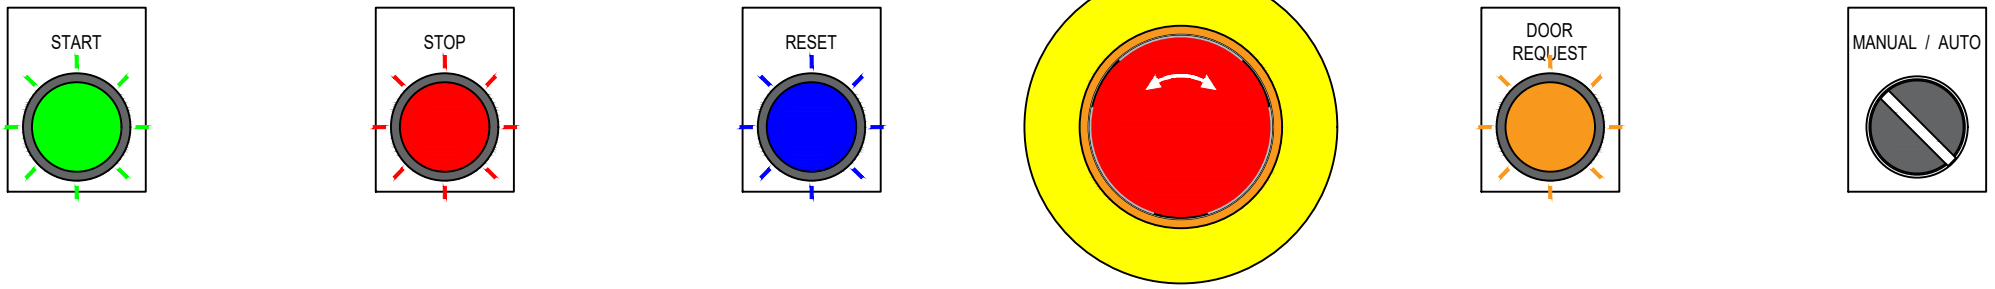
START
STOP
RESET
DOOR
REQUEST
MANUAL / AUTO

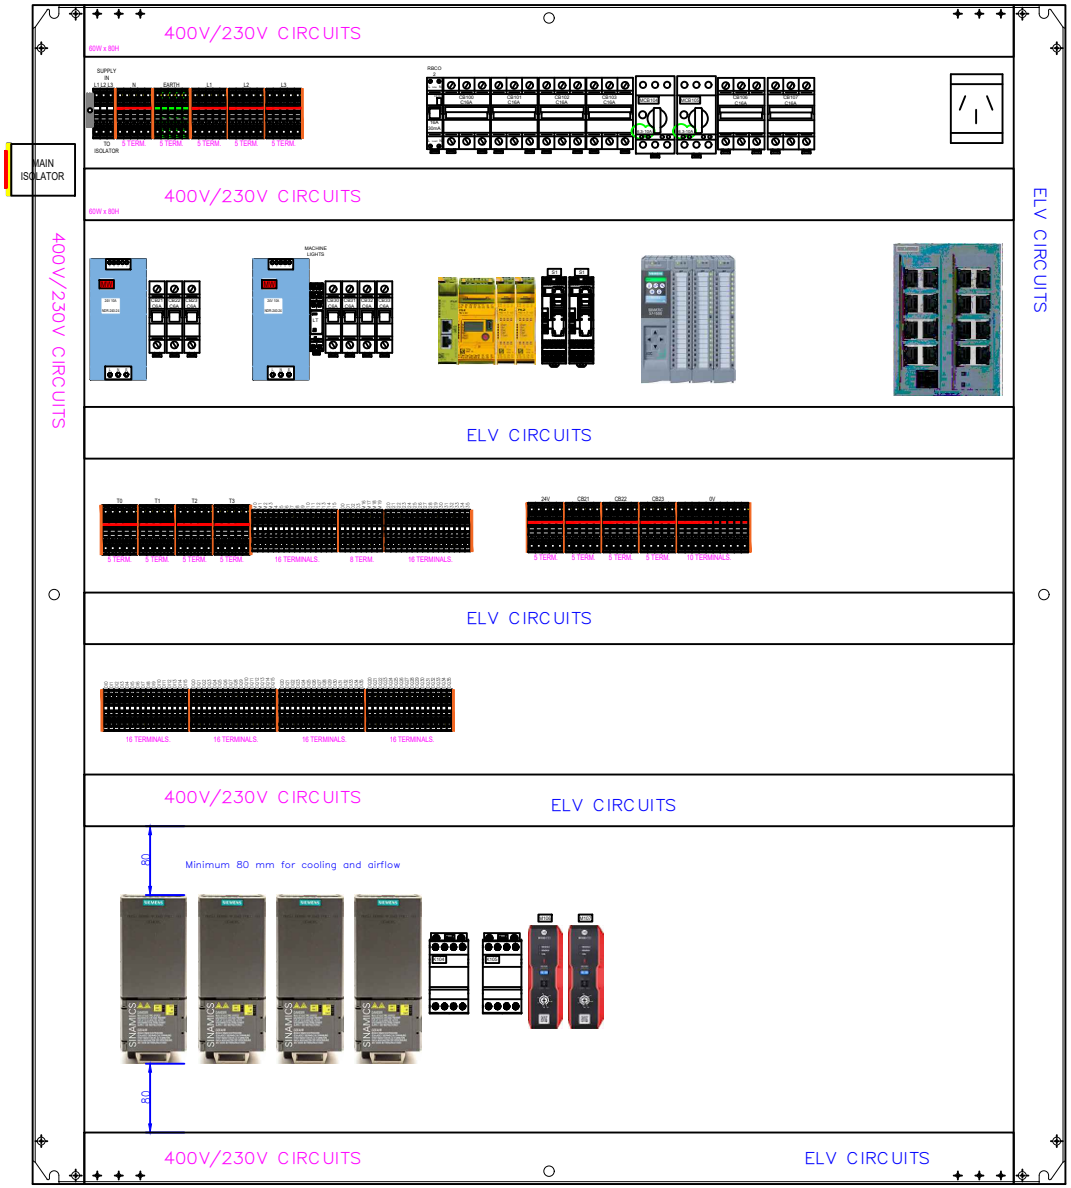

REV	DATE	DWN	CHK	APP	REVISION
E					
D					
C					
B					
A	28/08/26	D.B.	C.W.	C.W.	REVISION ONE, AS BUILT

THIS DRAWING IS OWNED BY FBS SOLUTIONS FOOD AND BEVERAGES AND IS ISSUED ON THE UNDERSTANDING THAT IT MAY NOT BE COPIED OR REPRODUCED IN WHOLE OR IN PART WITHOUT WRITTEN PERMISSION. NOR IS INFORMATION TO BE FURNISHED FROM WHICH COULD BE INJURIOUS TO THE ABOVE COMPANY

SCALE: NOT TO SCALE

	NAME	DATE
DRAWN	D. BORG	28/08/26
DESIGN	D. BORG	28/08/26
CHECKED	C. WHITELEY	28/08/26
APPROVED	C. WHITELEY	28/08/26

PROJECT: SCHLENKER 36/10

Serial No.: FBS Global Serial: 130039

FBS Solutions
45 Pelmet Cres, Thomastown VIC., Australia 3074
FOOD & BEVERAGE
Phone: +61 3 9191 2956
Contact: CLINT WHITELEY
Mobile: +61 418 383 441
E: enquiries@fbsglobal.com.au

DWG. NO.: 8001 A3


REVISION ONE, AS BUILT


SHEET TITLE: MAIN CONTROL PANEL GEARTRAY


REVISION A

SHEET 3

60W x 80H

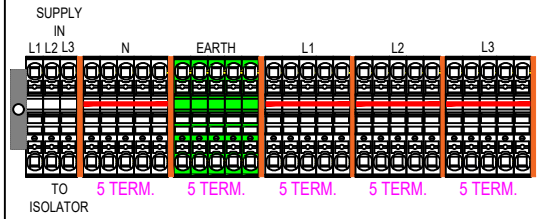


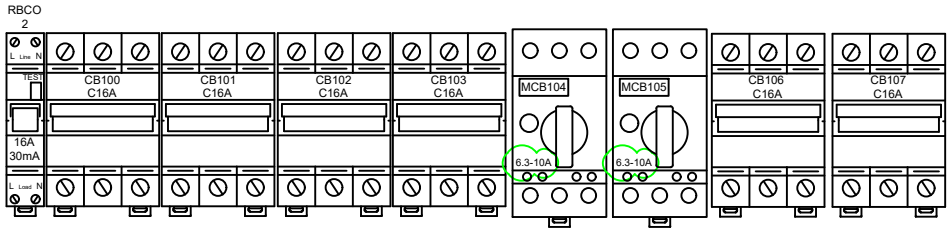


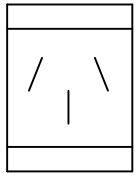


400V/230V CIRCUITS


60W x 80H

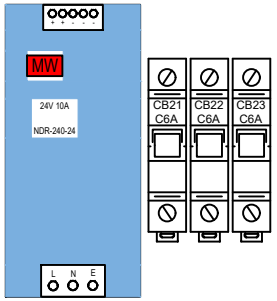

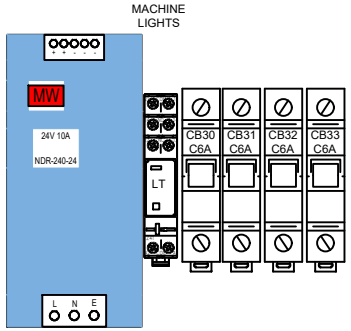


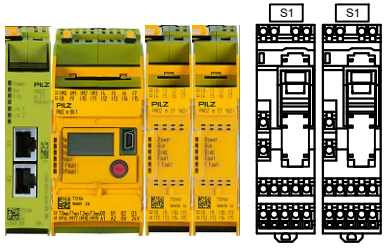




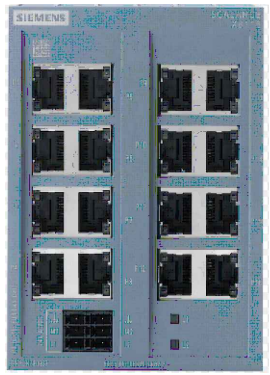


ELV CIRCUITS

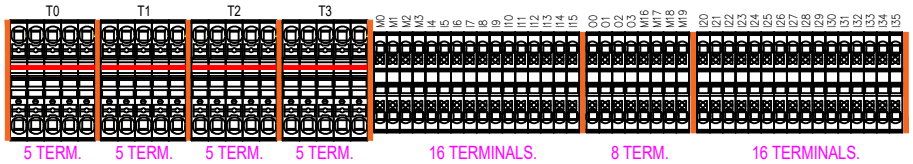

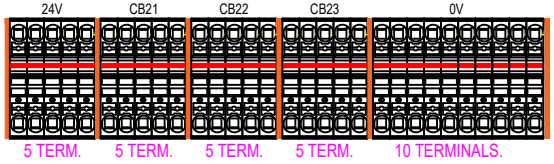

400VAC 50Hz 3 PHASE SUPPLY

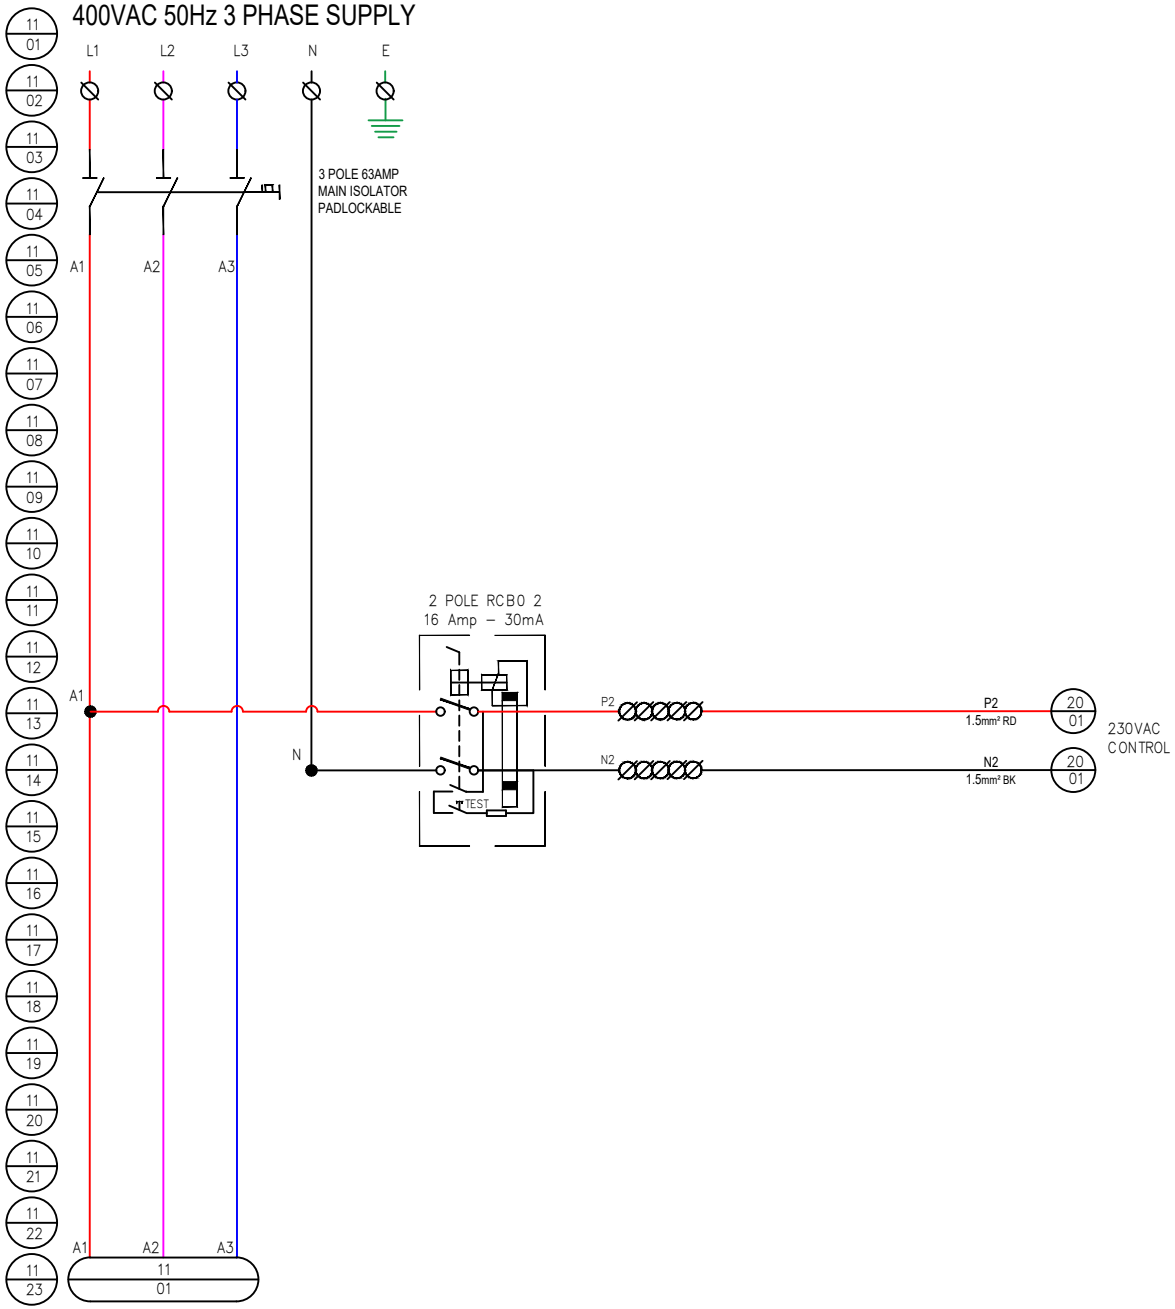

RED, WHITE, BLUE – ACTIVES
BLACK – NEUTRAL
GREEN / YELLOW TRACE – EARTH
PURPLE – 24VDC POSITIVE
GREY – 0VDC NEGATIVE
ORANGE – 24VDC INTERFACE

REV	DATE	DWN	CHK	APP	REVISION
E					
D					
C					
B					
A	28/08/26	D.B.	C.W.	C.W.	REVISION ONE, AS BUILT

THIS DRAWING IS OWNED BY FBS SOLUTIONS FOOD AND BEVERAGES AND IS ISSUED ON THE UNDERSTANDING THAT IT MAY NOT BE COPIED OR REPRODUCED IN WHOLE OR IN PART WITHOUT WRITTEN PERMISSION. NOR IS INFORMATION TO BE FURNISHED FROM WHICH COULD BE INJURIOUS TO THE ABOVE COMPANY


SCALE: NOT TO SCALE

	NAME	DATE
DRAWN	D. BORG	28/08/26
DESIGN	D. BORG	28/08/26
CHECKED	C. WHITELEY	28/08/26
APPROVED	C. WHITELEY	28/08/26

PROJECT: SCHLENKER 36/10
Serial No.: FBS Global Serial: 130039

FBS Solutions
45 Pelmet Cres, Thomastown VIC., Australia 3074
FOOD & BEVERAGE
Phone: +61 3 9191 2956
Contact: CLINT WHITELEY
Mobile: +61 418 383 441
E: enquiries@fbsglobal.com.au

DWG. NO.: 8001 A3
REVISION ONE, AS BUILT
SHEET TITLE: POWER DISTRIBUTION
REVISION A
SHEET 10

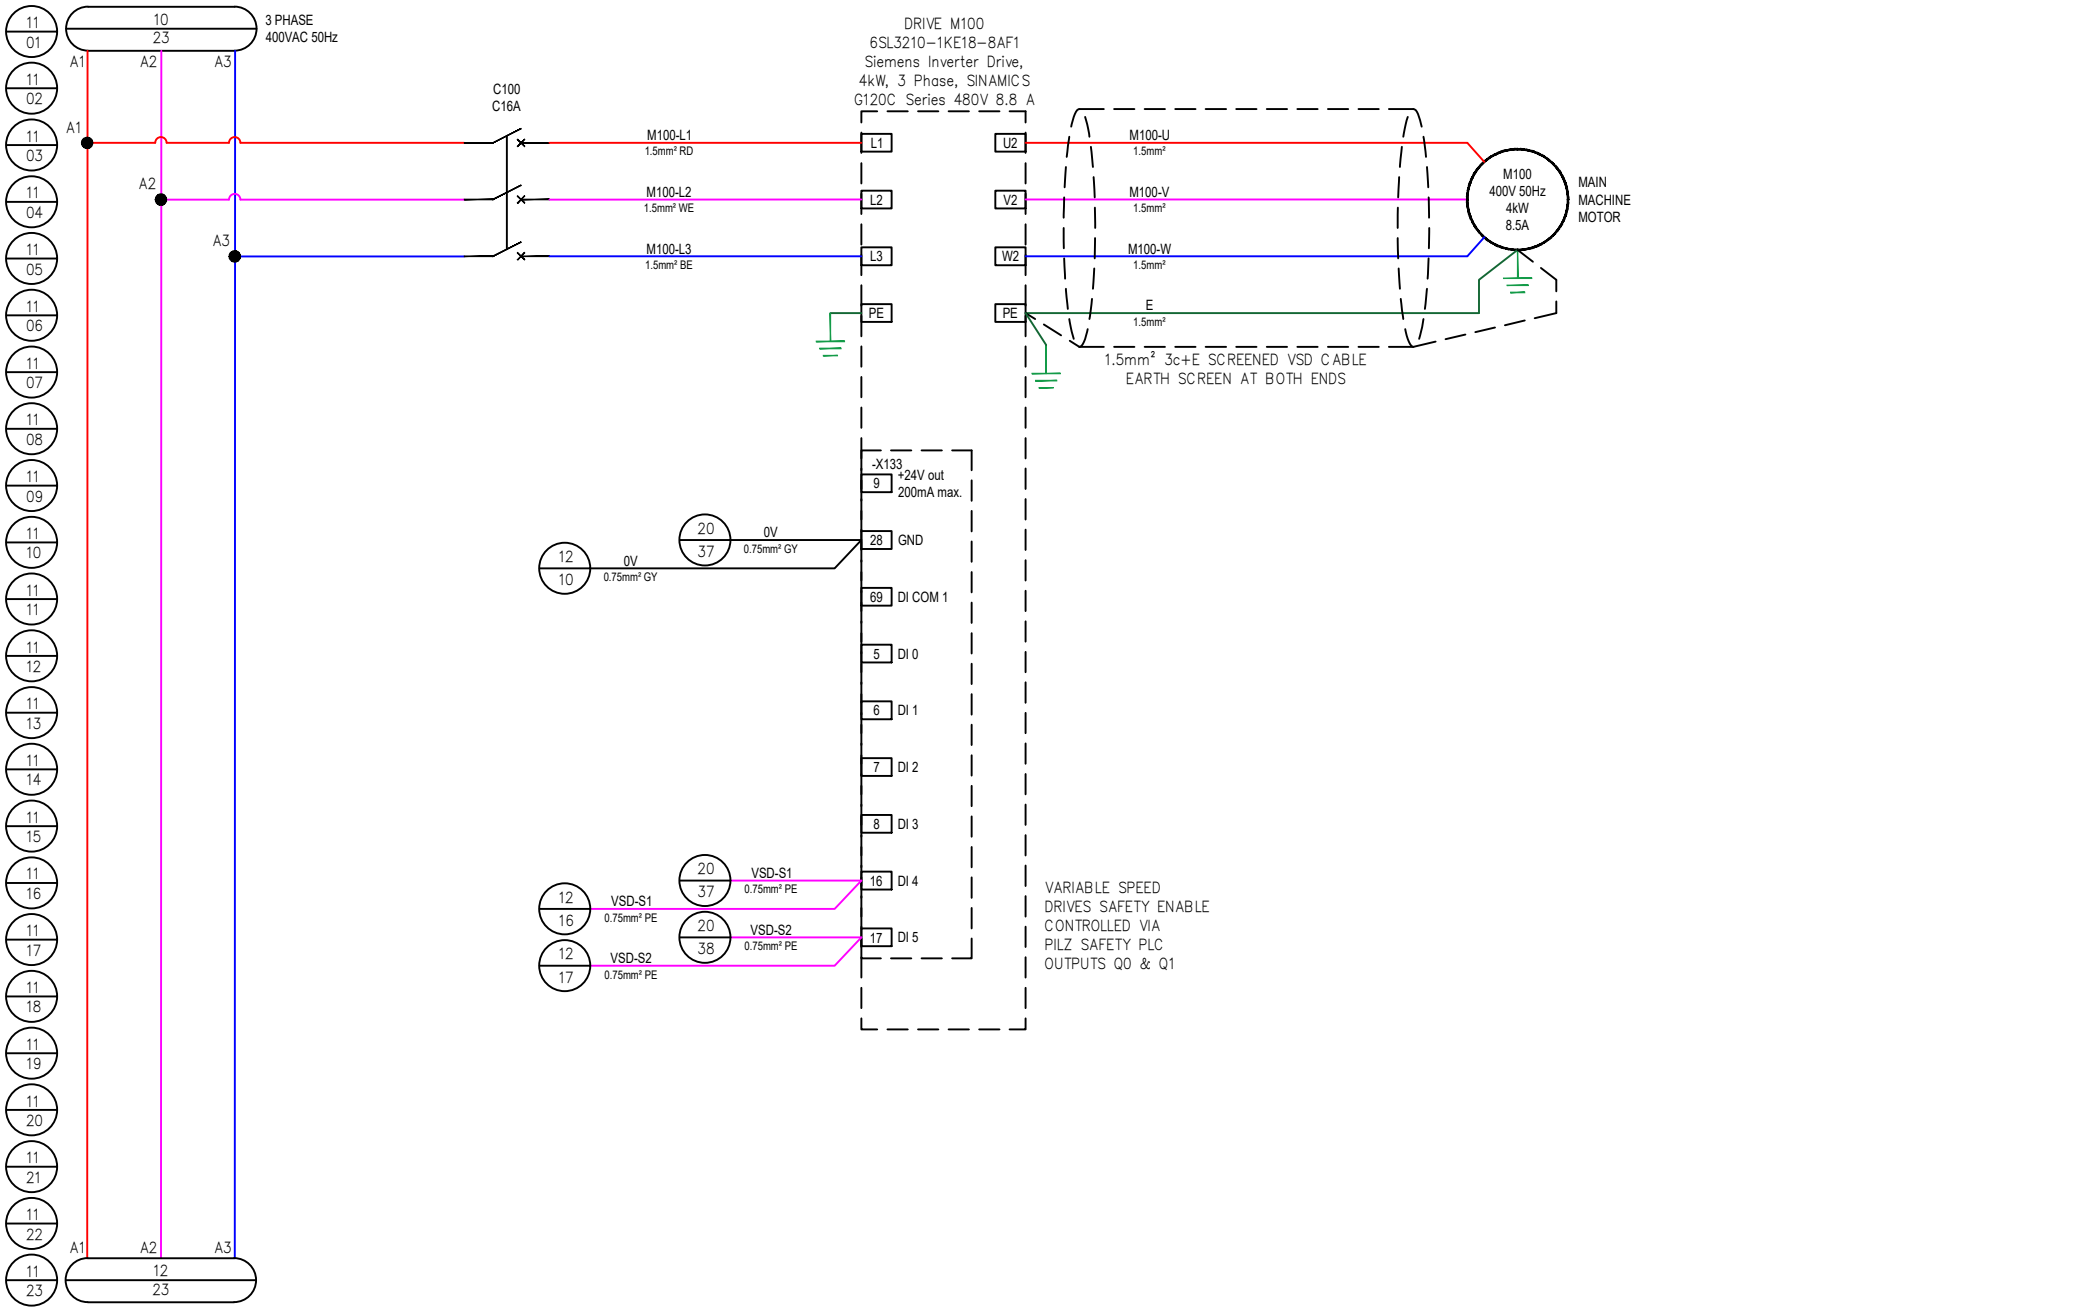

REV	DATE	DWN	CHK	APP	REVISION
E					
D					
C					
B					
A	28/08/26	D.B.	C.W.	C.W.	REVISION ONE, AS BUILT

THIS DRAWING IS OWNED BY FBS SOLUTIONS FOOD AND BEVERAGES AND IS ISSUED ON THE UNDERSTANDING THAT IT MAY NOT BE COPIED OR REPRODUCED IN WHOLE OR IN PART WITHOUT WRITTEN PERMISSION. NOR IS INFORMATION TO BE FURNISHED FROM WHICH COULD BE INJURIOUS TO THE ABOVE COMPANY

SCALE: NOT TO SCALE

	NAME	DATE
DRAWN	D. BORG	28/08/26
DESIGN	D. BORG	28/08/26
CHECKED	C. WHITELEY	28/08/26
APPROVED	C. WHITELEY	28/08/26

PROJECT: SCHLENKER 36/10

Serial No.: FBS Global Serial: 130039

FBS Solutions
45 Pelmet Cres, Thomastown VIC., Australia 3074
FOOD & BEVERAGE
Phone: +61 3 9191 2956
Contact: CLINT WHITELEY
Mobile: +61 418 383 441
E: enquiries@fbsglobal.com.au


DWG. NO.: 8001 A3

REVISION ONE, AS BUILT

SHEET TITLE: DRIVES

REVISION A

SHEET 11

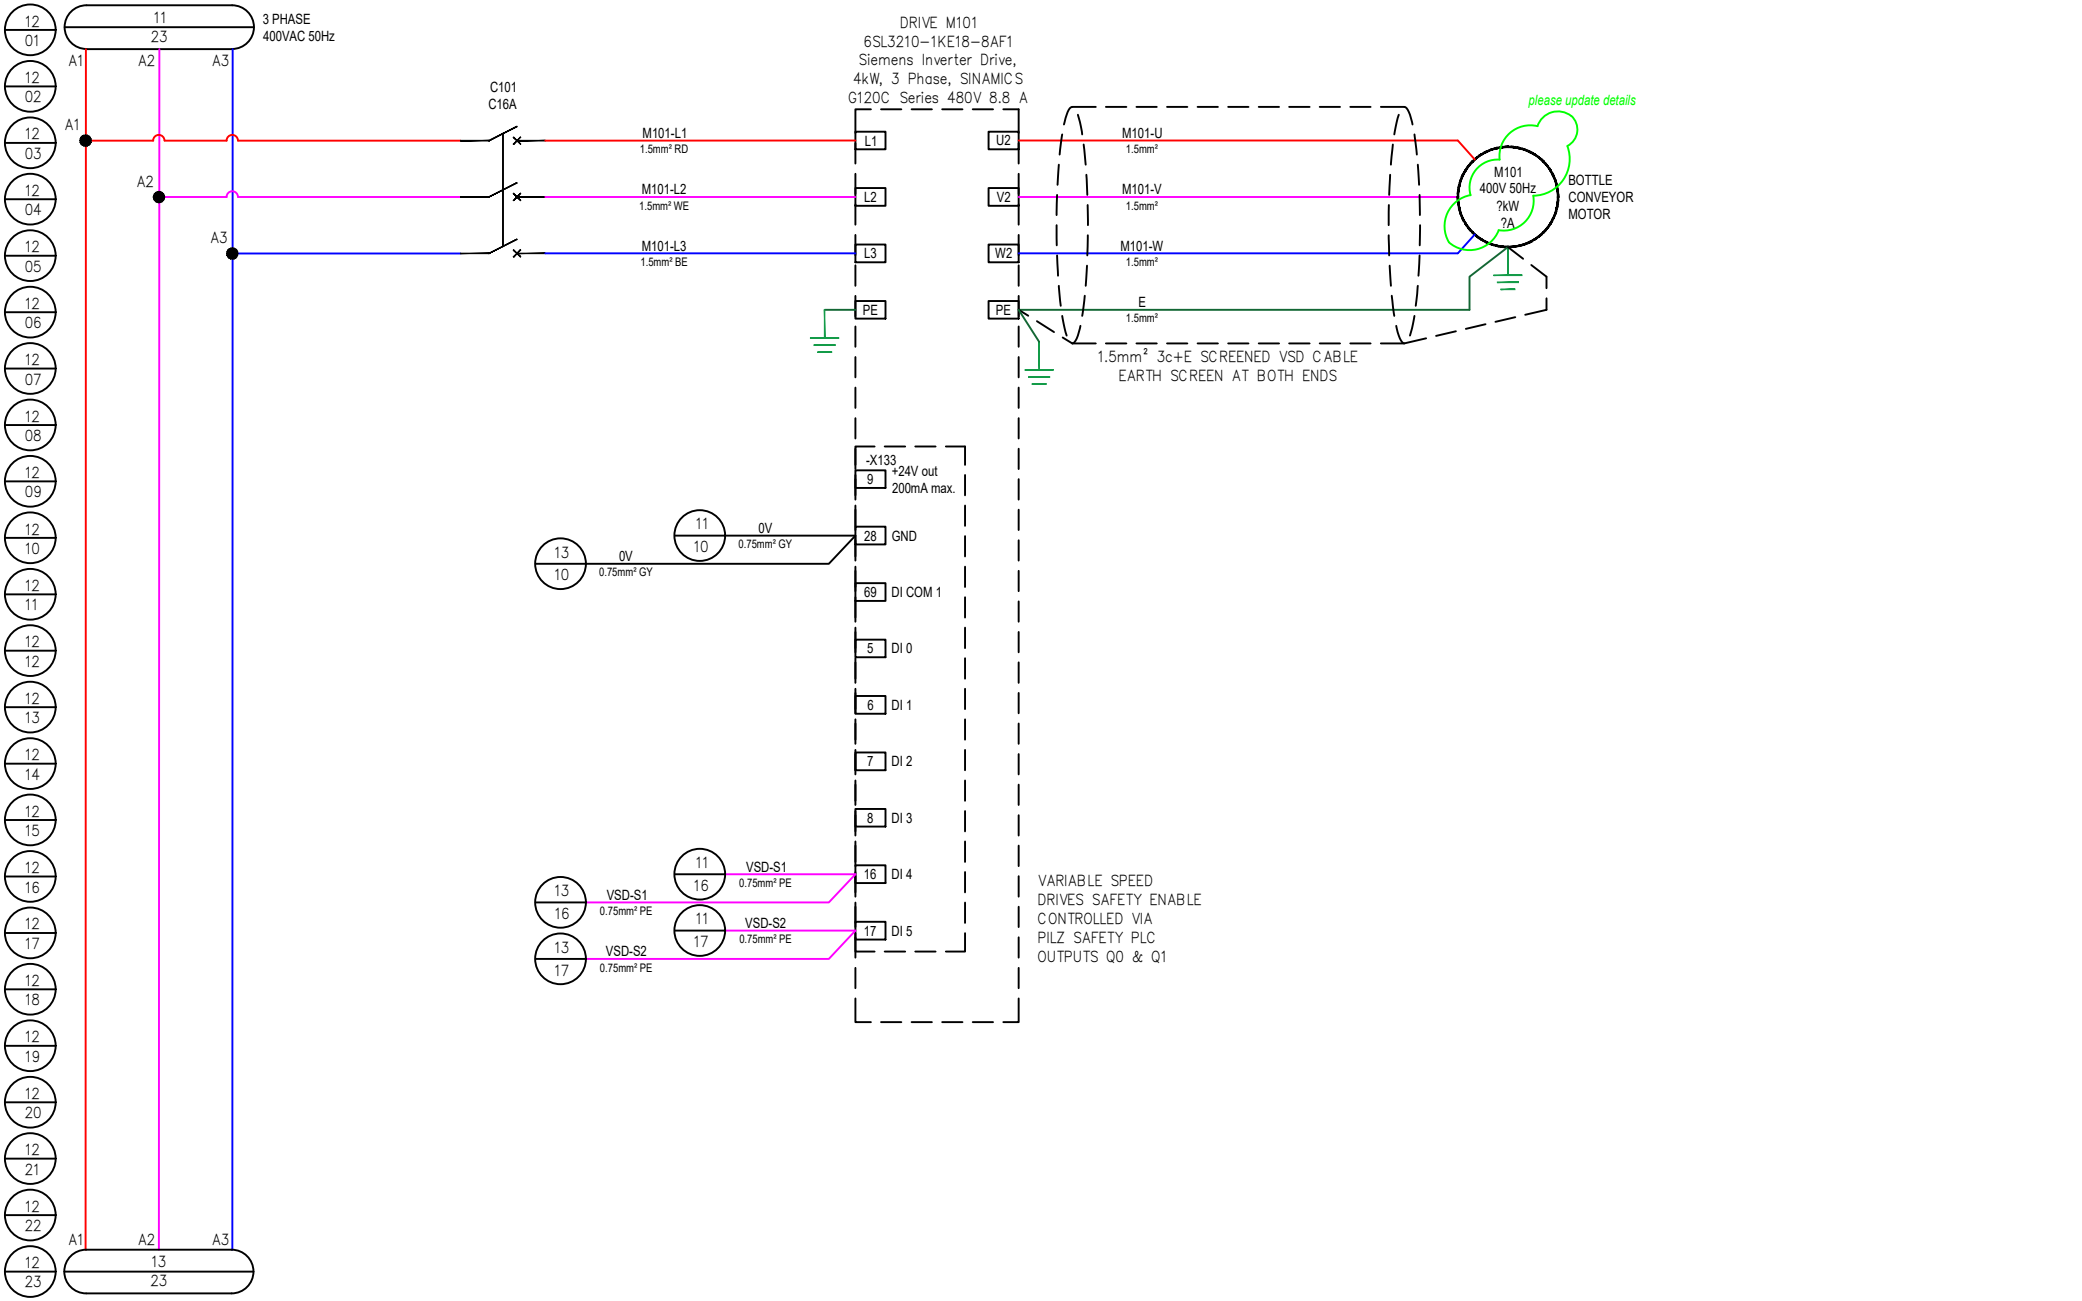

REV	DATE	DWN	CHK	APP	REVISION
E					
D					
C					
B					
A	28/08/26	D.B.	C.W.	C.W.	REVISION ONE, AS BUILT

THIS DRAWING IS OWNED BY FBS SOLUTIONS FOOD AND BEVERAGES AND IS ISSUED ON THE UNDERSTANDING THAT IT MAY NOT BE COPIED OR REPRODUCED IN WHOLE OR IN PART WITHOUT WRITTEN PERMISSION. NOR IS INFORMATION TO BE FURNISHED FROM WHICH COULD BE INJURIOUS TO THE ABOVE COMPANY

SCALE: NOT TO SCALE

	NAME	DATE
DRAWN	D. BORG	28/08/26
DESIGN	D. BORG	28/08/26
CHECKED	C. WHITELEY	28/08/26
APPROVED	C. WHITELEY	28/08/26

PROJECT: SCHLENKER 36/10

Serial No.: FBS Global Serial: 130039

FBS Solutions
45 Pelmet Cres, Thomastown VIC., Australia 3074
FOOD & BEVERAGE
Phone: +61 3 9191 2956
Contact: CLINT WHITELEY
Mobile: +61 418 383 441
E: enquiries@fbsglobal.com.au


DWG. NO.: 8001 A3

REVISION ONE, AS BUILT

SHEET TITLE: DRIVES

REVISION: A

SHEET 12

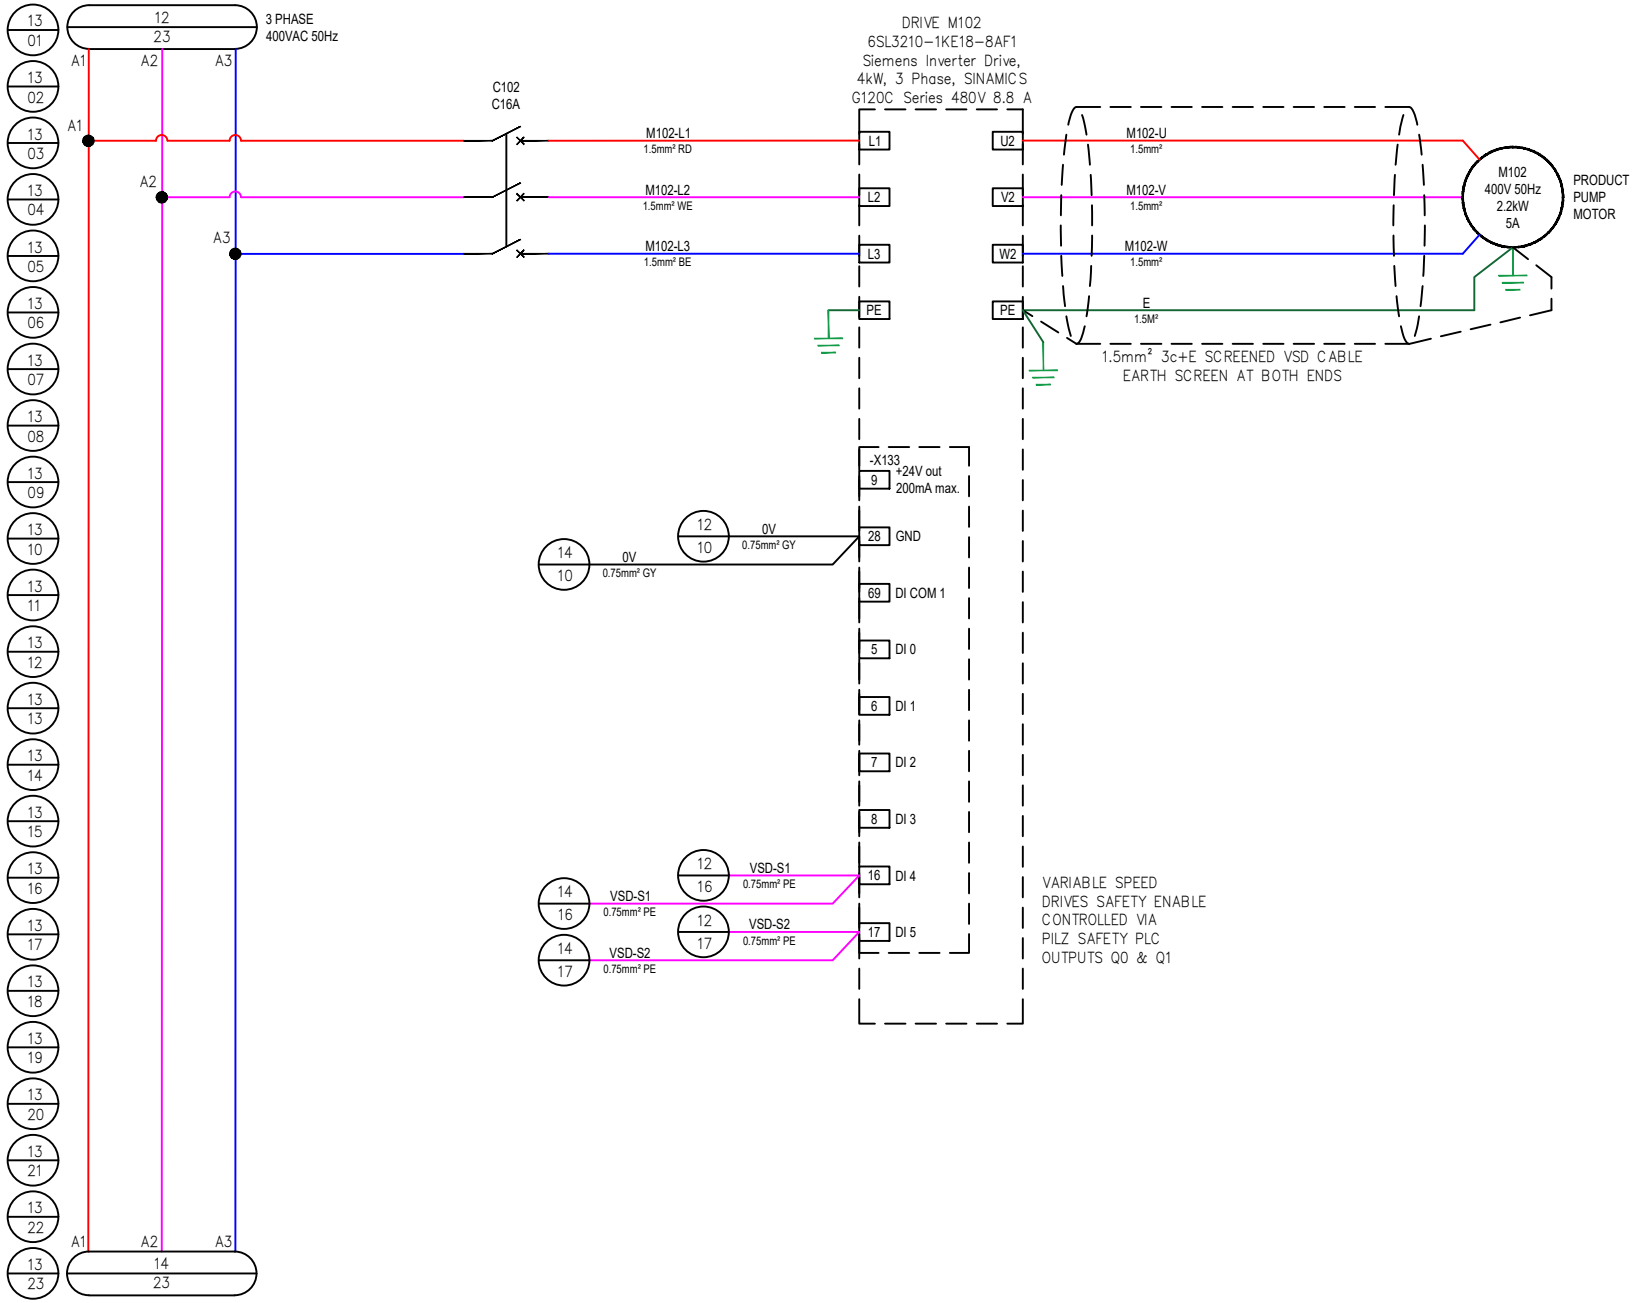

REV	DATE	DWN	CHK	APP	REVISION
E					
D					
C					
B					
A	28/08/26	D.B.	C.W.	C.W.	REVISION ONE, AS BUILT

THIS DRAWING IS OWNED BY FBS SOLUTIONS FOOD AND BEVERAGES AND IS ISSUED ON THE UNDERSTANDING THAT IT MAY NOT BE COPIED OR REPRODUCED IN WHOLE OR IN PART WITHOUT WRITTEN PERMISSION. NOR IS INFORMATION TO BE FURNISHED FROM WHICH COULD BE INJURIOUS TO THE ABOVE COMPANY

SCALE: NOT TO SCALE

	NAME	DATE
DRAWN	D. BORG	28/08/26
DESIGN	D. BORG	28/08/26
CHECKED	C. WHITELEY	28/08/26
APPROVED	C. WHITELEY	28/08/26

PROJECT: SCHLENKER 36/10

Serial No.: FBS Global Serial: 130039

FBS Solutions
45 Pelmet Cres, Thomastown VIC., Australia 3074
FOOD & BEVERAGE
Phone: +61 3 9191 2956
Contact: CLINT WHITELEY
Mobile: +61 418 383 441
E: enquiries@fbsglobal.com.au


DWG. NO.: 8001 A3

REVISION ONE, AS BUILT

SHEET TITLE: DRIVES

REVISION A

SHEET 13

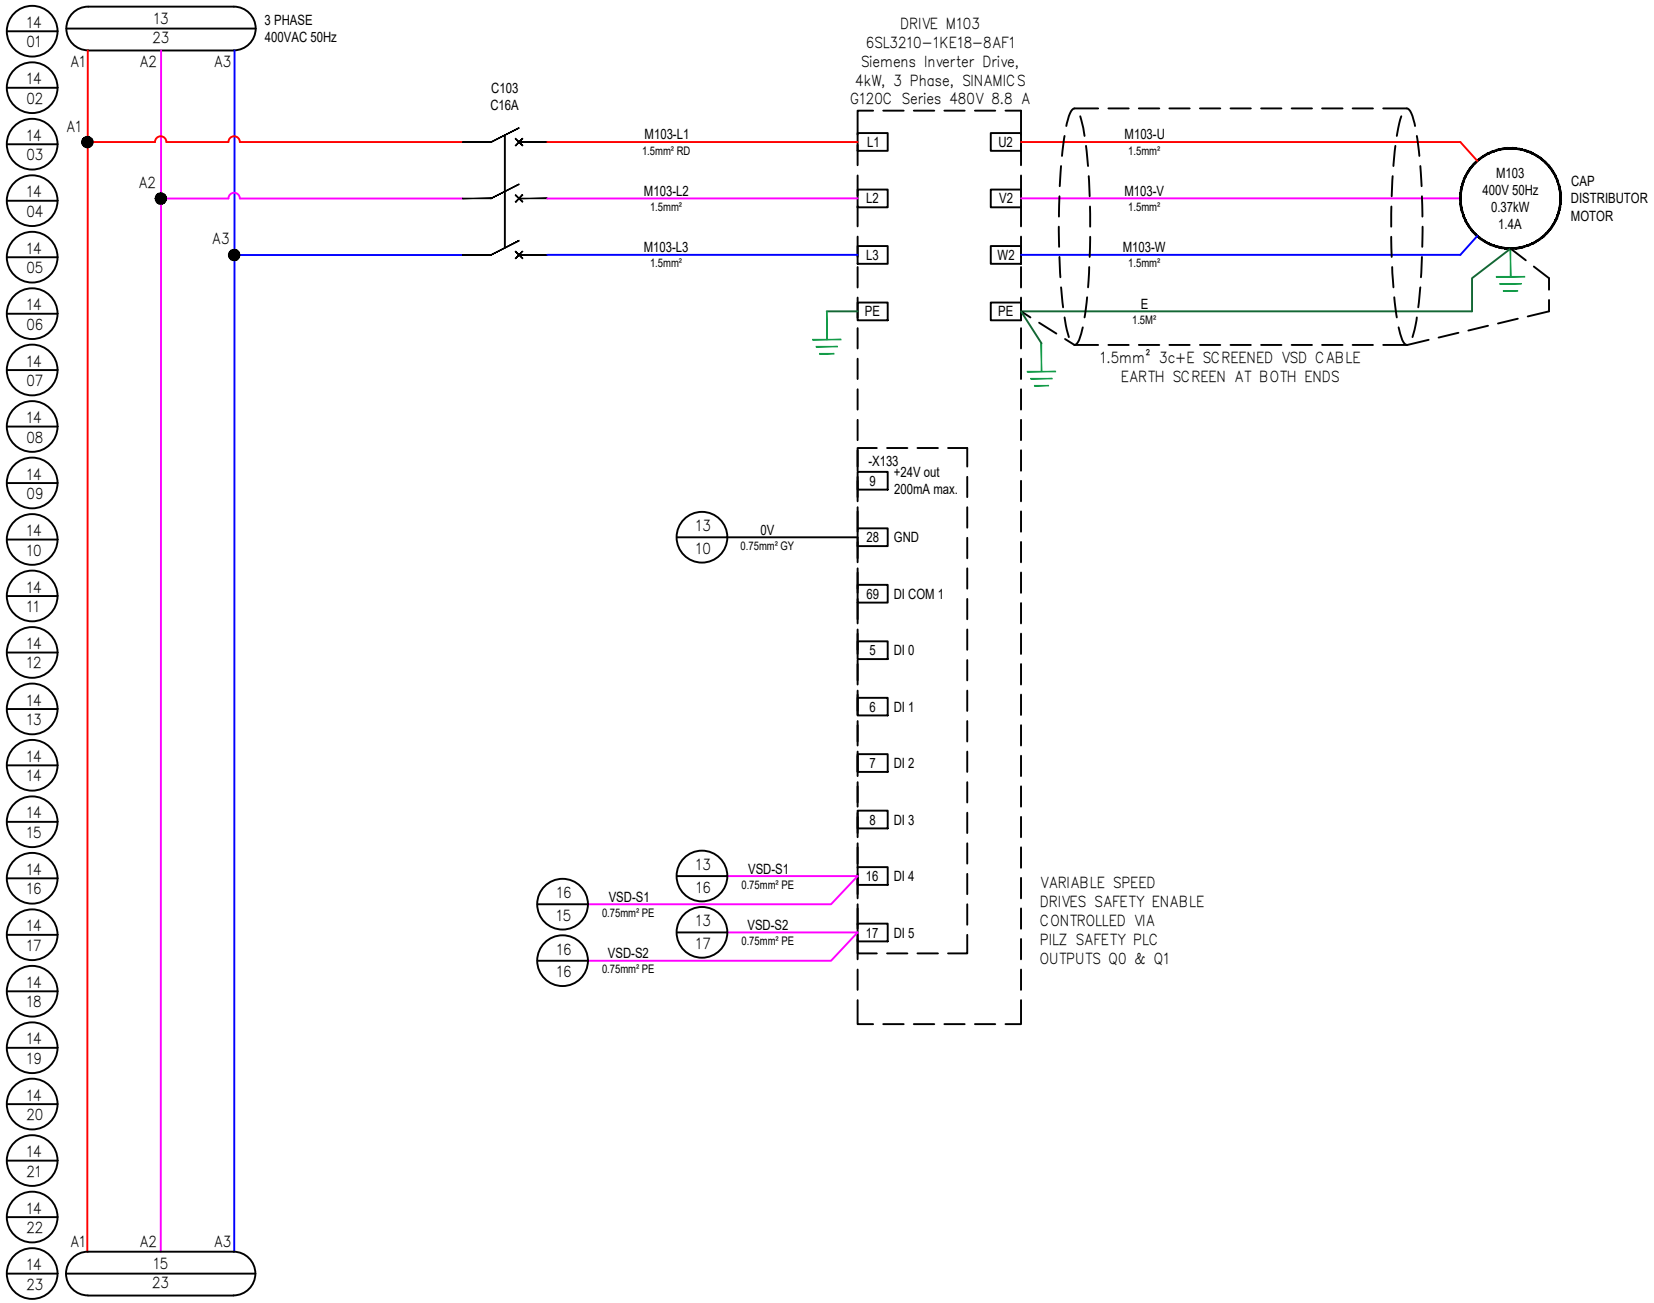

REV	DATE	DWN	CHK	APP	REVISION
E					
D					
C					
B					
A	28/08/26	D.B.	C.W.	C.W.	REVISION ONE, AS BUILT

THIS DRAWING IS OWNED BY FBS SOLUTIONS FOOD AND BEVERAGES AND IS ISSUED ON THE UNDERSTANDING THAT IT MAY NOT BE COPIED OR REPRODUCED IN WHOLE OR IN PART WITHOUT WRITTEN PERMISSION. NOR IS INFORMATION TO BE FURNISHED FROM WHICH COULD BE INJURIOUS TO THE ABOVE COMPANY

SCALE: NOT TO SCALE

	NAME	DATE
DRAWN	D. BORG	28/08/26
DESIGN	D. BORG	28/08/26
CHECKED	C. WHITELEY	28/08/26
APPROVED	C. WHITELEY	28/08/26

PROJECT: SCHLENKER 36/10

Serial No.: FBS Global Serial: 130039

FBS Solutions
45 Pelmet Cres, Thomastown VIC., Australia 3074
FOOD & BEVERAGE
Phone: +61 3 9191 2956
Contact: CLINT WHITELEY
Mobile: +61 418 383 441
E: enquiries@fbsglobal.com.au


DWG. NO.: 8001 A3

REVISION ONE, AS BUILT

SHEET TITLE: DRIVES

REVISION: A

SHEET 14

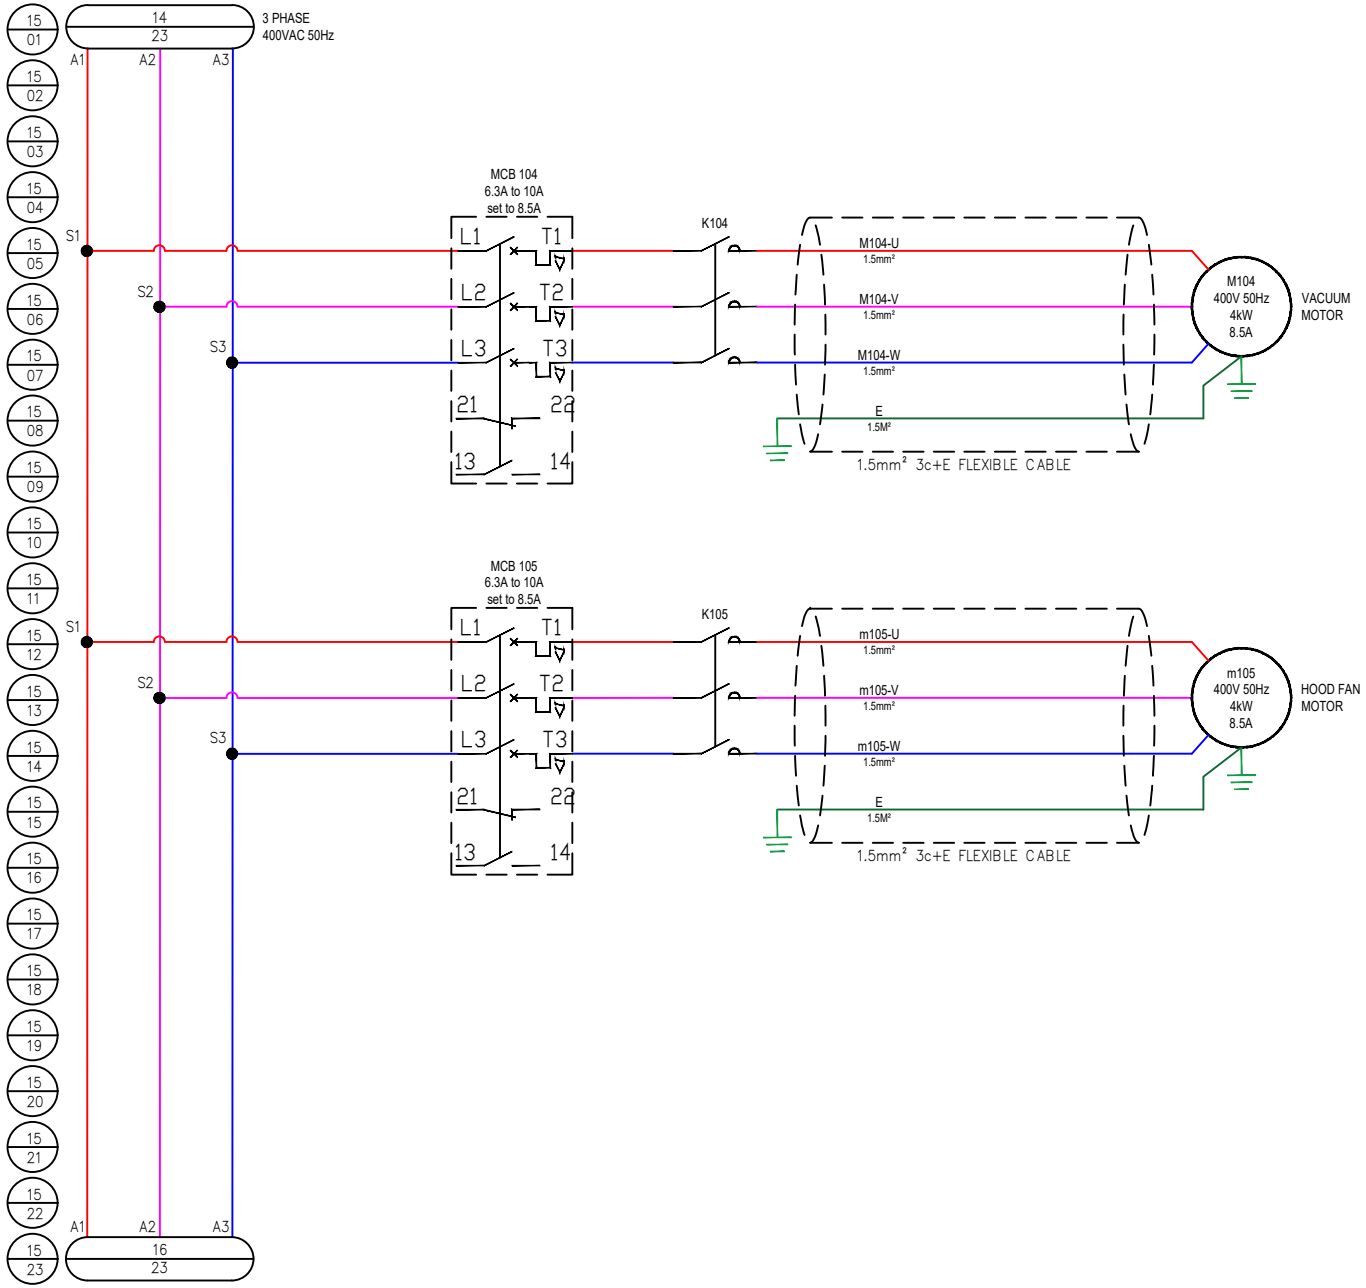

REV	DATE	DWN	CHK	APP	REVISION
E					
D					
C					
B					
A	28/08/26	D.B.	C.W.	C.W.	REVISION ONE, AS BUILT

THIS DRAWING IS OWNED BY FBS SOLUTIONS FOOD AND BEVERAGES AND IS ISSUED ON THE UNDERSTANDING THAT IT MAY NOT BE COPIED OR REPRODUCED IN WHOLE OR IN PART WITHOUT WRITTEN PERMISSION. NOR IS INFORMATION TO BE FURNISHED FROM WHICH COULD BE INJURIOUS TO THE ABOVE COMPANY

SCALE: NOT TO SCALE

	NAME	DATE
DRAWN	D. BORG	28/08/26
DESIGN	D. BORG	28/08/26
CHECKED	C. WHITELEY	28/08/26
APPROVED	C. WHITELEY	28/08/26

PROJECT: SCHLENKER 36/10

Serial No.: FBS Global Serial: 130039

FBS Solutions
45 Pelmet Cres, Thomastown VIC., Australia 3074
FOOD & BEVERAGE
Phone: +61 3 9191 2956
Contact: CLINT WHITELEY
Mobile: +61 418 383 441
E: enquiries@fbsglobal.com.au


DWG. NO.: 8001 A3

REVISION ONE, AS BUILT

SHEET TITLE: MOTORS

REVISION: A

SHEET 15

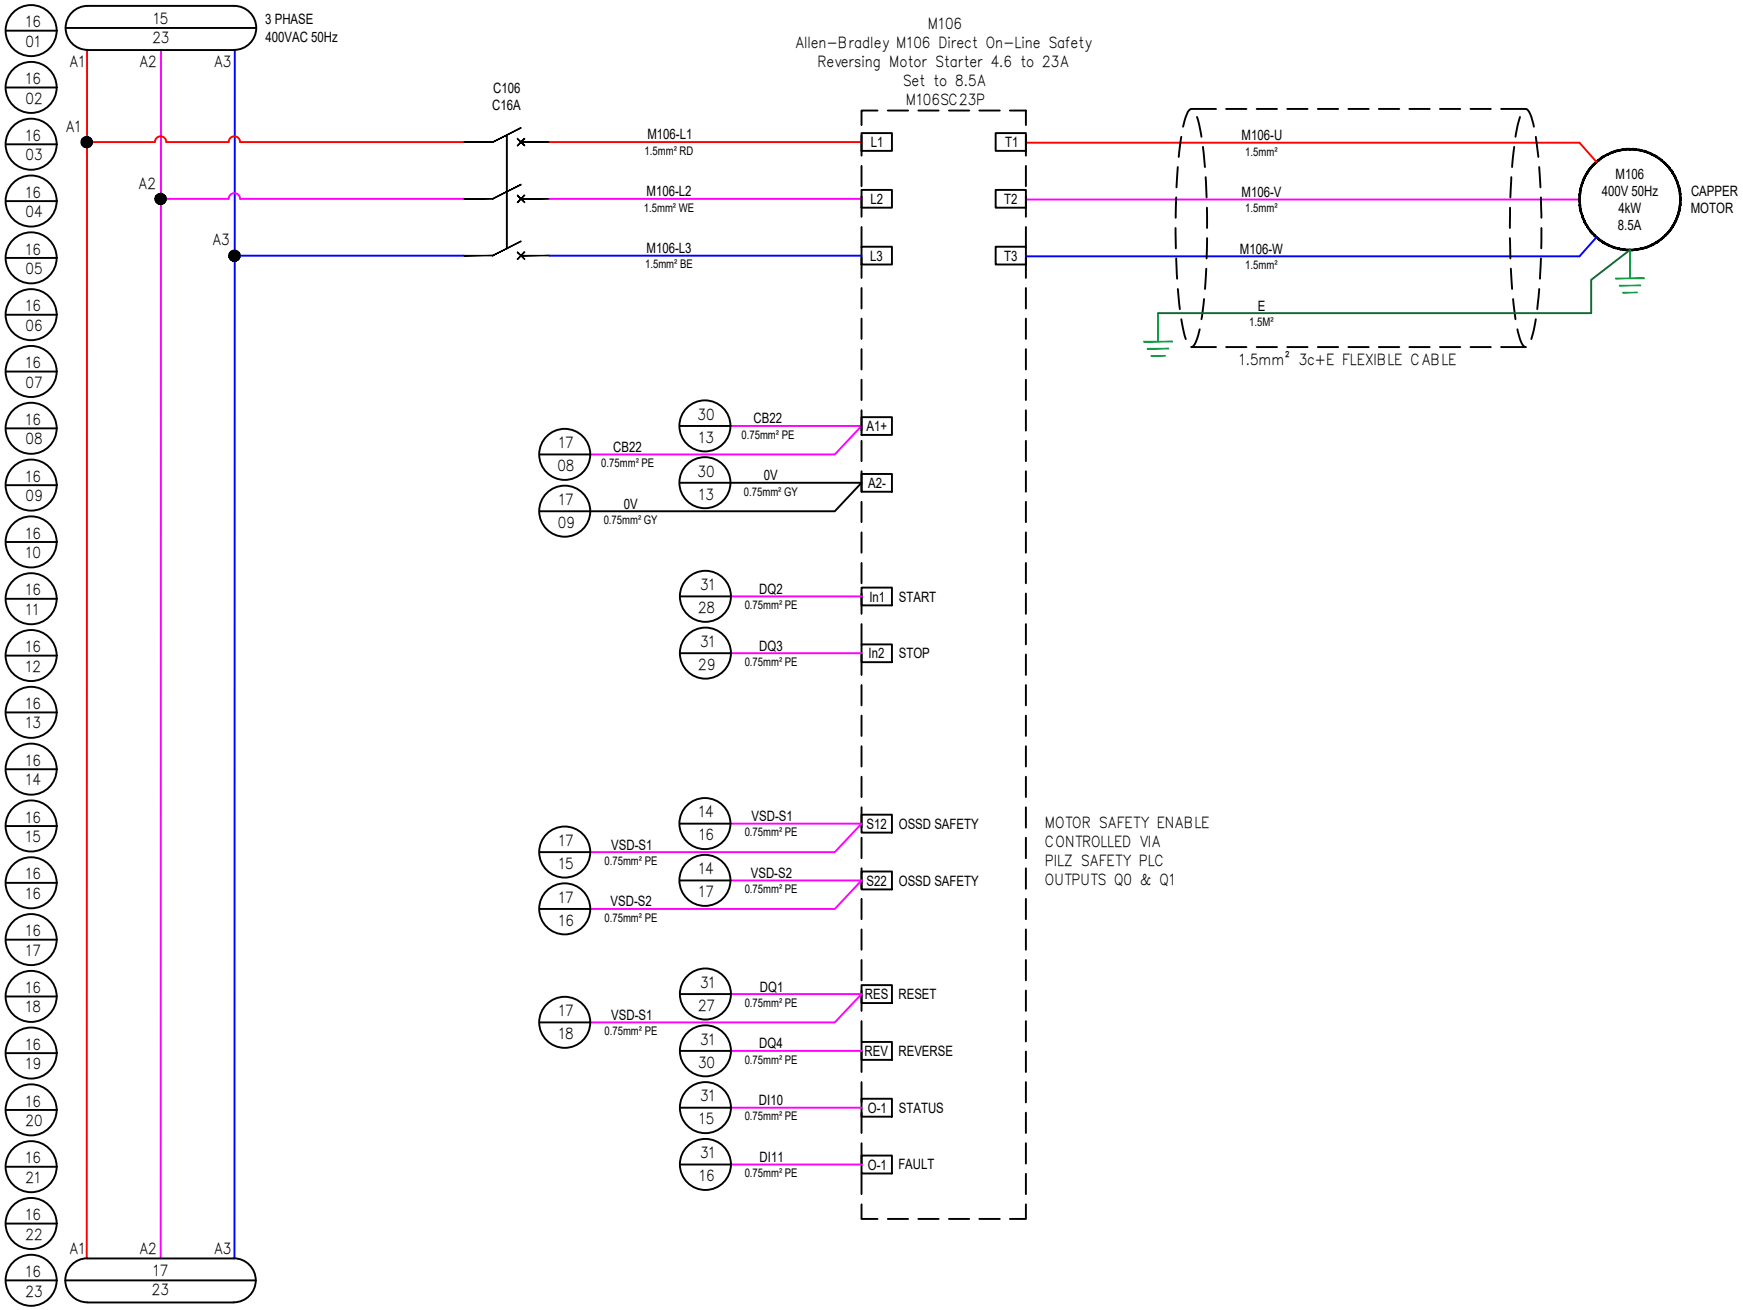

REV	DATE	DWN	CHK	APP	REVISION
E					
D					
C					
B					
A	28/08/26	D.B.	C.W.	C.W.	REVISION ONE, AS BUILT

THIS DRAWING IS OWNED BY FBS SOLUTIONS FOOD AND BEVERAGES AND IS ISSUED ON THE UNDERSTANDING THAT IT MAY NOT BE COPIED OR REPRODUCED IN WHOLE OR IN PART WITHOUT WRITTEN PERMISSION. NOR IS INFORMATION TO BE FURNISHED FROM WHICH COULD BE INJURIOUS TO THE ABOVE COMPANY

SCALE: NOT TO SCALE

	NAME	DATE
DRAWN	D. BORG	28/08/26
DESIGN	D. BORG	28/08/26
CHECKED	C. WHITELEY	28/08/26
APPROVED	C. WHITELEY	28/08/26

PROJECT: SCHLENKER 36/10

Serial No.: FBS Global Serial: 130039

FBS Solutions
45 Pelmet Cres, Thomastown VIC., Australia 3074
FOOD & BEVERAGE
Phone: +61 3 9191 2956
Contact: CLINT WHITELEY
Mobile: +61 418 383 441
E: enquiries@fbsglobal.com.au


DWG. NO.: 8001 A3

REVISION ONE, AS BUILT

SHEET TITLE: MOTORS

REVISION A

SHEET 16

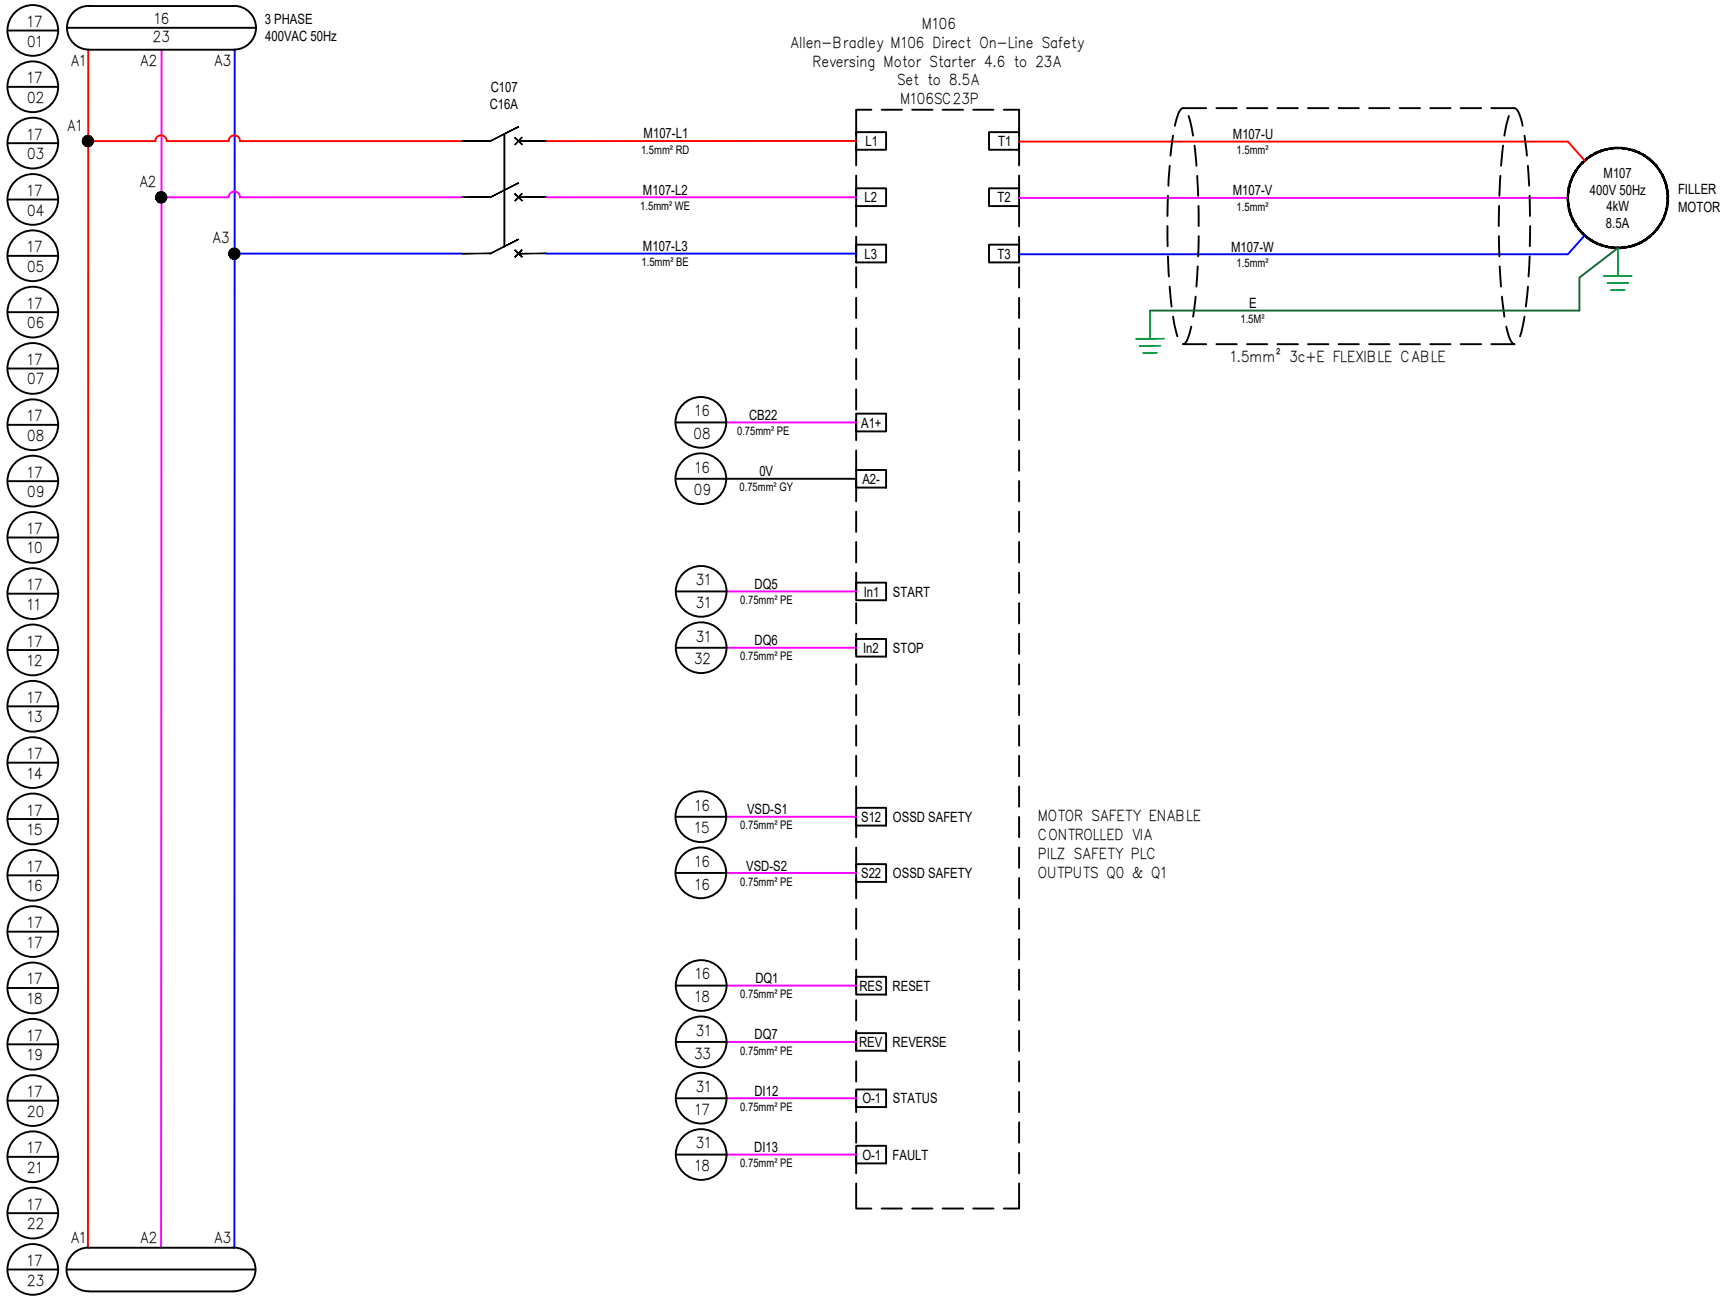

REV	DATE	DWN	CHK	APP	REVISION
E					
D					
C					
B					
A	28/08/26	D.B.	C.W.	C.W.	REVISION ONE, AS BUILT

THIS DRAWING IS OWNED BY FBS SOLUTIONS FOOD AND BEVERAGES AND IS ISSUED ON THE UNDERSTANDING THAT IT MAY NOT BE COPIED OR REPRODUCED IN WHOLE OR IN PART WITHOUT WRITTEN PERMISSION. NOR IS INFORMATION TO BE FURNISHED FROM WHICH COULD BE INJURIOUS TO THE ABOVE COMPANY

SCALE: NOT TO SCALE

	NAME	DATE
DRAWN	D. BORG	28/08/26
DESIGN	D. BORG	28/08/26
CHECKED	C. WHITELEY	28/08/26
APPROVED	C. WHITELEY	28/08/26

PROJECT: SCHLENKER 36/10

Serial No.: FBS Global Serial: 130039

FBS Solutions
45 Pelmet Cres, Thomastown VIC., Australia 3074
FOOD & BEVERAGE
Phone: +61 3 9191 2956
Contact: CLINT WHITELEY
Mobile: +61 418 383 441
E: enquiries@fbsglobal.com.au


DWG. NO.: 8001 A3

REVISION ONE, AS BUILT

SHEET TITLE: MOTORS

REVISION A

SHEET 17

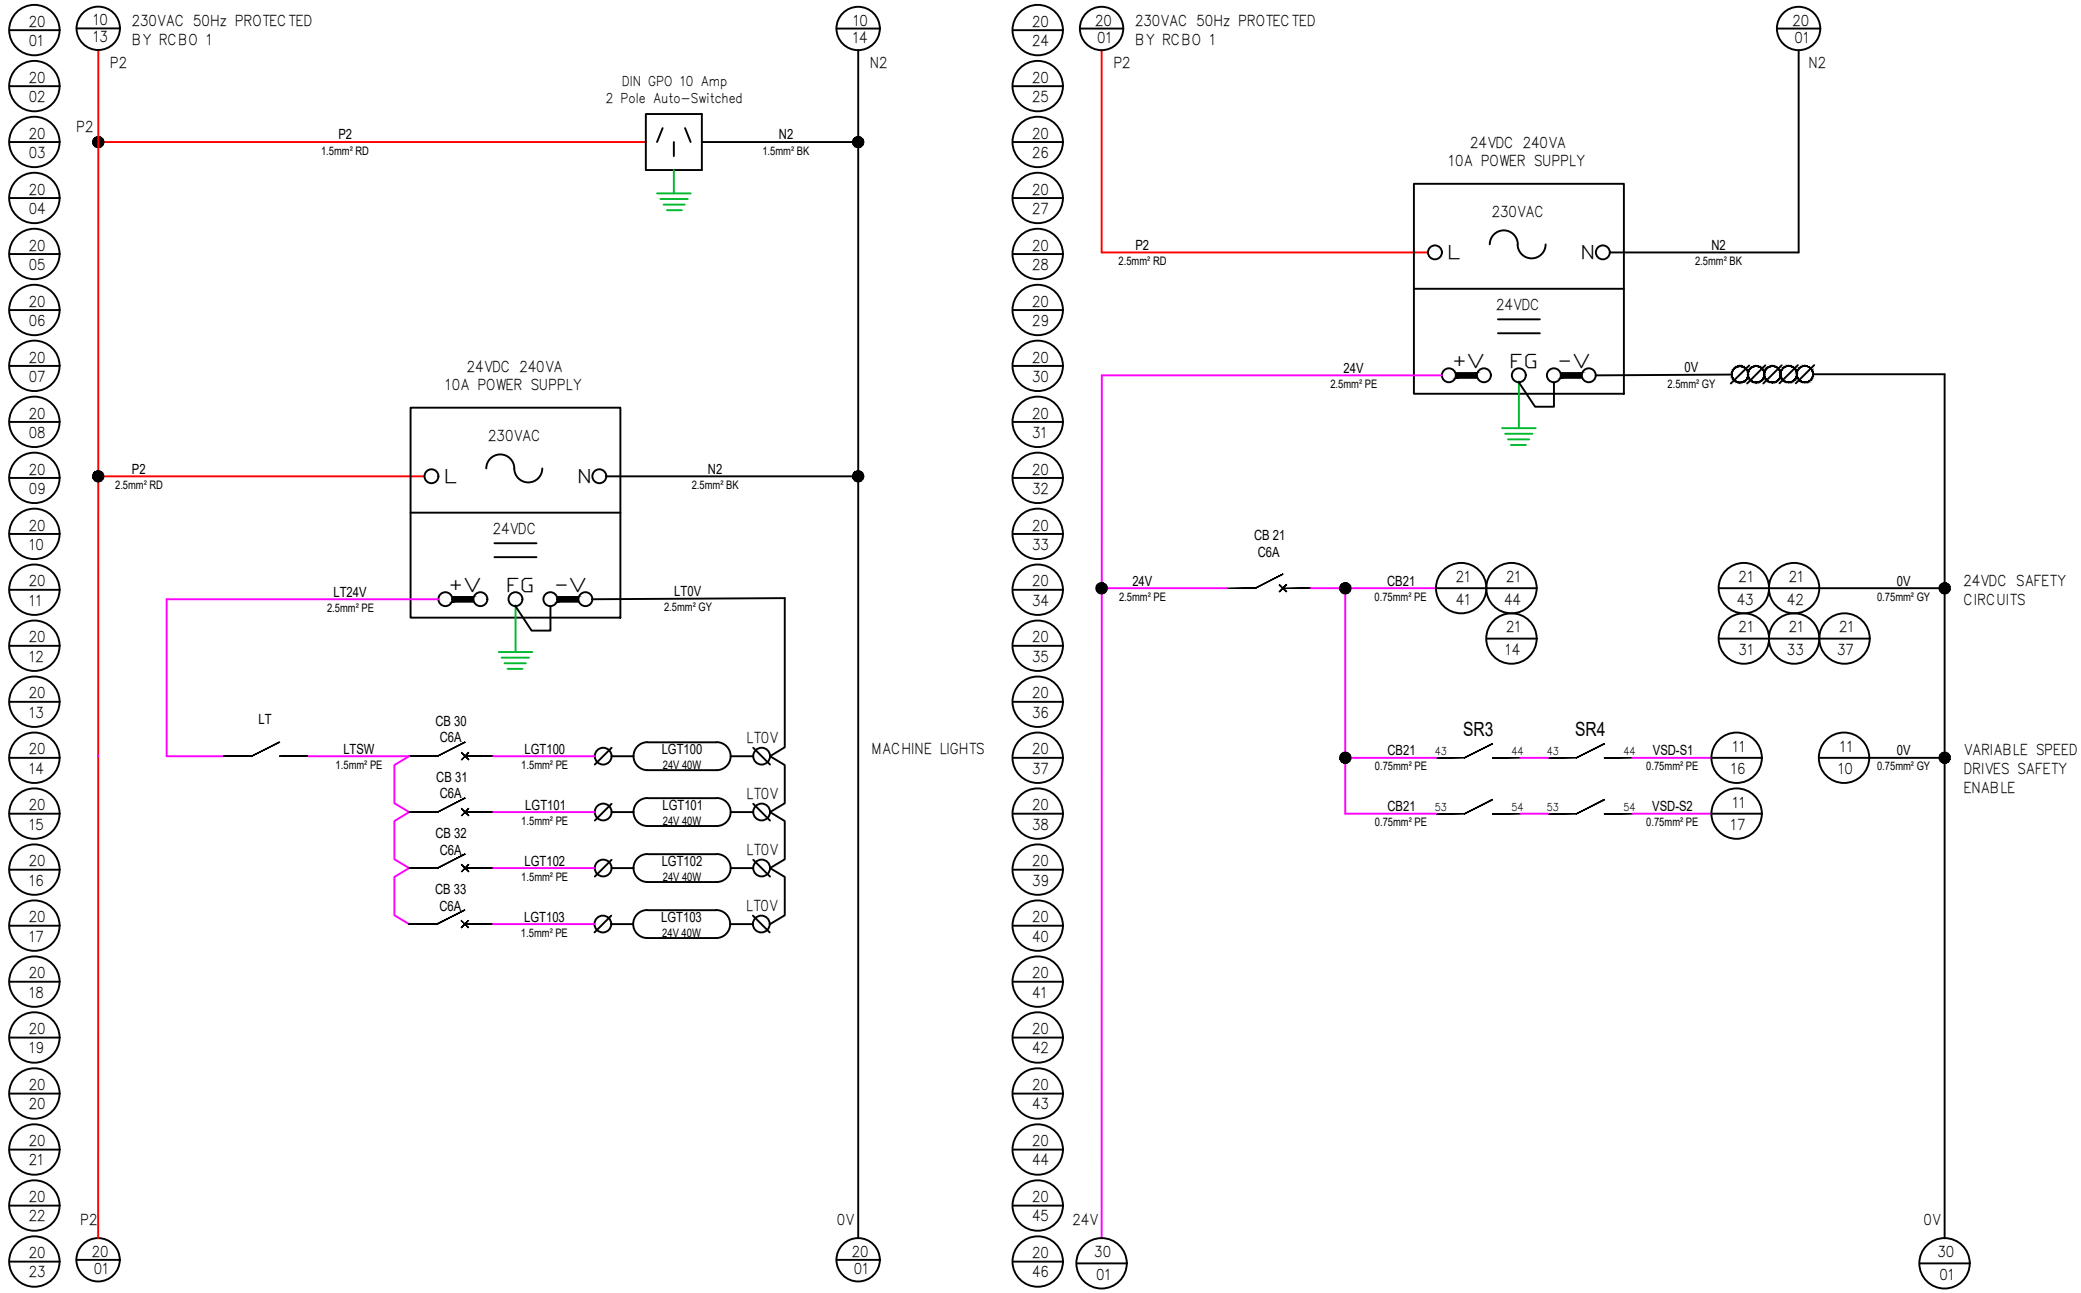

REV	DATE	DWN	CHK	APP	REVISION
E					
D					
C					
B					
A	28/08/26	D.B.	C.W.	C.W.	REVISION ONE, AS BUILT

THIS DRAWING IS OWNED BY FBS SOLUTIONS FOOD AND BEVERAGES AND IS ISSUED ON THE UNDERSTANDING THAT IT MAY NOT BE COPIED OR REPRODUCED IN WHOLE OR IN PART WITHOUT WRITTEN PERMISSION. NOR IS INFORMATION TO BE FURNISHED FROM WHICH COULD BE INJURIOUS TO THE ABOVE COMPANY

SCALE: NOT TO SCALE

	NAME	DATE
DRAWN	D. BORG	28/08/26
DESIGN	D. BORG	28/08/26
CHECKED	C. WHITELEY	28/08/26
APPROVED	C. WHITELEY	28/08/26

PROJECT: SCHLENKER 36/10

Serial No.: FBS Global Serial: 130039

FBS Solutions
45 Pelmet Cres, Thomastown VIC., Australia 3074
FOOD & BEVERAGE
Phone: +61 3 9191 2956
Contact: CLINT WHITELEY
Mobile: +61 418 383 441
E: enquiries@fbsglobal.com.au

DWG. NO.: 8001 A3


REVISION ONE, AS BUILT

SHEET TITLE: CIRCUITS


REVISION A

SHEET 20

BASE UNIT

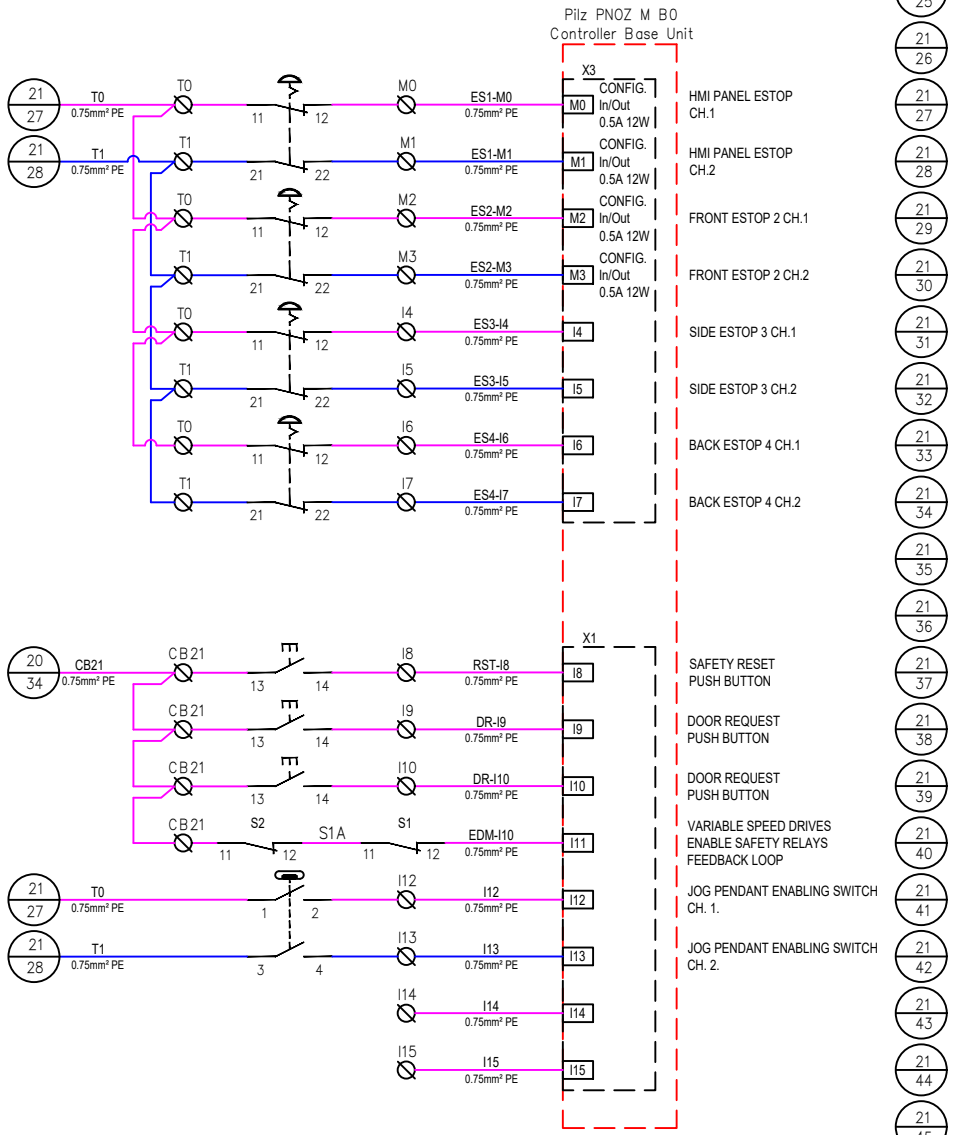

BASE UNIT

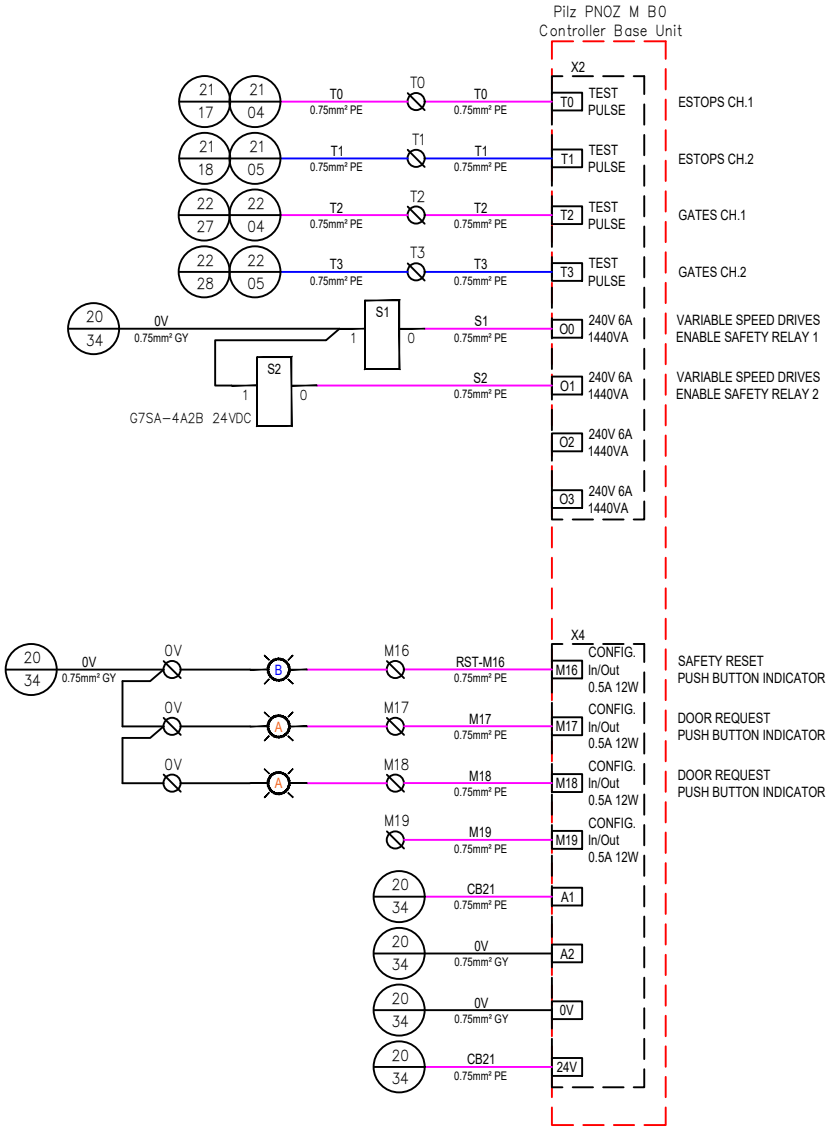

REV	DATE	DWN	CHK	APP	REVISION
E		0	1		2 3 4 5 6
D					
C					
B					
A	28/08/26	D.B.	C.W.	C.W.	REVISION ONE, AS BUILT

THIS DRAWING IS OWNED BY FBS SOLUTIONS FOOD AND BEVERAGES AND IS ISSUED ON THE UNDERSTANDING THAT IT MAY NOT BE COPIED OR REPRODUCED IN WHOLE OR IN PART WITHOUT WRITTEN PERMISSION. NOR IS INFORMATION TO BE FURNISHED FROM WHICH COULD BE INJURIOUS TO THE ABOVE COMPANY

SCALE: NOT TO SCALE

	NAME	DATE
DRAWN	D. BORG	28/08/26
DESIGN	D. BORG	28/08/26
CHECKED	C. WHITELEY	28/08/26
APPROVED	C. WHITELEY	28/08/26

PROJECT: 0 1 2 3 SCHLENKER 36/10

Serial No.: FBS Global Serial: 130039

FBS Solutions
45 Pelmet Cres, Thomastown VIC., Australia 3074
FOOD & BEVERAGE
Phone: +61 3 9191 2956
Contact: CLINT WHITELEY
Mobile: +61 418 383 441
E: enquiries@fbsglobal.com.au

DWG. NO.: 8001 A3


REVISION ONE, AS BUILT

SHEET TITLE: SAFETY CIRCUITS

REVISION A

SHEET 21

MODULE 1

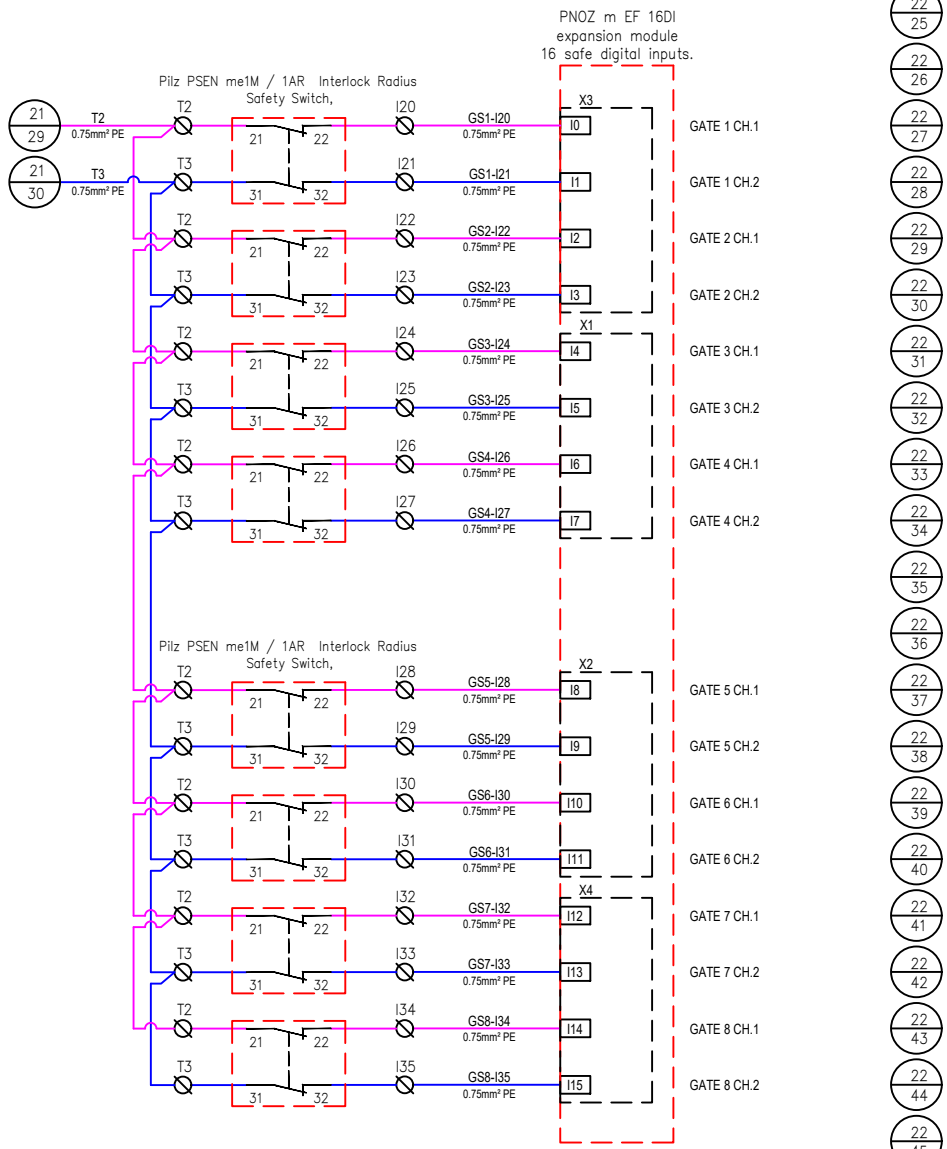

REV	DATE	DWN	CHK	APP	REVISION
A	28/08/26	D.B.	C.W.	C.W.	REVISION ONE, AS BUILT

THIS DRAWING IS OWNED BY FBS SOLUTIONS FOOD AND BEVERAGES AND IS ISSUED ON THE UNDERSTANDING THAT IT MAY NOT BE COPIED OR REPRODUCED IN WHOLE OR IN PART WITHOUT WRITTEN PERMISSION. NOR IS INFORMATION TO BE FURNISHED FROM WHICH COULD BE INJURIOUS TO THE ABOVE COMPANY

SCALE: NOT TO SCALE

	NAME	DATE
DRAWN	D. BORG	28/08/26
DESIGN	D. BORG	28/08/26
CHECKED	C. WHITELEY	28/08/26
APPROVED	C. WHITELEY	28/08/26

PROJECT: SCHLENKER 36/10

Serial No.: FBS Global Serial: 130039

FBS Solutions
45 Pelmet Cres, Thomastown VIC., Australia 3074
Phone: +61 3 9191 2956
Contact: CLINT WHITELEY
Mobile: +61 418 383 441
E: enquiries@fbsglobal.com.au
FOOD & BEVERAGE

DWG. NO.: 8001 A3


REVISION ONE, AS BUILT

SHEET TITLE: SAFETY CIRCUITS


REVISION A

SHEET 22

MODULE 2

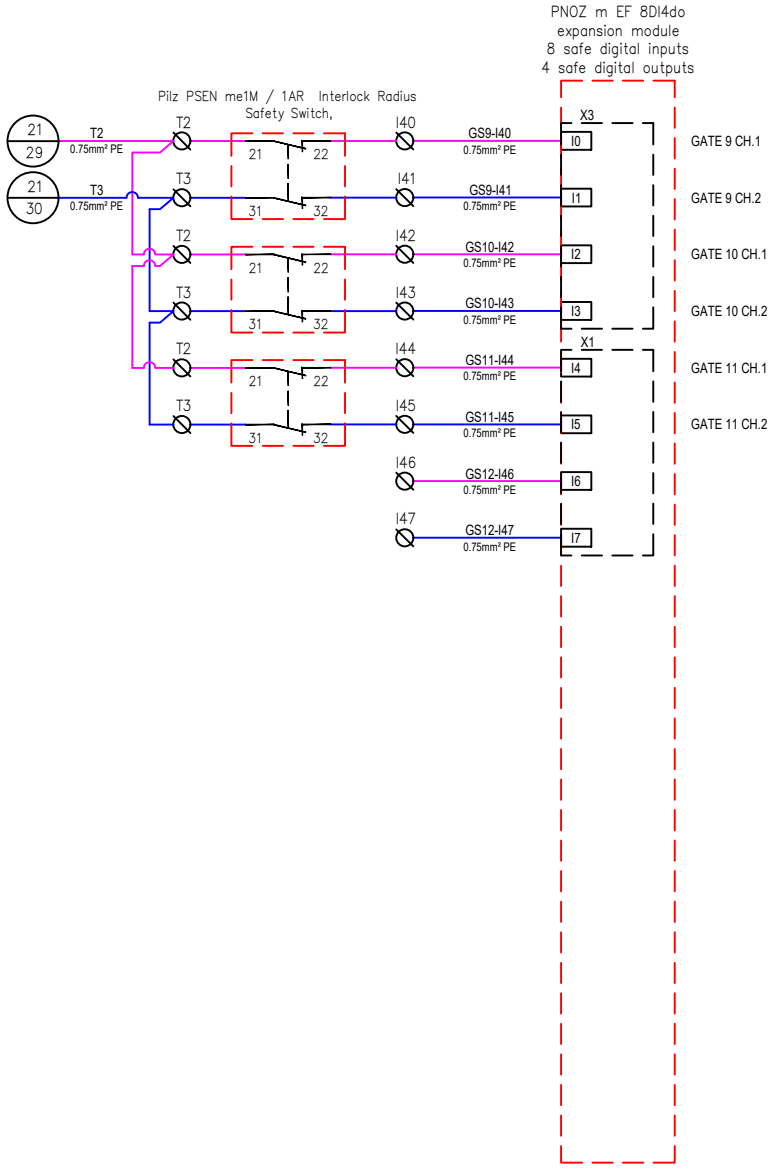

MODULE 2

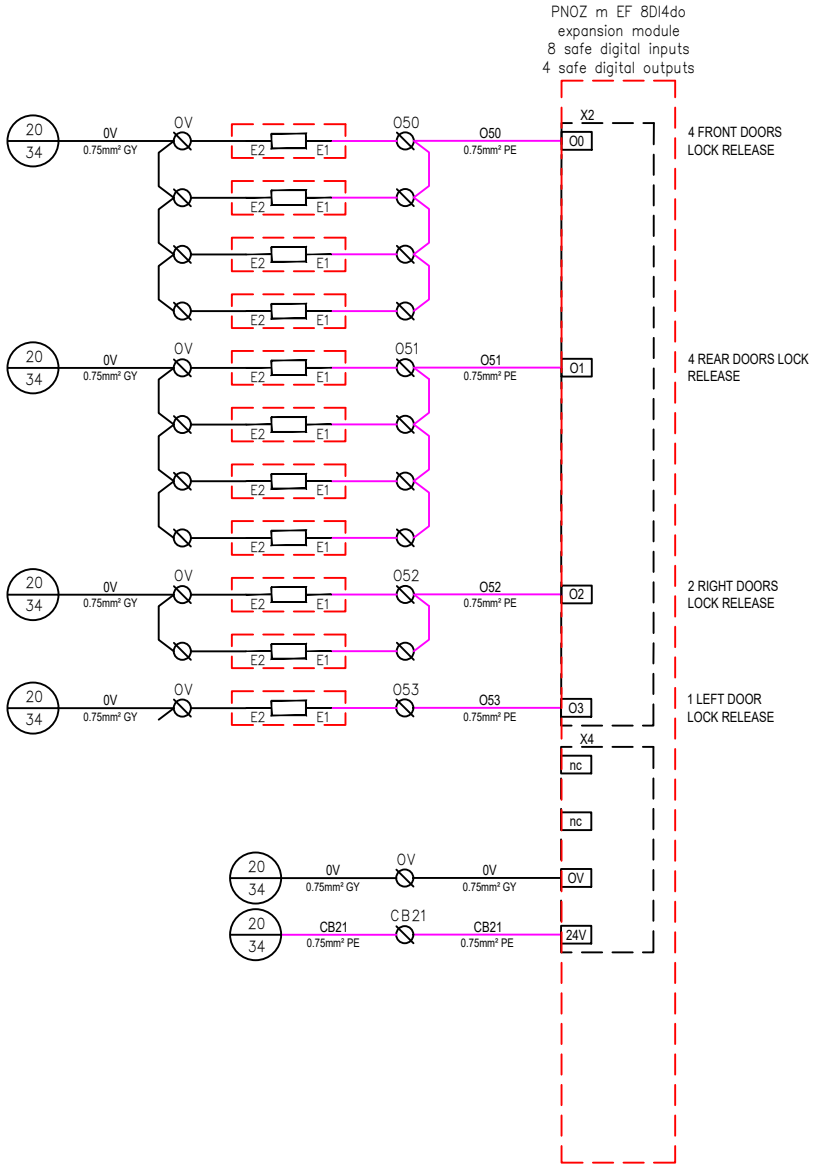

REV	DATE	DWN	CHK	APP	REVISION
E		0	1		2 3 4 5 6
D					
C					
B					
A	28/08/26	D.B.	C.W.	C.W.	REVISION ONE, AS BUILT

THIS DRAWING IS OWNED BY FBS SOLUTIONS FOOD AND BEVERAGES AND IS ISSUED ON THE UNDERSTANDING THAT IT MAY NOT BE COPIED OR REPRODUCED IN WHOLE OR IN PART WITHOUT WRITTEN PERMISSION. NOR IS INFORMATION TO BE FURNISHED FROM WHICH COULD BE INJURIOUS TO THE ABOVE COMPANY

SCALE: NOT TO SCALE

	NAME	DATE
DRAWN	D. BORG	28/08/26
DESIGN	D. BORG	28/08/26
CHECKED	C. WHITELEY	28/08/26
APPROVED	C. WHITELEY	28/08/26

PROJECT: SCHLENKER 36/10

Serial No.: FBS Global Serial: 130039

FBS Solutions
45 Pelmet Cres, Thomastown VIC., Australia 3074
FOOD & BEVERAGE
Phone: +61 3 9191 2956
Contact: CLINT WHITELEY
Mobile: +61 418 383 441
E: enquiries@fbsglobal.com.au


DWG. NO.: 8001 A3

REVISION ONE, AS BUILT

SHEET TITLE: SAFETY CIRCUITS

REVISION A

SHEET 23

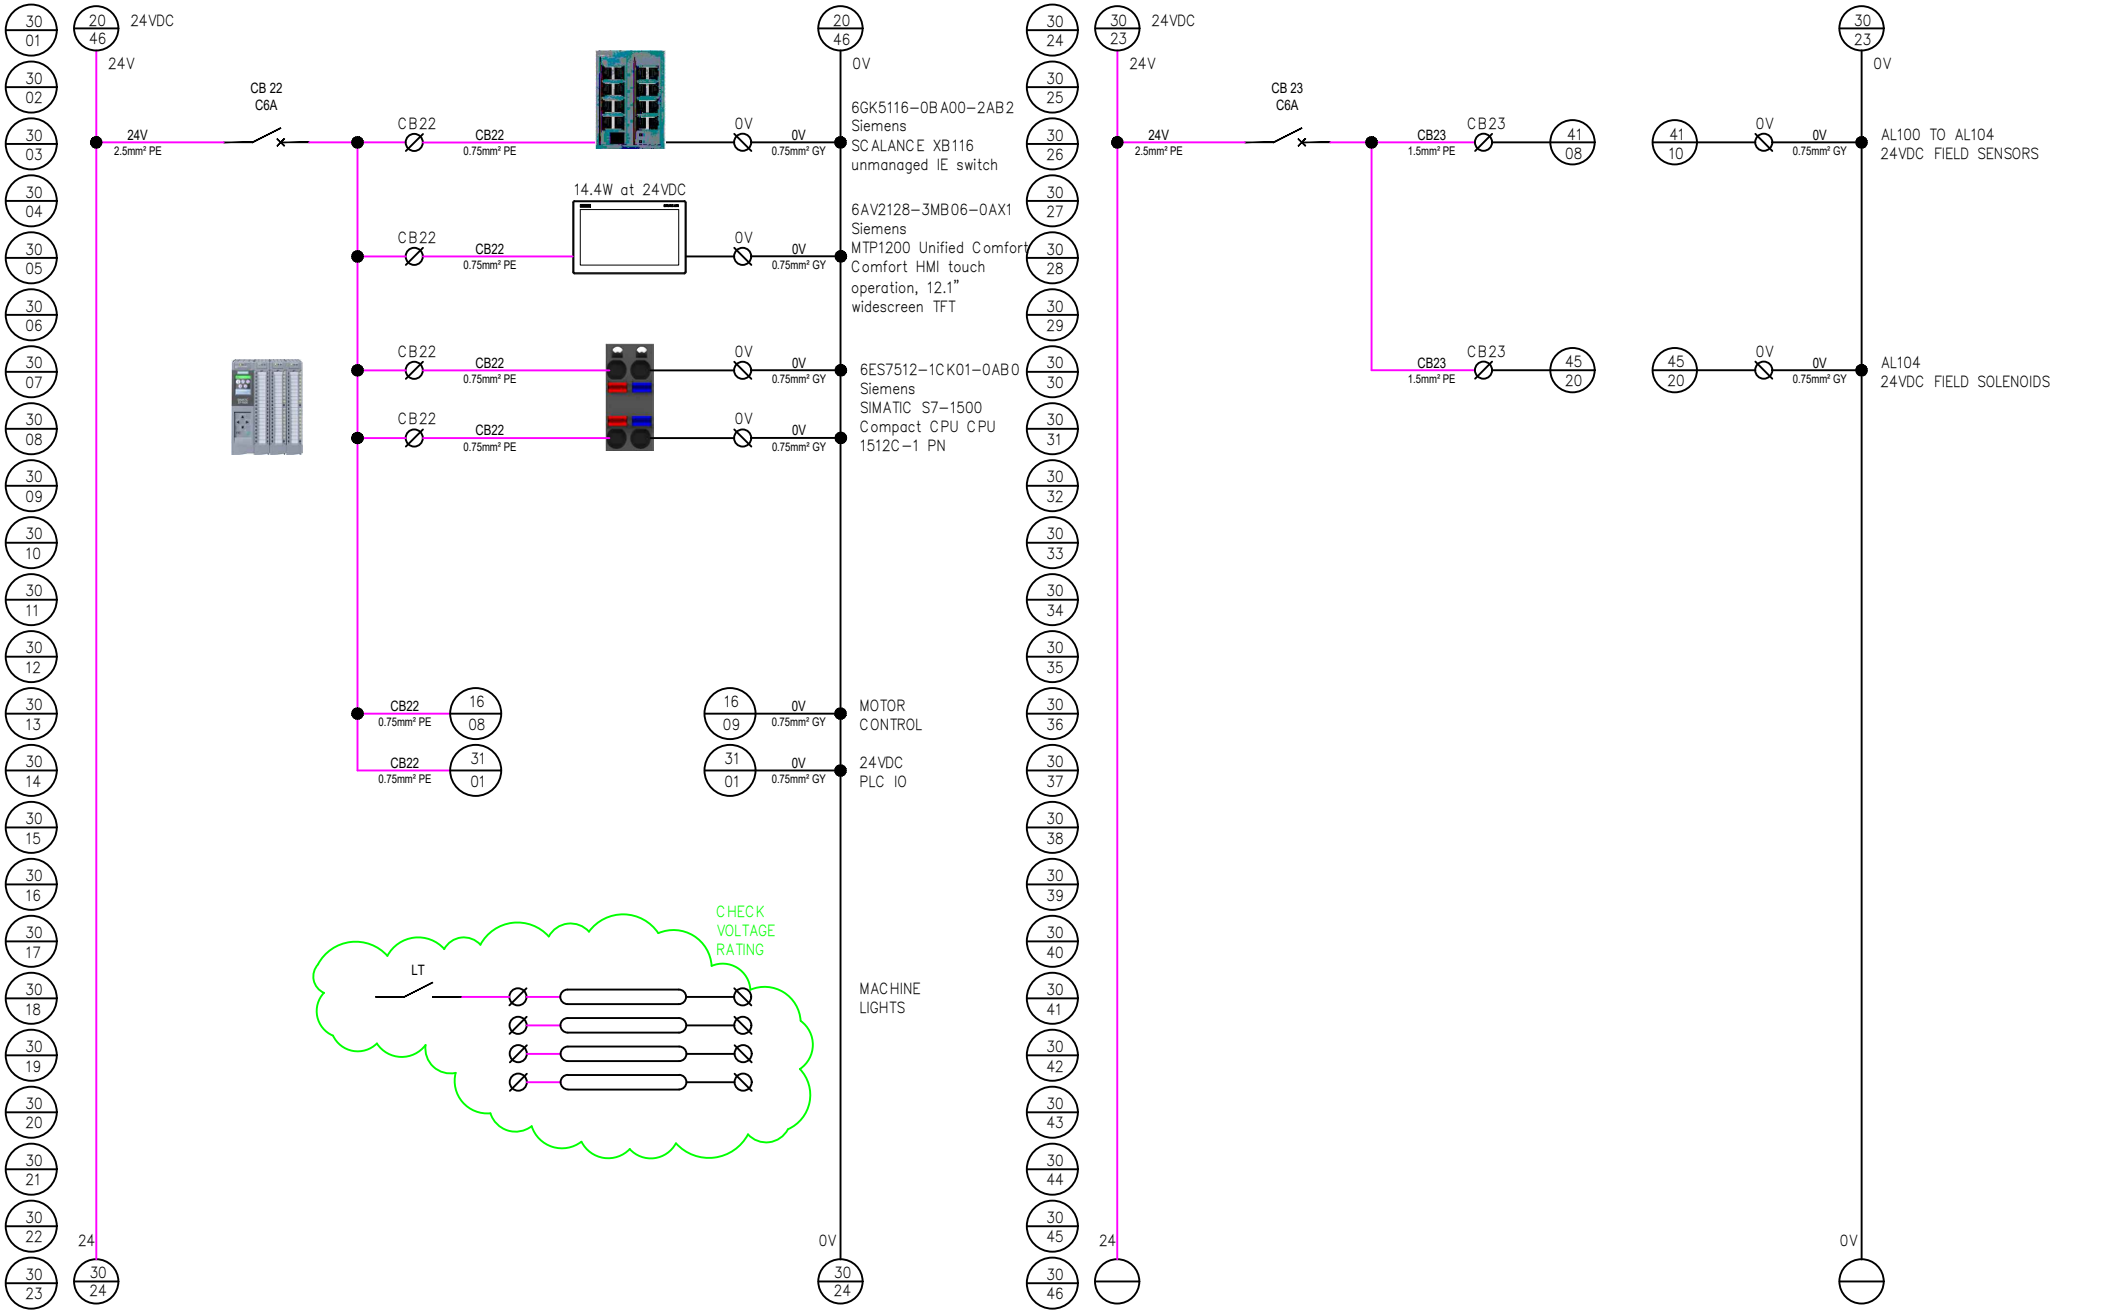

REV	DATE	DWN	CHK	APP	REVISION
E		0	1		2 3 4 5 6
D					
C					
B					
A	28/08/26	D.B.	C.W.	C.W.	REVISION ONE, AS BUILT

THIS DRAWING IS OWNED BY FBS SOLUTIONS FOOD AND BEVERAGES AND IS ISSUED ON THE UNDERSTANDING THAT IT MAY NOT BE COPIED OR REPRODUCED IN WHOLE OR IN PART WITHOUT WRITTEN PERMISSION. NOR IS INFORMATION TO BE FURNISHED FROM WHICH COULD BE INJURIOUS TO THE ABOVE COMPANY

SCALE: NOT TO SCALE

	NAME	DATE
DRAWN	D. BORG	28/08/26
DESIGN	D. BORG	28/08/26
CHECKED	C. WHITELEY	28/08/26
APPROVED	C. WHITELEY	28/08/26

PROJECT: SCHLENKER 36/10

Serial No.: FBS Global Serial: 130039

FBS Solutions
45 Pelmet Cres, Thomastown VIC., Australia 3074
FOOD & BEVERAGE
Phone: +61 3 9191 2956
Contact: CLINT WHITELEY
Mobile: +61 418 383 441
E: enquiries@fbsglobal.com.au


DWG. NO.: 8001 A3

REVISION ONE, AS BUILT

SHEET TITLE: CIRCUITS

REVISION A

SHEET 30

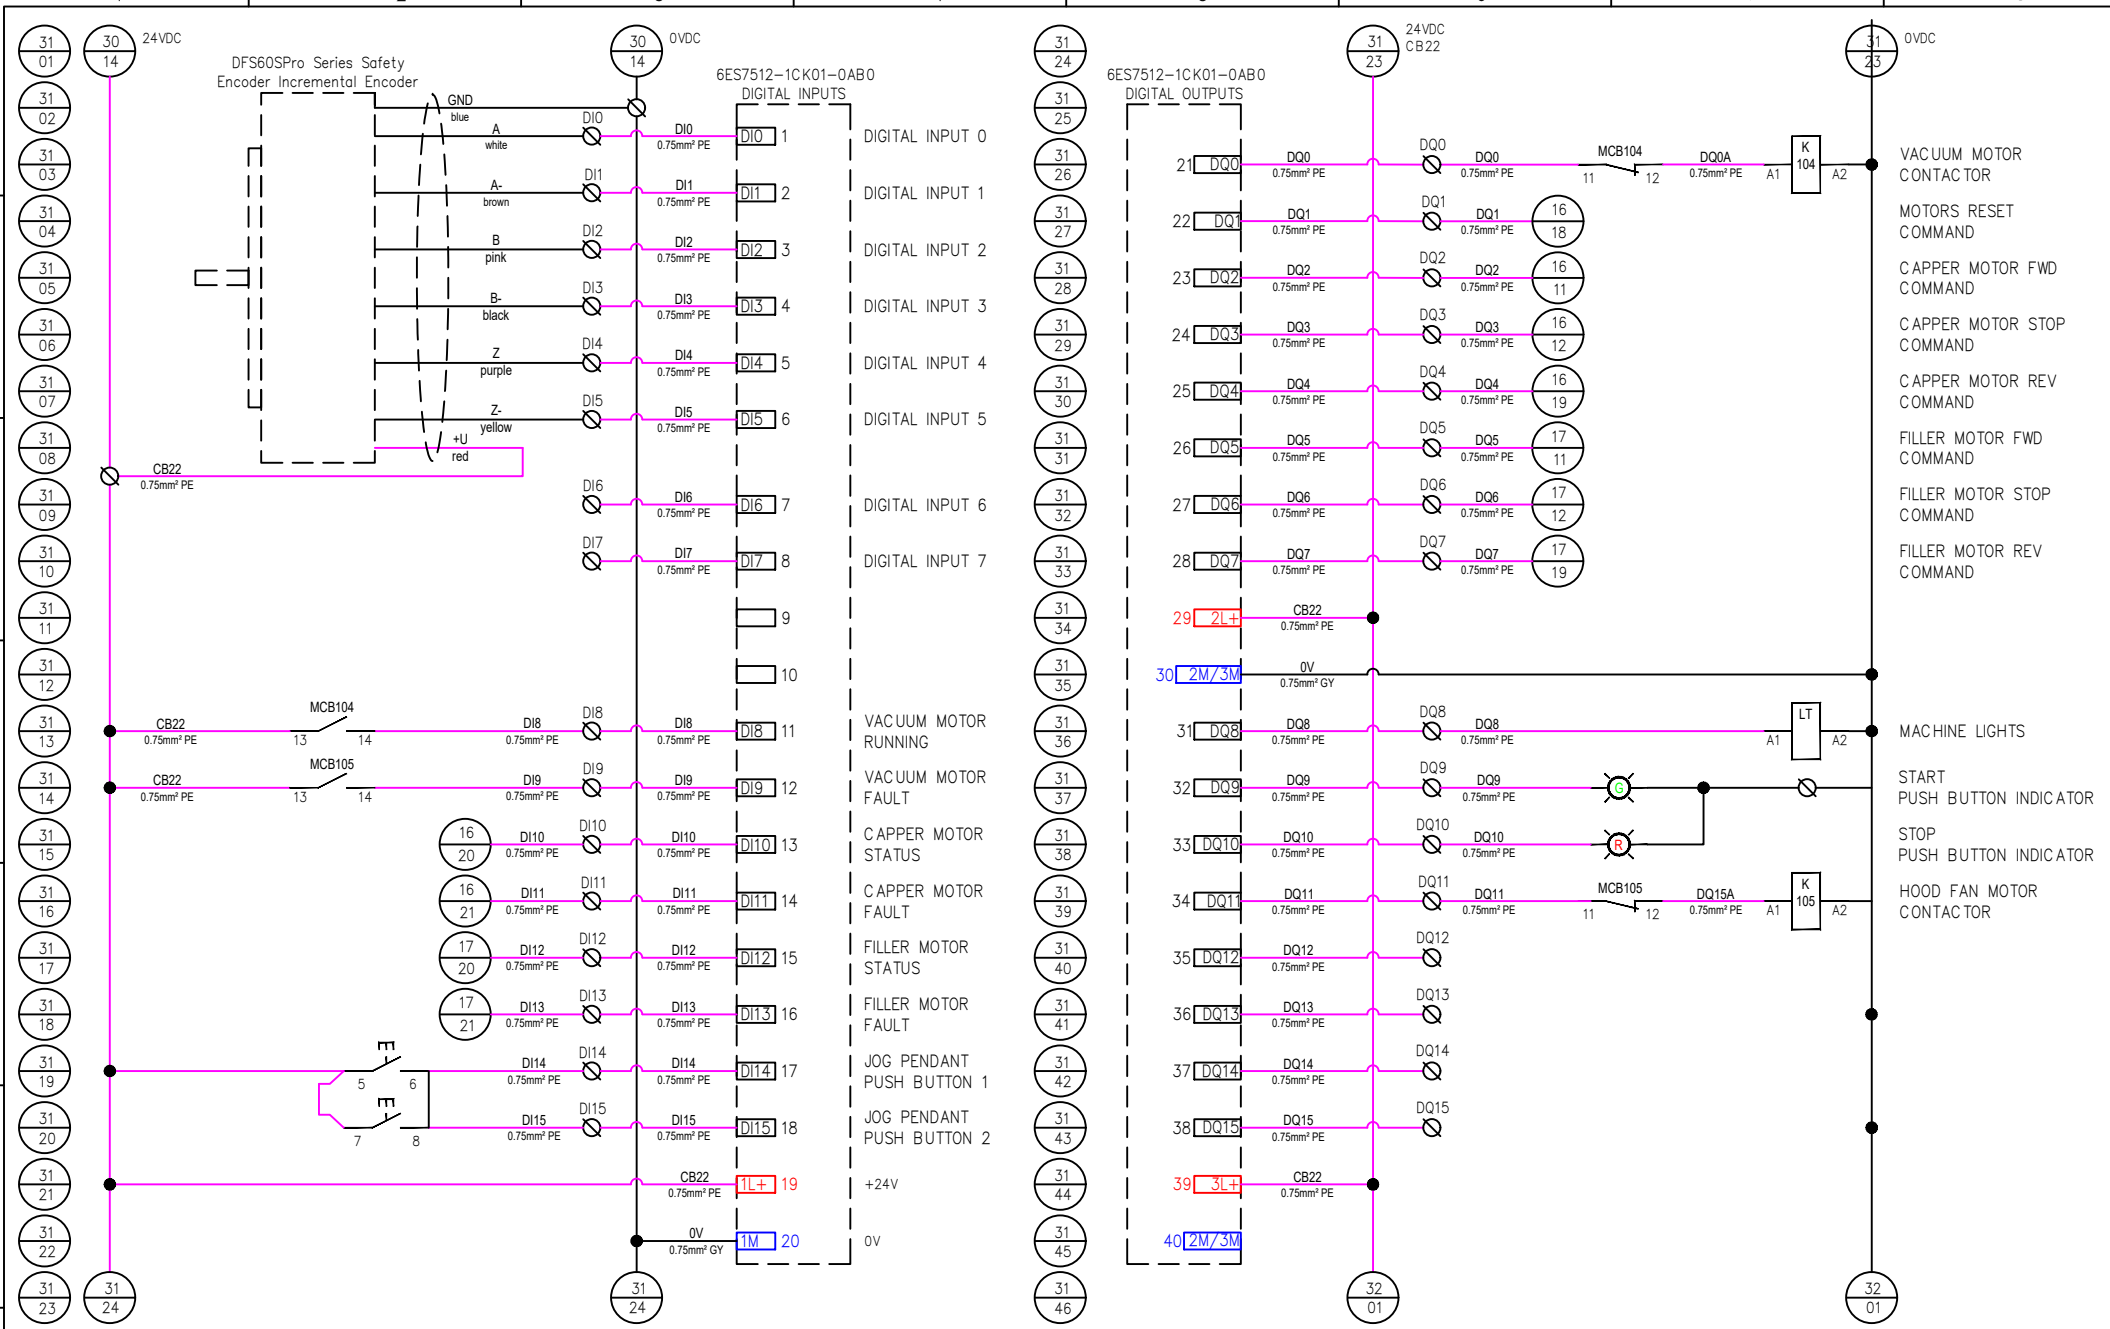

REV	DATE	DWN	CHK	APP	REVISION
E		0	1		2 3 4 5 6
D					
C					
B					
A	28/08/26	D.B.	C.W.	C.W.	REVISION ONE, AS BUILT

THIS DRAWING IS OWNED BY FBS SOLUTIONS FOOD AND BEVERAGES AND IS ISSUED ON THE UNDERSTANDING THAT IT MAY NOT BE COPIED OR REPRODUCED IN WHOLE OR IN PART WITHOUT WRITTEN PERMISSION. NOR IS INFORMATION TO BE FURNISHED FROM WHICH COULD BE INJURIOUS TO THE ABOVE COMPANY

SCALE: NOT TO SCALE

	NAME	DATE
DRAWN	D. BORG	28/08/26
DESIGN	D. BORG	28/08/26
CHECKED	C. WHITELEY	28/08/26
APPROVED	C. WHITELEY	28/08/26

PROJECT: SCHLENKER 36/10

Serial No.: FBS Global Serial: 130039

FBS Solutions
45 Pelmet Cres, Thomastown VIC., Australia 3074
FOOD & BEVERAGE
Phone: +61 3 9191 2956
Contact: CLINT WHITELEY
Mobile: +61 418 383 441
E: enquiries@fbsglobal.com.au


DWG. NO.: 8001 A3

REVISION ONE, AS BUILT

SHEET TITLE: DIGITAL INPUTS/OUTPUTS

REVISION A

SHEET 31

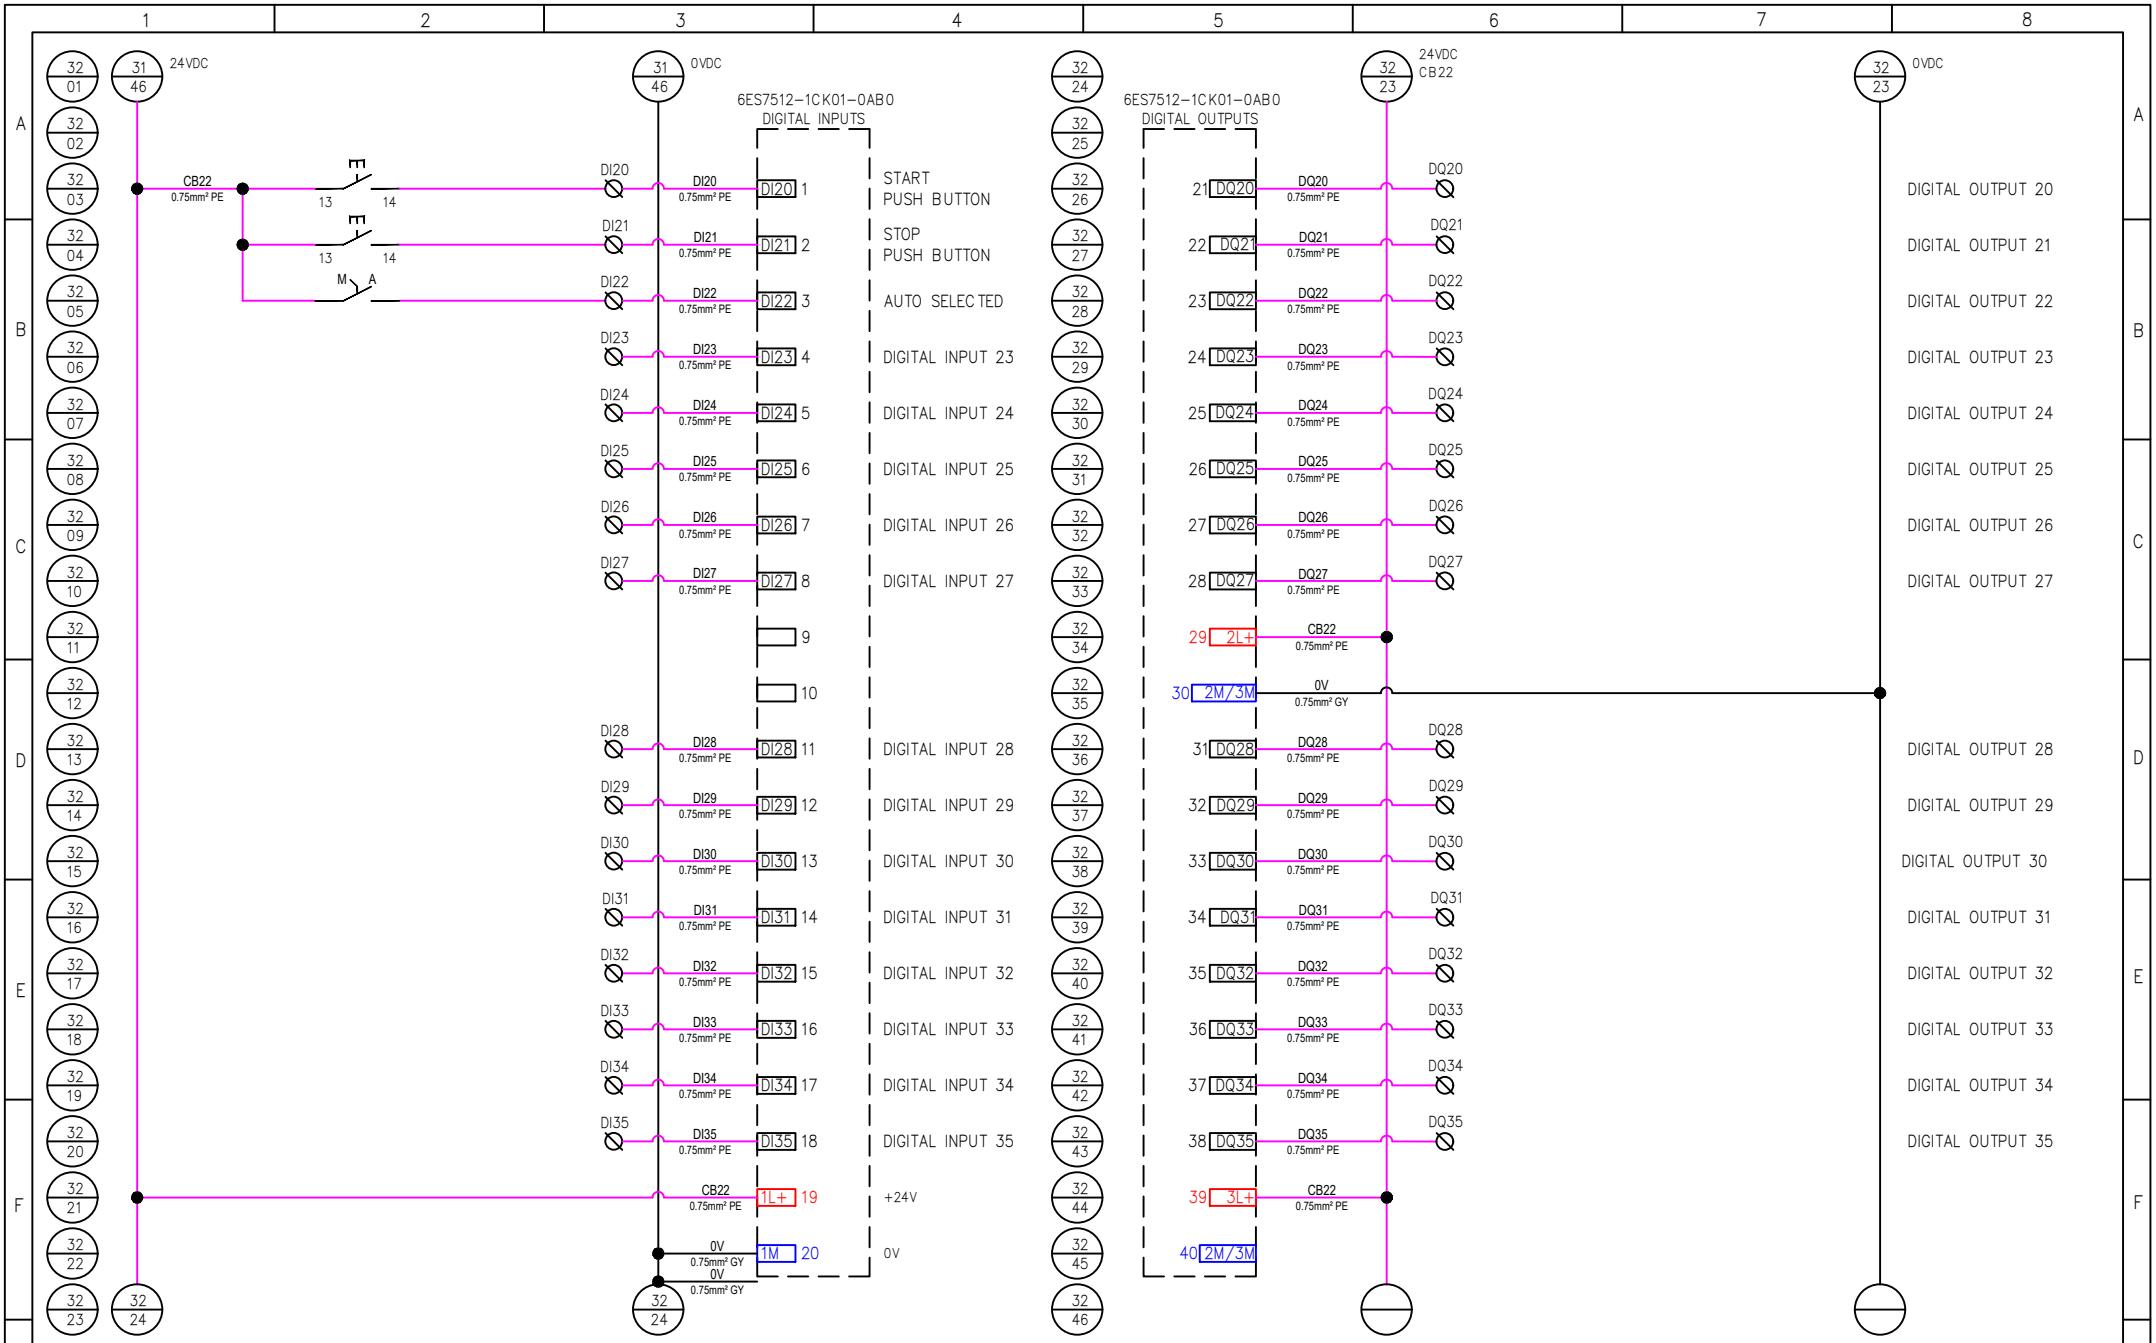

REV	DATE	DWN	CHK	APP	REVISION
A	28/08/26	D.B.	C.W.	C.W.	REVISION ONE, AS BUILT

THIS DRAWING IS OWNED BY FBS SOLUTIONS FOOD AND BEVERAGES AND IS ISSUED ON THE UNDERSTANDING THAT IT MAY NOT BE COPIED OR REPRODUCED IN WHOLE OR IN PART WITHOUT WRITTEN PERMISSION. NOR IS INFORMATION TO BE FURNISHED FROM WHICH COULD BE INJURIOUS TO THE ABOVE COMPANY

SCALE: NOT TO SCALE

	NAME	DATE
DRAWN	D. BORG	28/08/26
DESIGN	D. BORG	28/08/26
CHECKED	C. WHITELEY	28/08/26
APPROVED	C. WHITELEY	28/08/26

PROJECT: SCHLENKER 36/10

Serial No.: FBS Global Serial: 130039

FBS Solutions
45 Pelmet Cres, Thomastown VIC., Australia 3074
FOOD & BEVERAGE
Phone: +61 3 9191 2956
Contact: CLINT WHITELEY
Mobile: +61 418 383 441
E: enquiries@fbsglobal.com.au


DWG. NO.: 8001 A3

REVISION ONE, AS BUILT

SHEET TITLE: DIGITAL INPUTS/OUTPUTS

REVISION A

SHEET 32

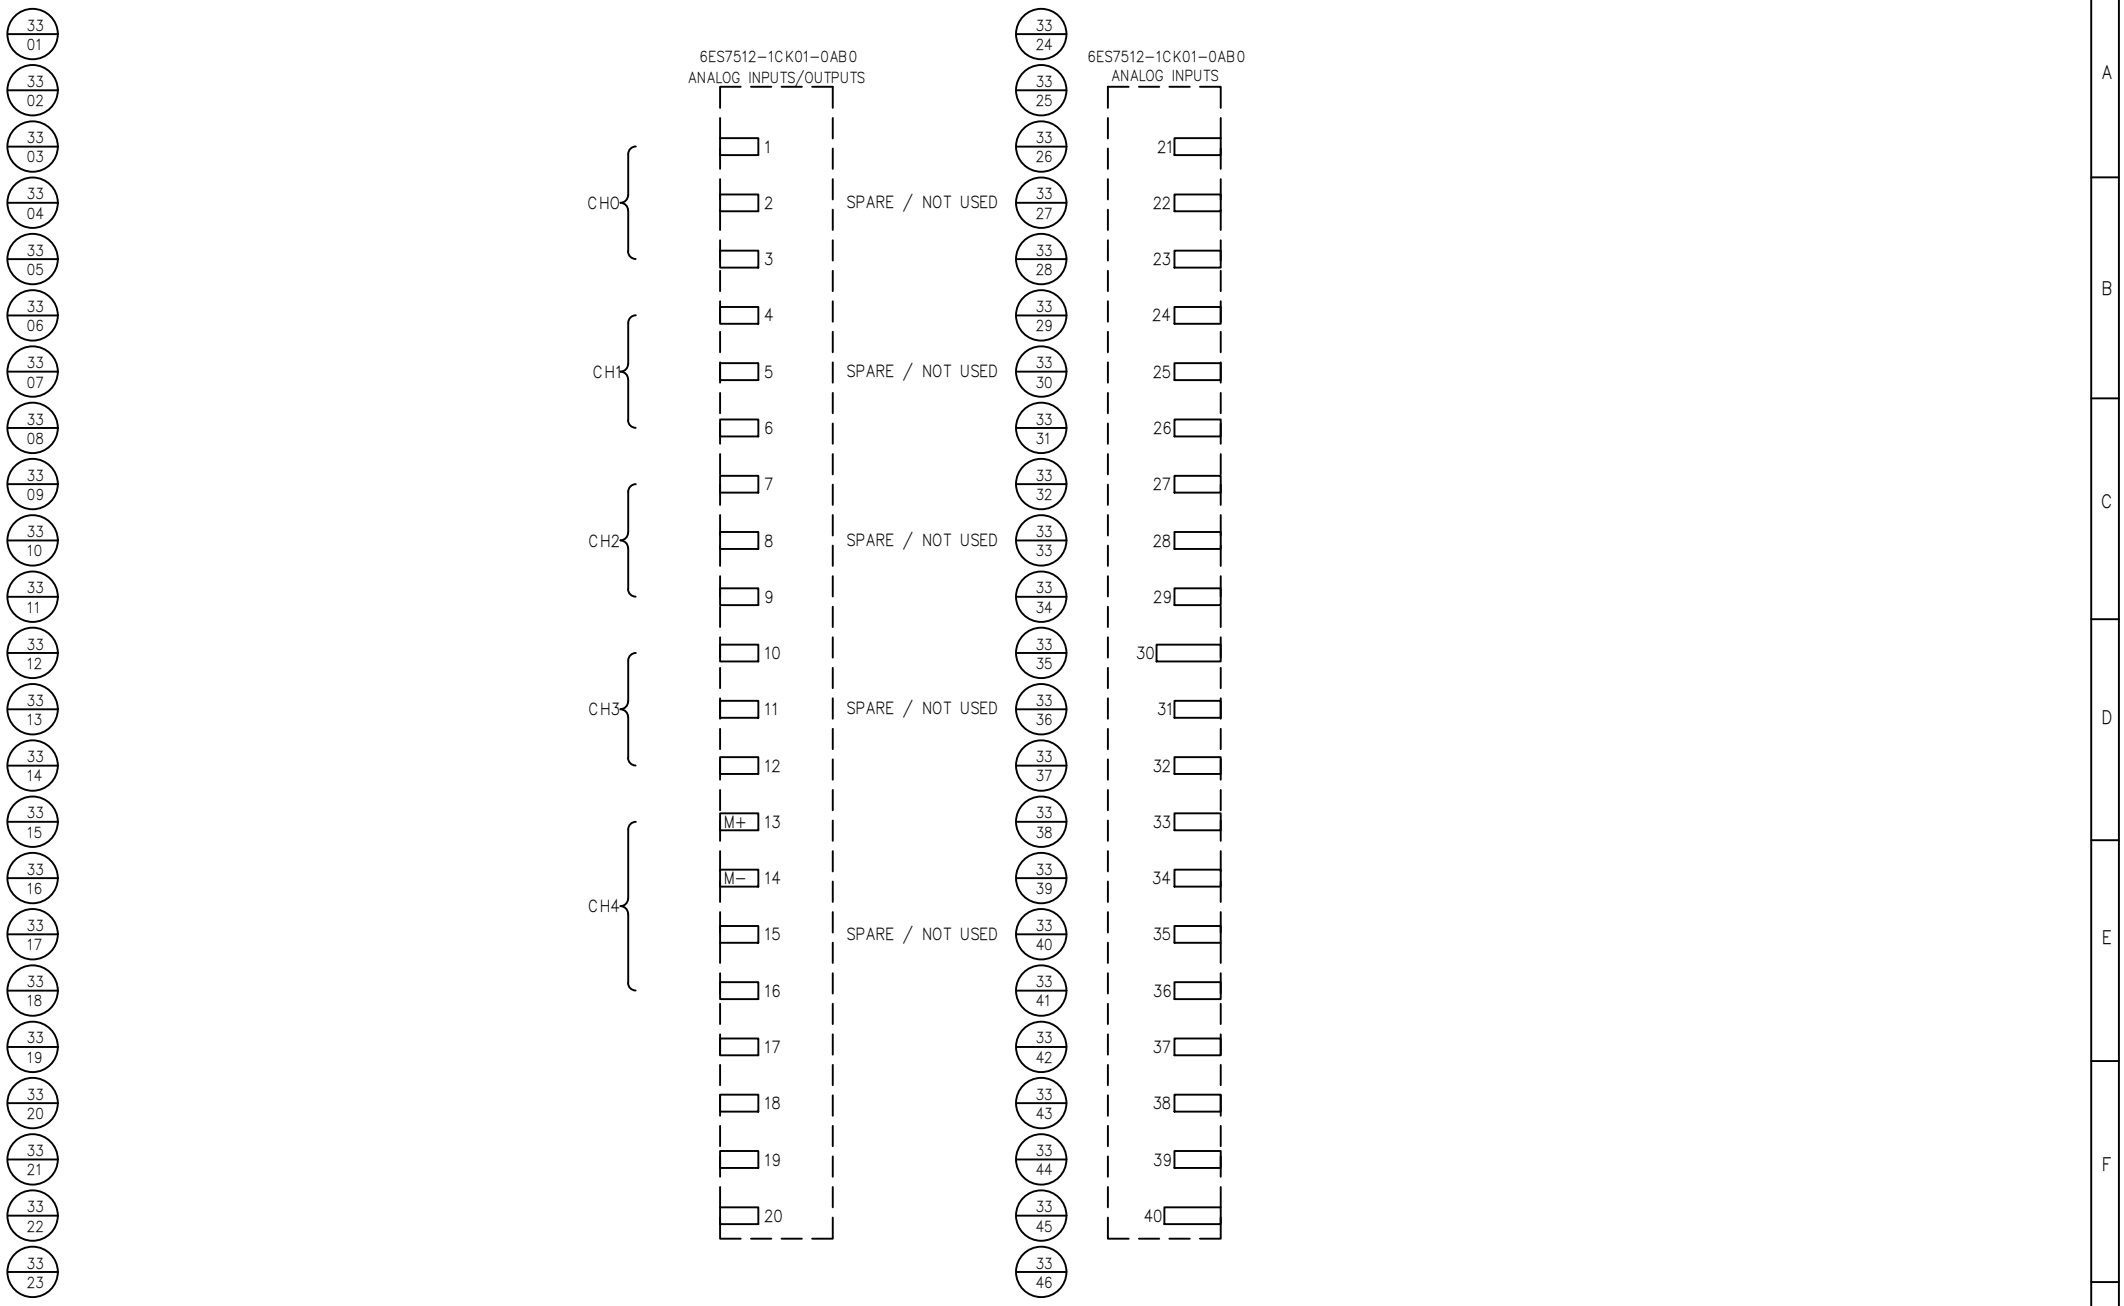

REV	DATE	DWN	CHK	APP	REVISION
A	28/08/26	D.B.	C.W.	C.W.	REVISION ONE, AS BUILT

THIS DRAWING IS OWNED BY FBS SOLUTIONS FOOD AND BEVERAGES AND IS ISSUED ON THE UNDERSTANDING THAT IT MAY NOT BE COPIED OR REPRODUCED IN WHOLE OR IN PART WITHOUT WRITTEN PERMISSION. NOR IS INFORMATION TO BE FURNISHED FROM WHICH COULD BE INJURIOUS TO THE ABOVE COMPANY

SCALE: NOT TO SCALE

	NAME	DATE
DRAWN	D. BORG	28/08/26
DESIGN	D. BORG	28/08/26
CHECKED	C. WHITELEY	28/08/26
APPROVED	C. WHITELEY	28/08/26

PROJECT: SCHLENKER 36/10

Serial No.: FBS Global Serial: 130039

FBS Solutions
45 Pelmet Cres, Thomastown VIC., Australia 3074
FOOD & BEVERAGE
Phone: +61 3 9191 2956
Contact: CLINT WHITELEY
Mobile: +61 418 383 441
E: enquiries@fbsglobal.com.au


DWG. NO.: 8001 A3

REVISION ONE, AS BUILT

SHEET TITLE: ANALOG INPUTS/OUTPUTS

REVISION A

SHEET 33

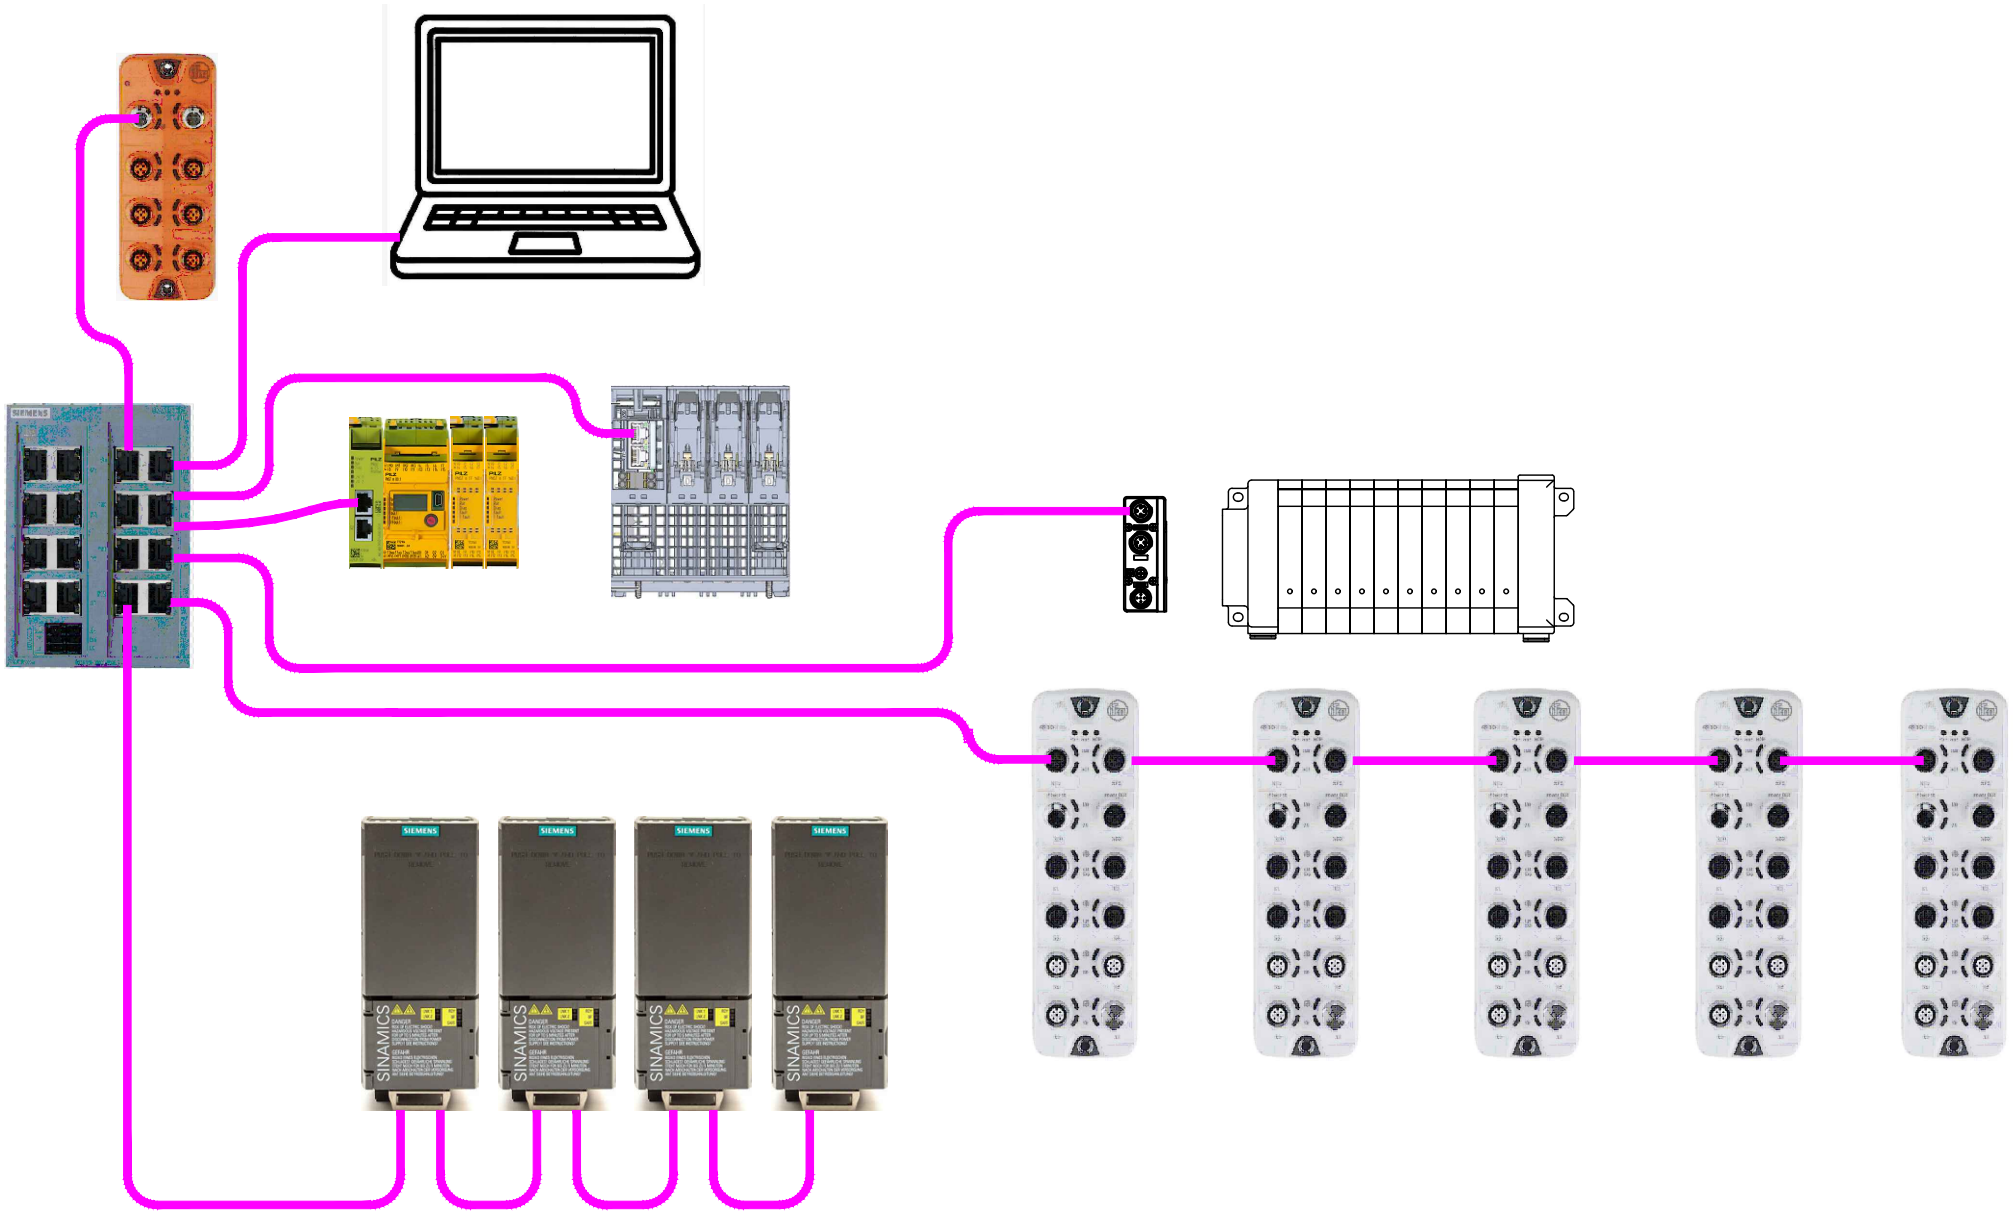

REV	DATE	DWN	CHK	APP	REVISION
E					
D					
C					
B					
A	28/08/26	D.B.	C.W.	C.W.	REVISION ONE, AS BUILT

THIS DRAWING IS OWNED BY FBS SOLUTIONS FOOD AND BEVERAGES AND IS ISSUED ON THE UNDERSTANDING THAT IT MAY NOT BE COPIED OR REPRODUCED IN WHOLE OR IN PART WITHOUT WRITTEN PERMISSION. NOR IS INFORMATION TO BE FURNISHED FROM WHICH COULD BE INJURIOUS TO THE ABOVE COMPANY

SCALE: NOT TO SCALE

	NAME	DATE
DRAWN	D. BORG	28/08/26
DESIGN	D. BORG	28/08/26
CHECKED	C. WHITELEY	28/08/26
APPROVED	C. WHITELEY	28/08/26

PROJECT: SCHLENKER 36/10

Serial No.: FBS Global Serial: 130039

FBS Solutions
45 Pelmet Cres, Thomastown VIC., Australia 3074
FOOD & BEVERAGE
Phone: +61 3 9191 2956
Contact: CLINT WHITELEY
Mobile: +61 418 383 441
E: enquiries@fbsglobal.com.au

DWG. NO.: 8001 A3


REVISION ONE, AS BUILT

SHEET TITLE: NETWORK TYPOLOGY

REVISION A

SHEET 40

AL100
BOTTLE AND ACCUMULATION SENSORS

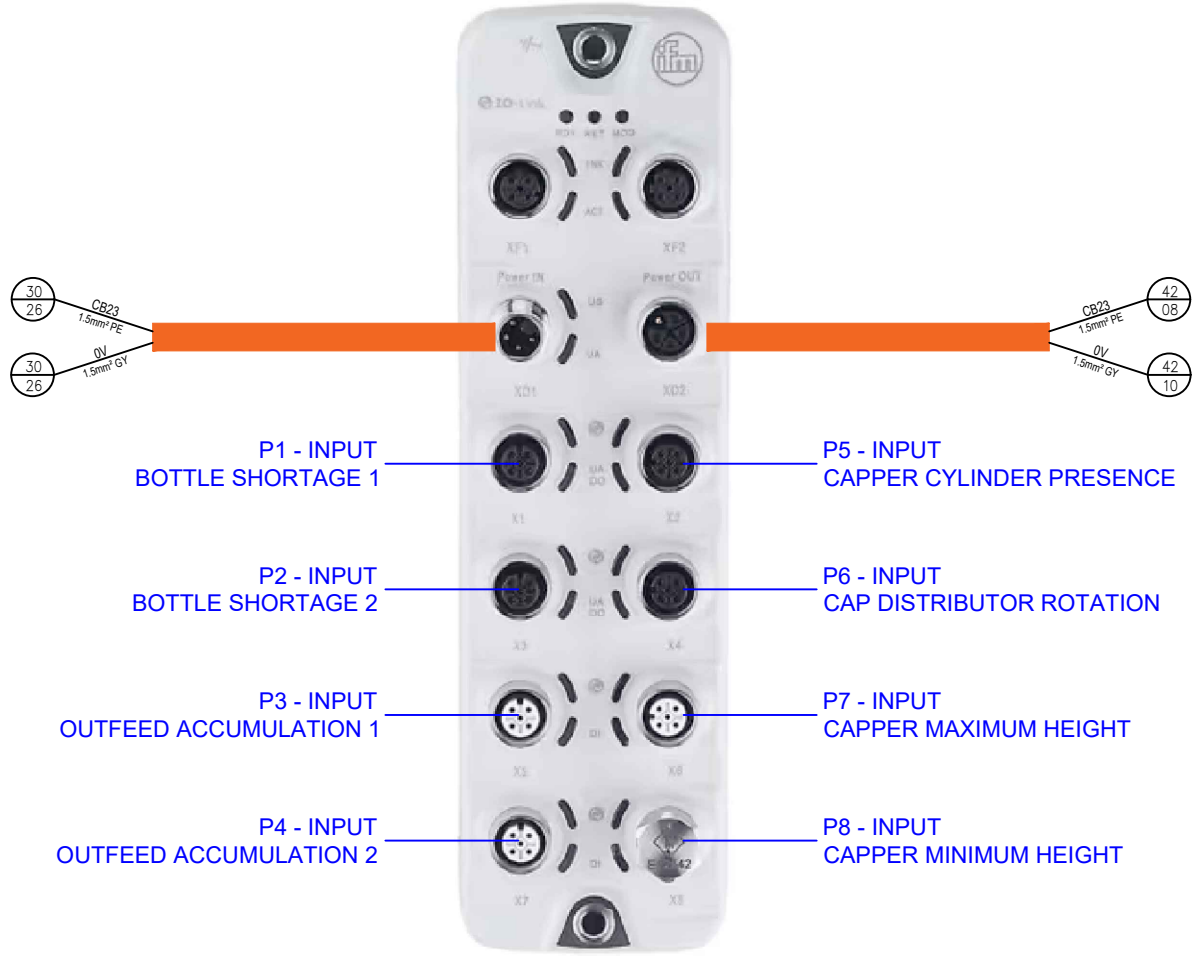

REV	DATE	DWN	CHK	APP	REVISION
E					
D					
C					
B					
A	28/08/26	D.B.	C.W.	C.W.	REVISION ONE, AS BUILT

THIS DRAWING IS OWNED BY FBS SOLUTIONS FOOD AND BEVERAGES AND IS ISSUED ON THE UNDERSTANDING THAT IT MAY NOT BE COPIED OR REPRODUCED IN WHOLE OR IN PART WITHOUT WRITTEN PERMISSION. NOR IS INFORMATION TO BE FURNISHED FROM WHICH COULD BE INJURIOUS TO THE ABOVE COMPANY

SCALE: NOT TO SCALE

	NAME	DATE
DRAWN	D. BORG	28/08/26
DESIGN	D. BORG	28/08/26
CHECKED	C. WHITELEY	28/08/26
APPROVED	C. WHITELEY	28/08/26

PROJECT: SCHLENKER 36/10

Serial No.: FBS Global Serial: 130039

FBS Solutions
45 Pelmet Cres, Thomastown VIC., Australia 3074
FOOD & BEVERAGE
Phone: +61 3 9191 2956
Contact: CLINT WHITELEY
Mobile: +61 418 383 441
E: enquiries@fbsglobal.com.au

DWG. NO.: 8001 A3


REVISION ONE, AS BUILT

SHEET TITLE: FIELD SENSORS

REVISION A

SHEET 41

AL101
CAP SYSTEM AND AIR PRESSURE

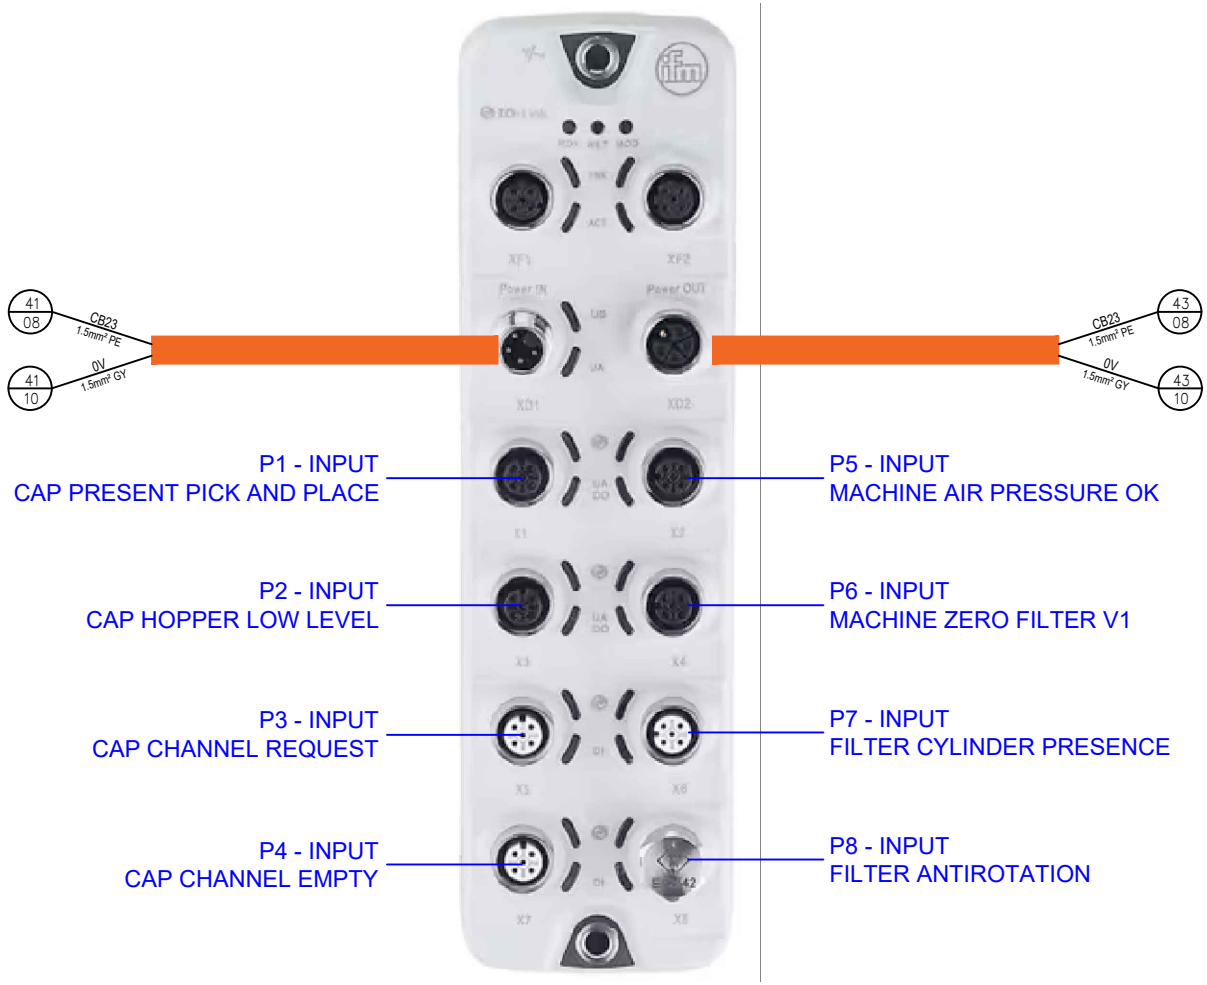

REV	DATE	DWN	CHK	APP	REVISION
E					
D					
C					
B					
A	28/08/26	D.B.	C.W.	C.W.	REVISION ONE, AS BUILT

THIS DRAWING IS OWNED BY FBS SOLUTIONS FOOD AND BEVERAGES AND IS ISSUED ON THE UNDERSTANDING THAT IT MAY NOT BE COPIED OR REPRODUCED IN WHOLE OR IN PART WITHOUT WRITTEN PERMISSION. NOR IS INFORMATION TO BE FURNISHED FROM WHICH COULD BE INJURIOUS TO THE ABOVE COMPANY

SCALE: NOT TO SCALE

	NAME	DATE
DRAWN	D. BORG	28/08/26
DESIGN	D. BORG	28/08/26
CHECKED	C. WHITELEY	28/08/26
APPROVED	C. WHITELEY	28/08/26

PROJECT: SCHLENKER 36/10

Serial No.: FBS Global Serial: 130039

FBS Solutions
45 Pelmet Cres, Thomastown VIC., Australia 3074
FOOD & BEVERAGE
Phone: +61 3 9191 2956
Contact: CLINT WHITELEY
Mobile: +61 418 383 441
E: enquiries@fbsglobal.com.au

DWG. NO.: 8001 A3


REVISION ONE, AS BUILT

SHEET TITLE: FIELD SENSORS

REVISION A

SHEET 42

AL102
PROCESS INSTRUMENTATION

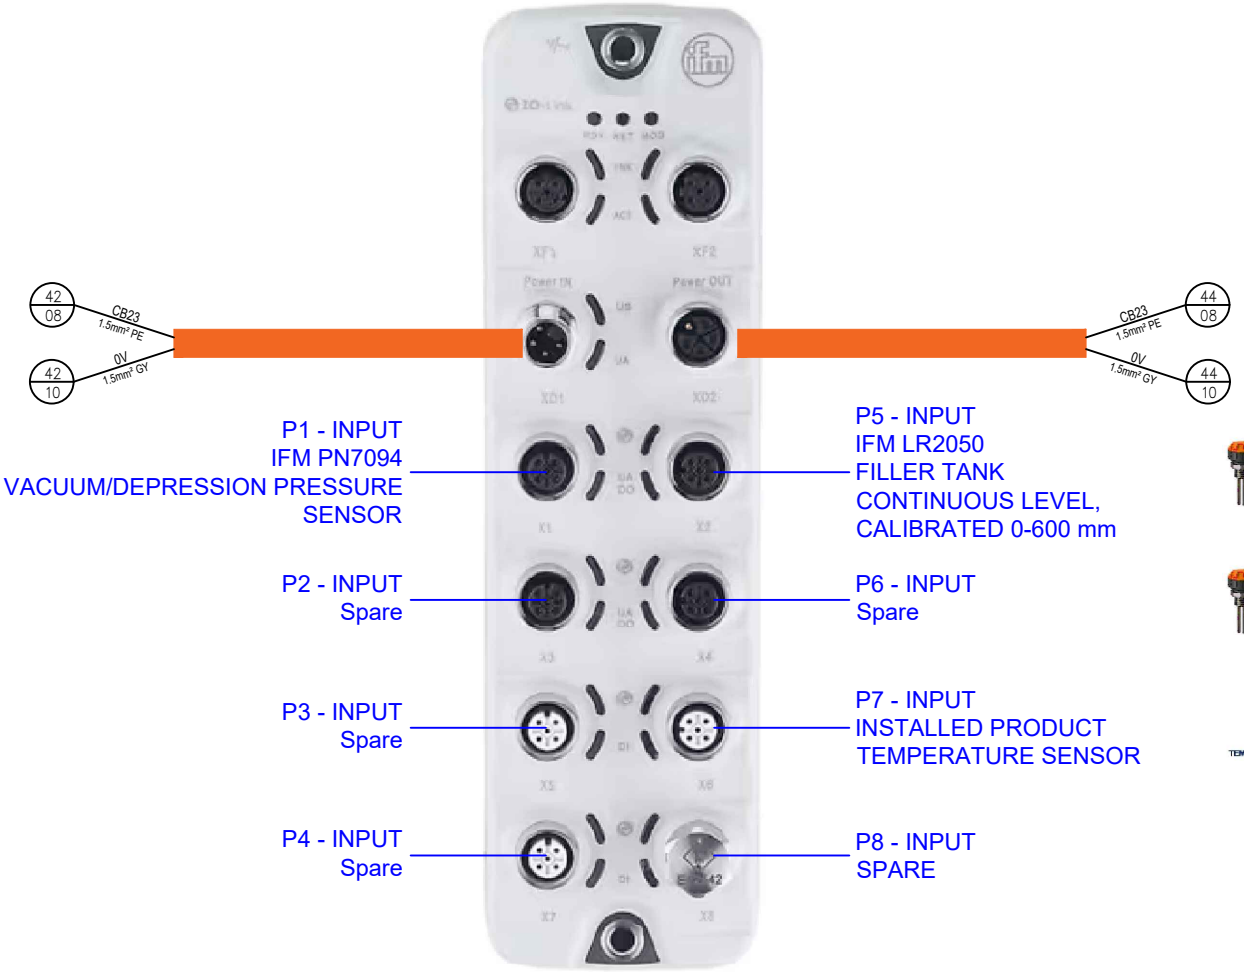

REV	DATE	DWN	CHK	APP	REVISION
E					
D					
C					
B					
A	28/08/26	D.B.	C.W.	C.W.	REVISION ONE, AS BUILT

THIS DRAWING IS OWNED BY FBS SOLUTIONS FOOD AND BEVERAGES AND IS ISSUED ON THE UNDERSTANDING THAT IT MAY NOT BE COPIED OR REPRODUCED IN WHOLE OR IN PART WITHOUT WRITTEN PERMISSION. NOR IS INFORMATION TO BE FURNISHED FROM WHICH COULD BE INJURIOUS TO THE ABOVE COMPANY

SCALE: NOT TO SCALE

	NAME	DATE
DRAWN	D. BORG	28/08/26
DESIGN	D. BORG	28/08/26
CHECKED	C. WHITELEY	28/08/26
APPROVED	C. WHITELEY	28/08/26

PROJECT: SCHLENKER 36/10

Serial No.: FBS Global Serial: 130039

FBS Solutions
45 Pelmet Cres, Thomastown VIC., Australia 3074
FOOD & BEVERAGE
Phone: +61 3 9191 2956
Contact: CLINT WHITELEY
Mobile: +61 418 383 441
E: enquiries@fbsglobal.com.au

DWG. NO.: 8001 A3


REVISION ONE, AS BUILT

SHEET TITLE: FIELD SENSORS

REVISION A

SHEET 43

AL103

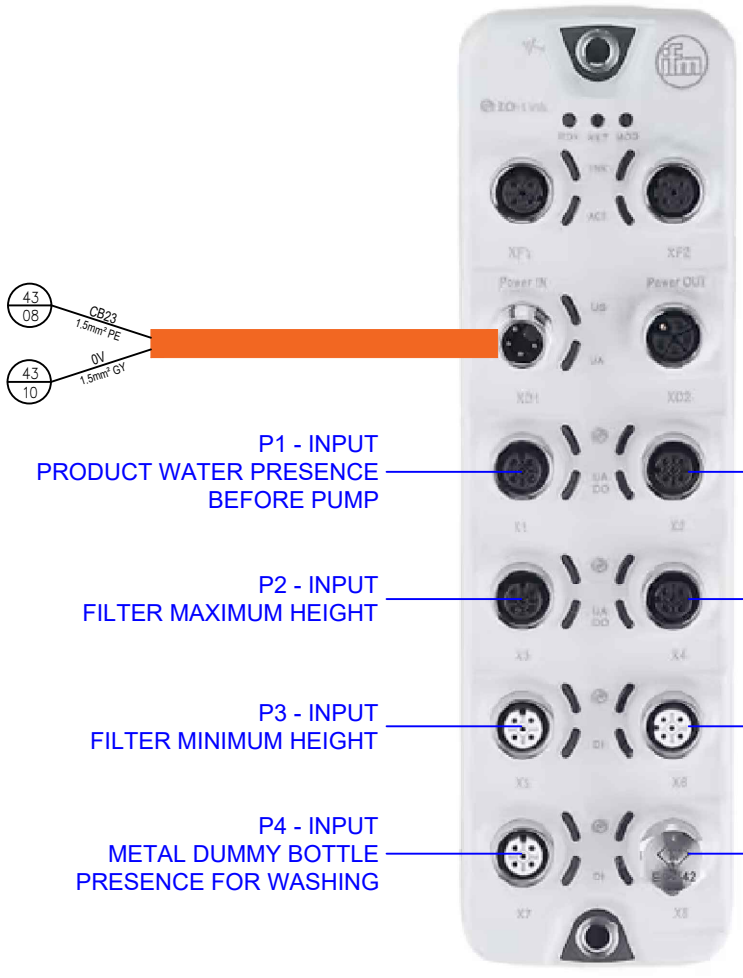

REV	DATE	DWN	CHK	APP	REVISION
E					
D					
C					
B					
A	28/08/26	D.B.	C.W.	C.W.	REVISION ONE, AS BUILT

THIS DRAWING IS OWNED BY FBS SOLUTIONS FOOD AND BEVERAGES AND IS ISSUED ON THE UNDERSTANDING THAT IT MAY NOT BE COPIED OR REPRODUCED IN WHOLE OR IN PART WITHOUT WRITTEN PERMISSION. NOR IS INFORMATION TO BE FURNISHED FROM WHICH COULD BE INJURIOUS TO THE ABOVE COMPANY

SCALE: NOT TO SCALE

	NAME	DATE
DRAWN	D. BORG	28/08/26
DESIGN	D. BORG	28/08/26
CHECKED	C. WHITELEY	28/08/26
APPROVED	C. WHITELEY	28/08/26

PROJECT: SCHLENKER 36/10

Serial No.: FBS Global Serial: 130039

FBS Solutions
45 Pelmet Cres, Thomastown VIC., Australia 3074
FOOD & BEVERAGE
Phone: +61 3 9191 2956
Contact: CLINT WHITELEY
Mobile: +61 418 383 441
E: enquiries@fbsglobal.com.au

DWG. NO.: 8001 A3


REVISION ONE, AS BUILT

SHEET TITLE: FIELD SENSORS

REVISION A

SHEET 44

AL104

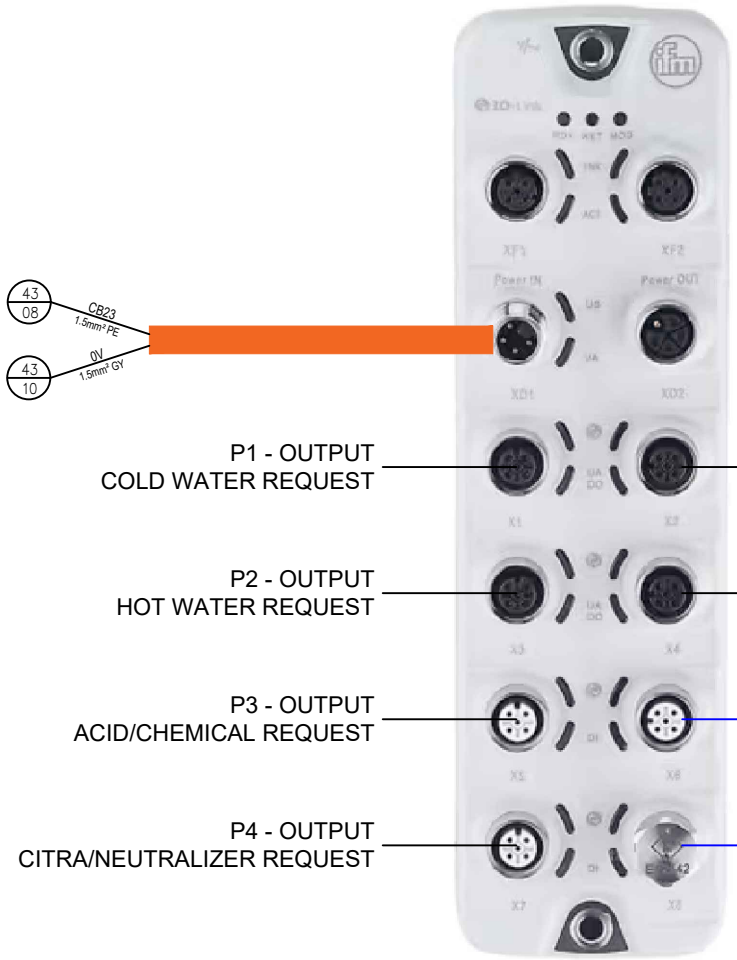

REV	DATE	DWN	CHK	APP	REVISION
E					
D					
C					
B					
A	28/08/26	D.B.	C.W.	C.W.	REVISION ONE, AS BUILT

THIS DRAWING IS OWNED BY FBS SOLUTIONS FOOD AND BEVERAGES AND IS ISSUED ON THE UNDERSTANDING THAT IT MAY NOT BE COPIED OR REPRODUCED IN WHOLE OR IN PART WITHOUT WRITTEN PERMISSION. NOR IS INFORMATION TO BE FURNISHED FROM WHICH COULD BE INJURIOUS TO THE ABOVE COMPANY

SCALE: NOT TO SCALE

	NAME	DATE
DRAWN	D. BORG	28/08/26
DESIGN	D. BORG	28/08/26
CHECKED	C. WHITELEY	28/08/26
APPROVED	C. WHITELEY	28/08/26

PROJECT: SCHLENKER 36/10

Serial No.: FBS Global Serial: 130039

FBS Solutions
45 Pelmet Cres, Thomastown VIC., Australia 3074
FOOD & BEVERAGE
Phone: +61 3 9191 2956
Contact: CLINT WHITELEY
Mobile: +61 418 383 441
E: enquiries@fbsglobal.com.au

DWG. NO.: 8001 A3


REVISION ONE, AS BUILT


SHEET TITLE: FIELD COMPONENTS

REVISION A

SHEET 45

ANYBUS
SMC EX260

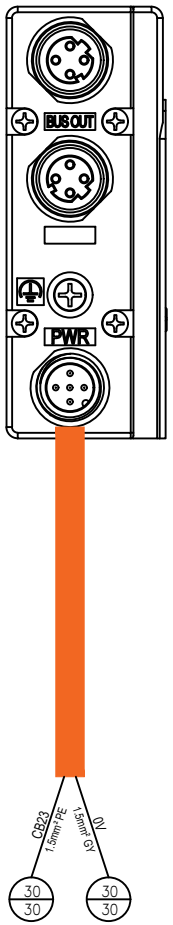

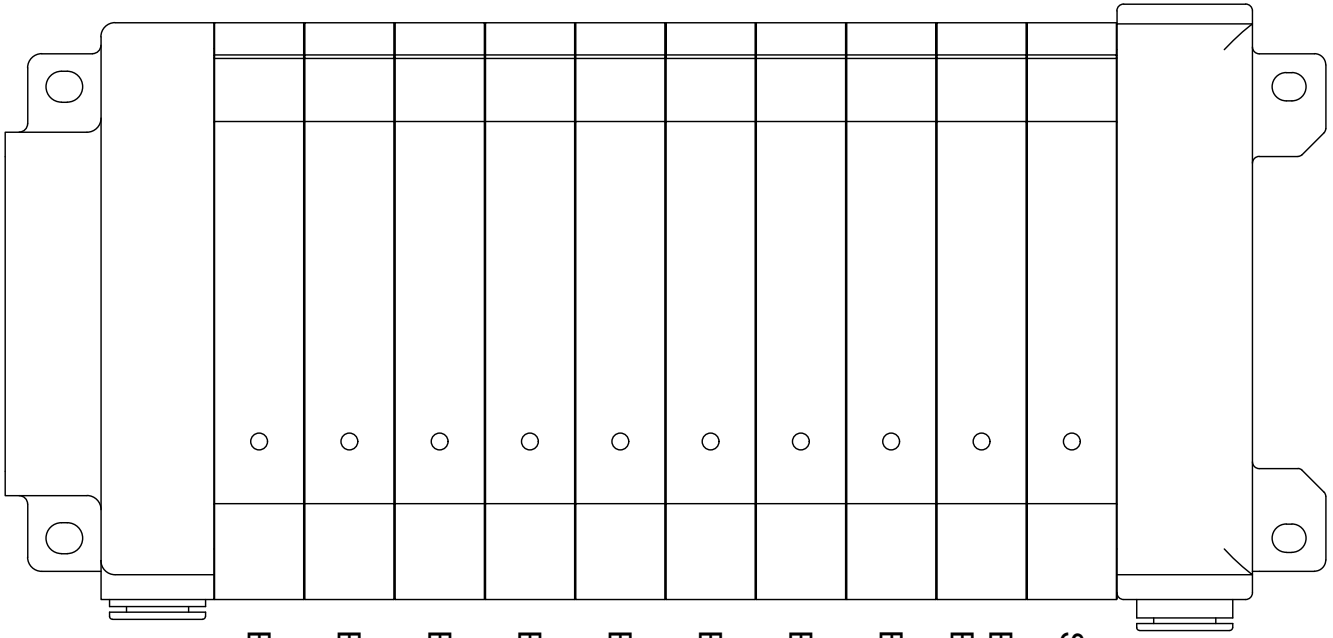

EV010 - PRODUCT INLET
EV011 - PRODUCT SHUTOFF
EV210 - VACUUM AFTER PUMP
EV211 - VACUUM IN PUMP
EV212 - VACUUM BEFORE PUMP
EV220 - CAP DISTRIBUTOR AIR
EV221 - CAP CHANNEL AIR
BOTTLE WASH PNEUMATIC ENABLE
EV001 CLOSE INFEED GATE
EV001 - OPEN INFEED GATE
SPARE

REV	DATE	DWN	CHK	APP	REVISION
E					
D					
C					
B					
A	28/08/26	D.B.	C.W.	C.W.	REVISION ONE, AS BUILT

THIS DRAWING IS OWNED BY FBS SOLUTIONS FOOD AND BEVERAGES AND IS ISSUED ON THE UNDERSTANDING THAT IT MAY NOT BE COPIED OR REPRODUCED IN WHOLE OR IN PART WITHOUT WRITTEN PERMISSION. NOR IS INFORMATION TO BE FURNISHED FROM WHICH COULD BE INJURIOUS TO THE ABOVE COMPANY

SCALE: NOT TO SCALE

	NAME	DATE
DRAWN	D. BORG	28/08/26
DESIGN	D. BORG	28/08/26
CHECKED	C. WHITELEY	28/08/26
APPROVED	C. WHITELEY	28/08/26

PROJECT: SCHLENKER 36/10

Serial No.: FBS Global Serial: 130039

FBS Solutions
45 Pelmet Cres, Thomastown VIC., Australia 3074
FOOD & BEVERAGE
Phone: +61 3 9191 2956
Contact: CLINT WHITELEY
Mobile: +61 418 383 441
E: enquiries@fbsglobal.com.au

DWG. NO.: 8001 A3


REVISION ONE, AS BUILT

SHEET TITLE: FIELD SOLENOIDS

REVISION A

SHEET 46

IO-Link CompactLine module AL2330

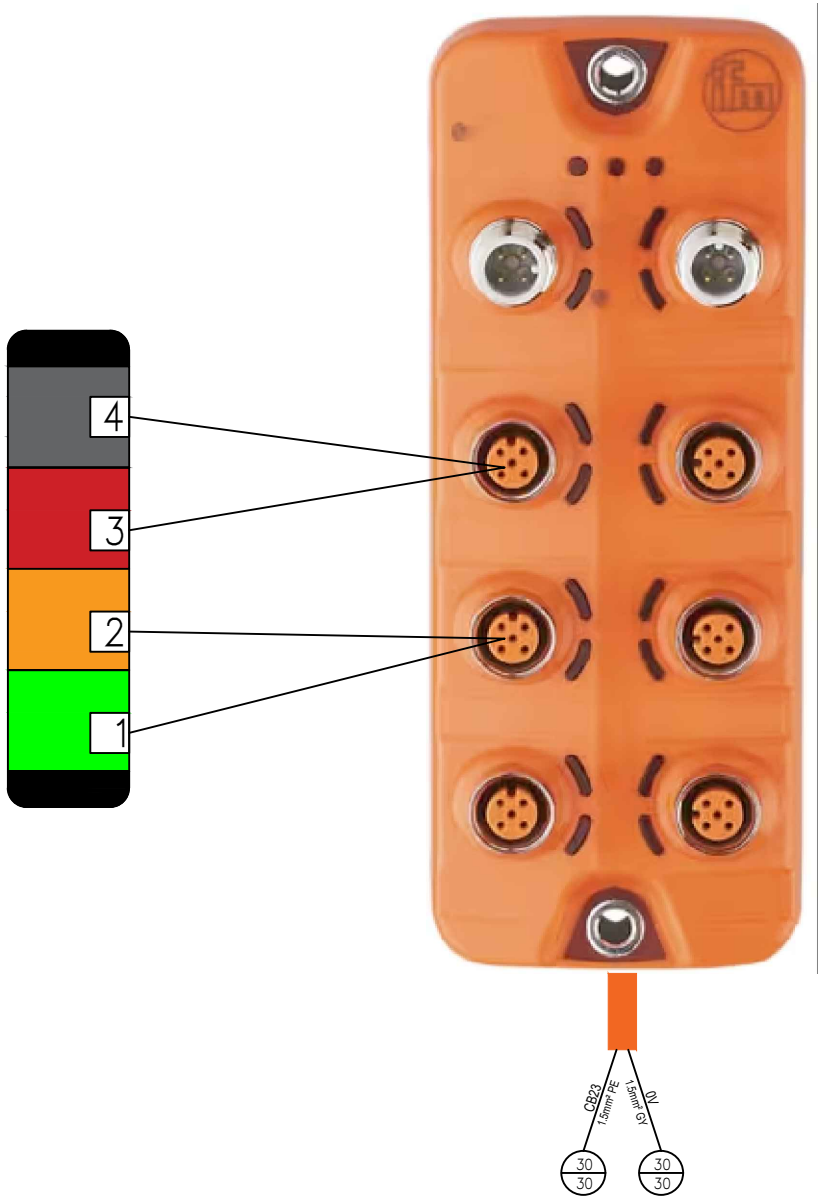

M12 Port & Pinout Wiring Structure

- Outputs (Ports X1.0 to X1.5 - M12, A-coded, 4-pin):
  - Pin 1: Not used
  - Pin 2: Digital Output 2 (DO2)
  - Pin 3: Ground (GND / UA)
  - Pin 4: Digital Output 1 (DO1)
  - Pin 5: Not used

REV	DATE	DWN	CHK	APP	REVISION
E					
D					
C					
B					
A	28/08/26	D.B.	C.W.	C.W.	REVISION ONE, AS BUILT

THIS DRAWING IS OWNED BY FBS SOLUTIONS FOOD AND BEVERAGES AND IS ISSUED ON THE UNDERSTANDING THAT IT MAY NOT BE COPIED OR REPRODUCED IN WHOLE OR IN PART WITHOUT WRITTEN PERMISSION. NOR IS INFORMATION TO BE FURNISHED FROM WHICH COULD BE INJURIOUS TO THE ABOVE COMPANY

SCALE: NOT TO SCALE

	NAME	DATE
DRAWN	D. BORG	28/08/26
DESIGN	D. BORG	28/08/26
CHECKED	C. WHITELEY	28/08/26
APPROVED	C. WHITELEY	28/08/26

PROJECT: SCHLENKER 36/10

Serial No.: FBS Global Serial: 130039

FBS Solutions
45 Pelmet Cres, Thomastown VIC., Australia 3074
FOOD & BEVERAGE
Phone: +61 3 9191 2956
Contact: CLINT WHITELEY
Mobile: +61 418 383 441
E: enquiries@fbsglobal.com.au

DWG. NO.: 8001 A3

REVISION ONE, AS BUILT

SHEET TITLE: FIELD COMPONENTS

REVISION A

SHEET 47